


"AS-BUILT SURVEY OF SUNSET CONDOMINIUMS AT NORTHERN BAY AND BOUNDARY SURVEY OF NORTHERN BAY GOLF COURSE - ALL IN THE TOWN OF STRONGS PRAIRIE, ADAMS COUNTY, WISCONSIN"

NUMBER	DIRECTION	DISTANCE	NUMBER	DIRECTION	DISTANCE
L1	N 86°45'16" W	203.33'	L35	N 87°41'28" W	82.13'
L2	N 00°01'00" W	261.87'	L36	N 00°01'09" W	516.07'
L3	N 86°57'15" W	263.46'	L37	N 87°52'44" W	261.75'
L4	N 07°05'10" W	118.66'	L38	N 87°24'00" W	594.98'
L5	S 86°33'42" W	367.2'	L39	N 87°26'58" E	445.52'
L6	N 82°54'14" W	47.52'	L40	N 87°26'58" E	165.20'
L7	N 89°56'22" W	64.27'	L41	S 87°26'58" E	616.53'
L8	N 20°41'26" W	98.40'	L42	S 00°01'09" W	262.45'
L9	N 89°26'17" E	640.58'	L43	S 08°47'38" W	144.34'
L10	S 82°30'07" E	248.57'	L44	S 21°41'38" E	85.43'
L11	S 39°28'57" W	436.89'	L45	S 15°19'44" E	126.56'
L12	S 05°01'44" E	96.91'	L46	S 21°41'17" E	116.86'
L13	N 86°59'43" E	244.76'	L47	S 13°10'43" E	67.65'
L14	S 03°00'37" E	148.86'	L48	S 04°16'22" W	150.32'
L15	S 43°56'20" E	106.86'	L49	N 88°58'49" E	176.03'
L16	S 78°00'52" E	106.86'	L50	N 00°01'09" E	874.24'
L17	S 78°00'52" E	122.20'	L51	S 60°13'51" E	162.54'
L18	S 87°12'56" E	208.21'	L52	S 54°12'04" E	160.79'
L19	S 87°24'07" E	136.82'	L53	N 67°17'54" E	220.39'
L20	S 64°25'33" E	113.22'	L54	N 08°38'32" E	171.95'
L21	S 87°41'28" E	111.45'	L55	S 88°24'32" E	167.44'
L22	S 86°58'51" E	181.17'	L56	S 08°47'38" W	24.54'
L23	S 00°01'00" E	163.33'	L57	S 08°47'38" W	24.54'
L24	S 86°58'51" W	300.87'			
L25	S 82°23'52" W	308.27'			
L26	S 82°03'18" W	288.45'			
L27	N 79°01'56" W	165.55'			
L28	S 72°06'54" W	92.719'			
L29	S 49°35'31" W	73.433'			
L30	S 72°12'06" W	92.86'			
L31	S 00°05'27" E	102.67'			
L32	S 00°05'27" E	126.41'			
L33	S 00°05'27" E	174.85'			

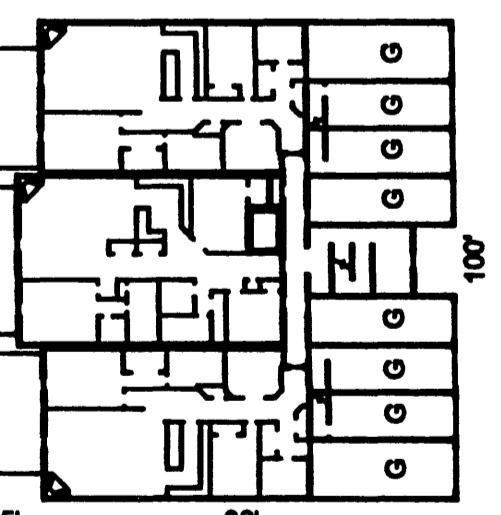


FIRST AMENDMENT TO AND RESTATEMENT 17 OF THE CONDOMINIUM PLAT FOR SUNSET CONDOMINIUMS AT NORTHERN BAY, PHASE 2 FILE 1 OF CONDOS, ENVELOPE 58 DOC. NO. 438862


AS-BUILT SURVEY SUNSET CONDOMINIUMS, PHASE 1 AND PHASE 2 AT NORTHERN BAY 1841 20TH AVENUE, ARKDALE, WI. 54613

PROJECT NO.	11397000	F.A.		NO.	DATE	REVISION	BY
DATE	6-3-08	DRAWN BY	MTS				
SCALE	AS SHOWN	CHECKED BY	GPR				


MSA TRANSPORTATION • MUNICIPAL DEVELOPMENT • ENVIRONMENTAL
 1230 South Boulevard, Baraboo, WI 53913
 608-356-2771 • 1-800-362-4505 Fax: 608-356-2770
 Web Address: www.msa-wi.com
 © MSA PROFESSIONAL SERVICES

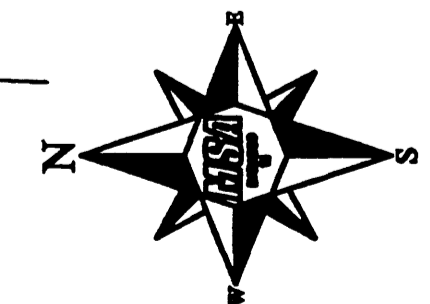

- LEGEND**
- FD. GOVERNMENT MONUMENT
 - FOUND 1-1/4" REBAR
 - FOUND 3/4" IRON REBAR
 - SET 3/4" BY 18" SOLID ROD-1.50 LBS./FT.
 - WELL, FIELD VERIFY
 - C = CONCRETE
 - B = BITUMINOUS
 - G = GARAGE

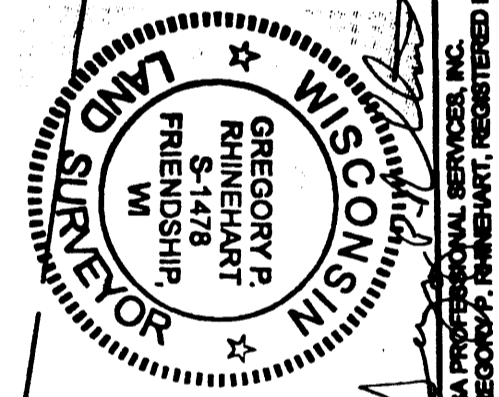

NOTE: IF THE SURVEYOR'S SEAL IS NOT RED IN COLOR, THE SURVEY IS A COPY AND SHOULD BE ADMISED TO CONTAIN UNAUTHORIZED ALTERATIONS. THE CERTIFICATION CONTAINED ON THIS DOCUMENT SHALL APPLY TO COPIES.

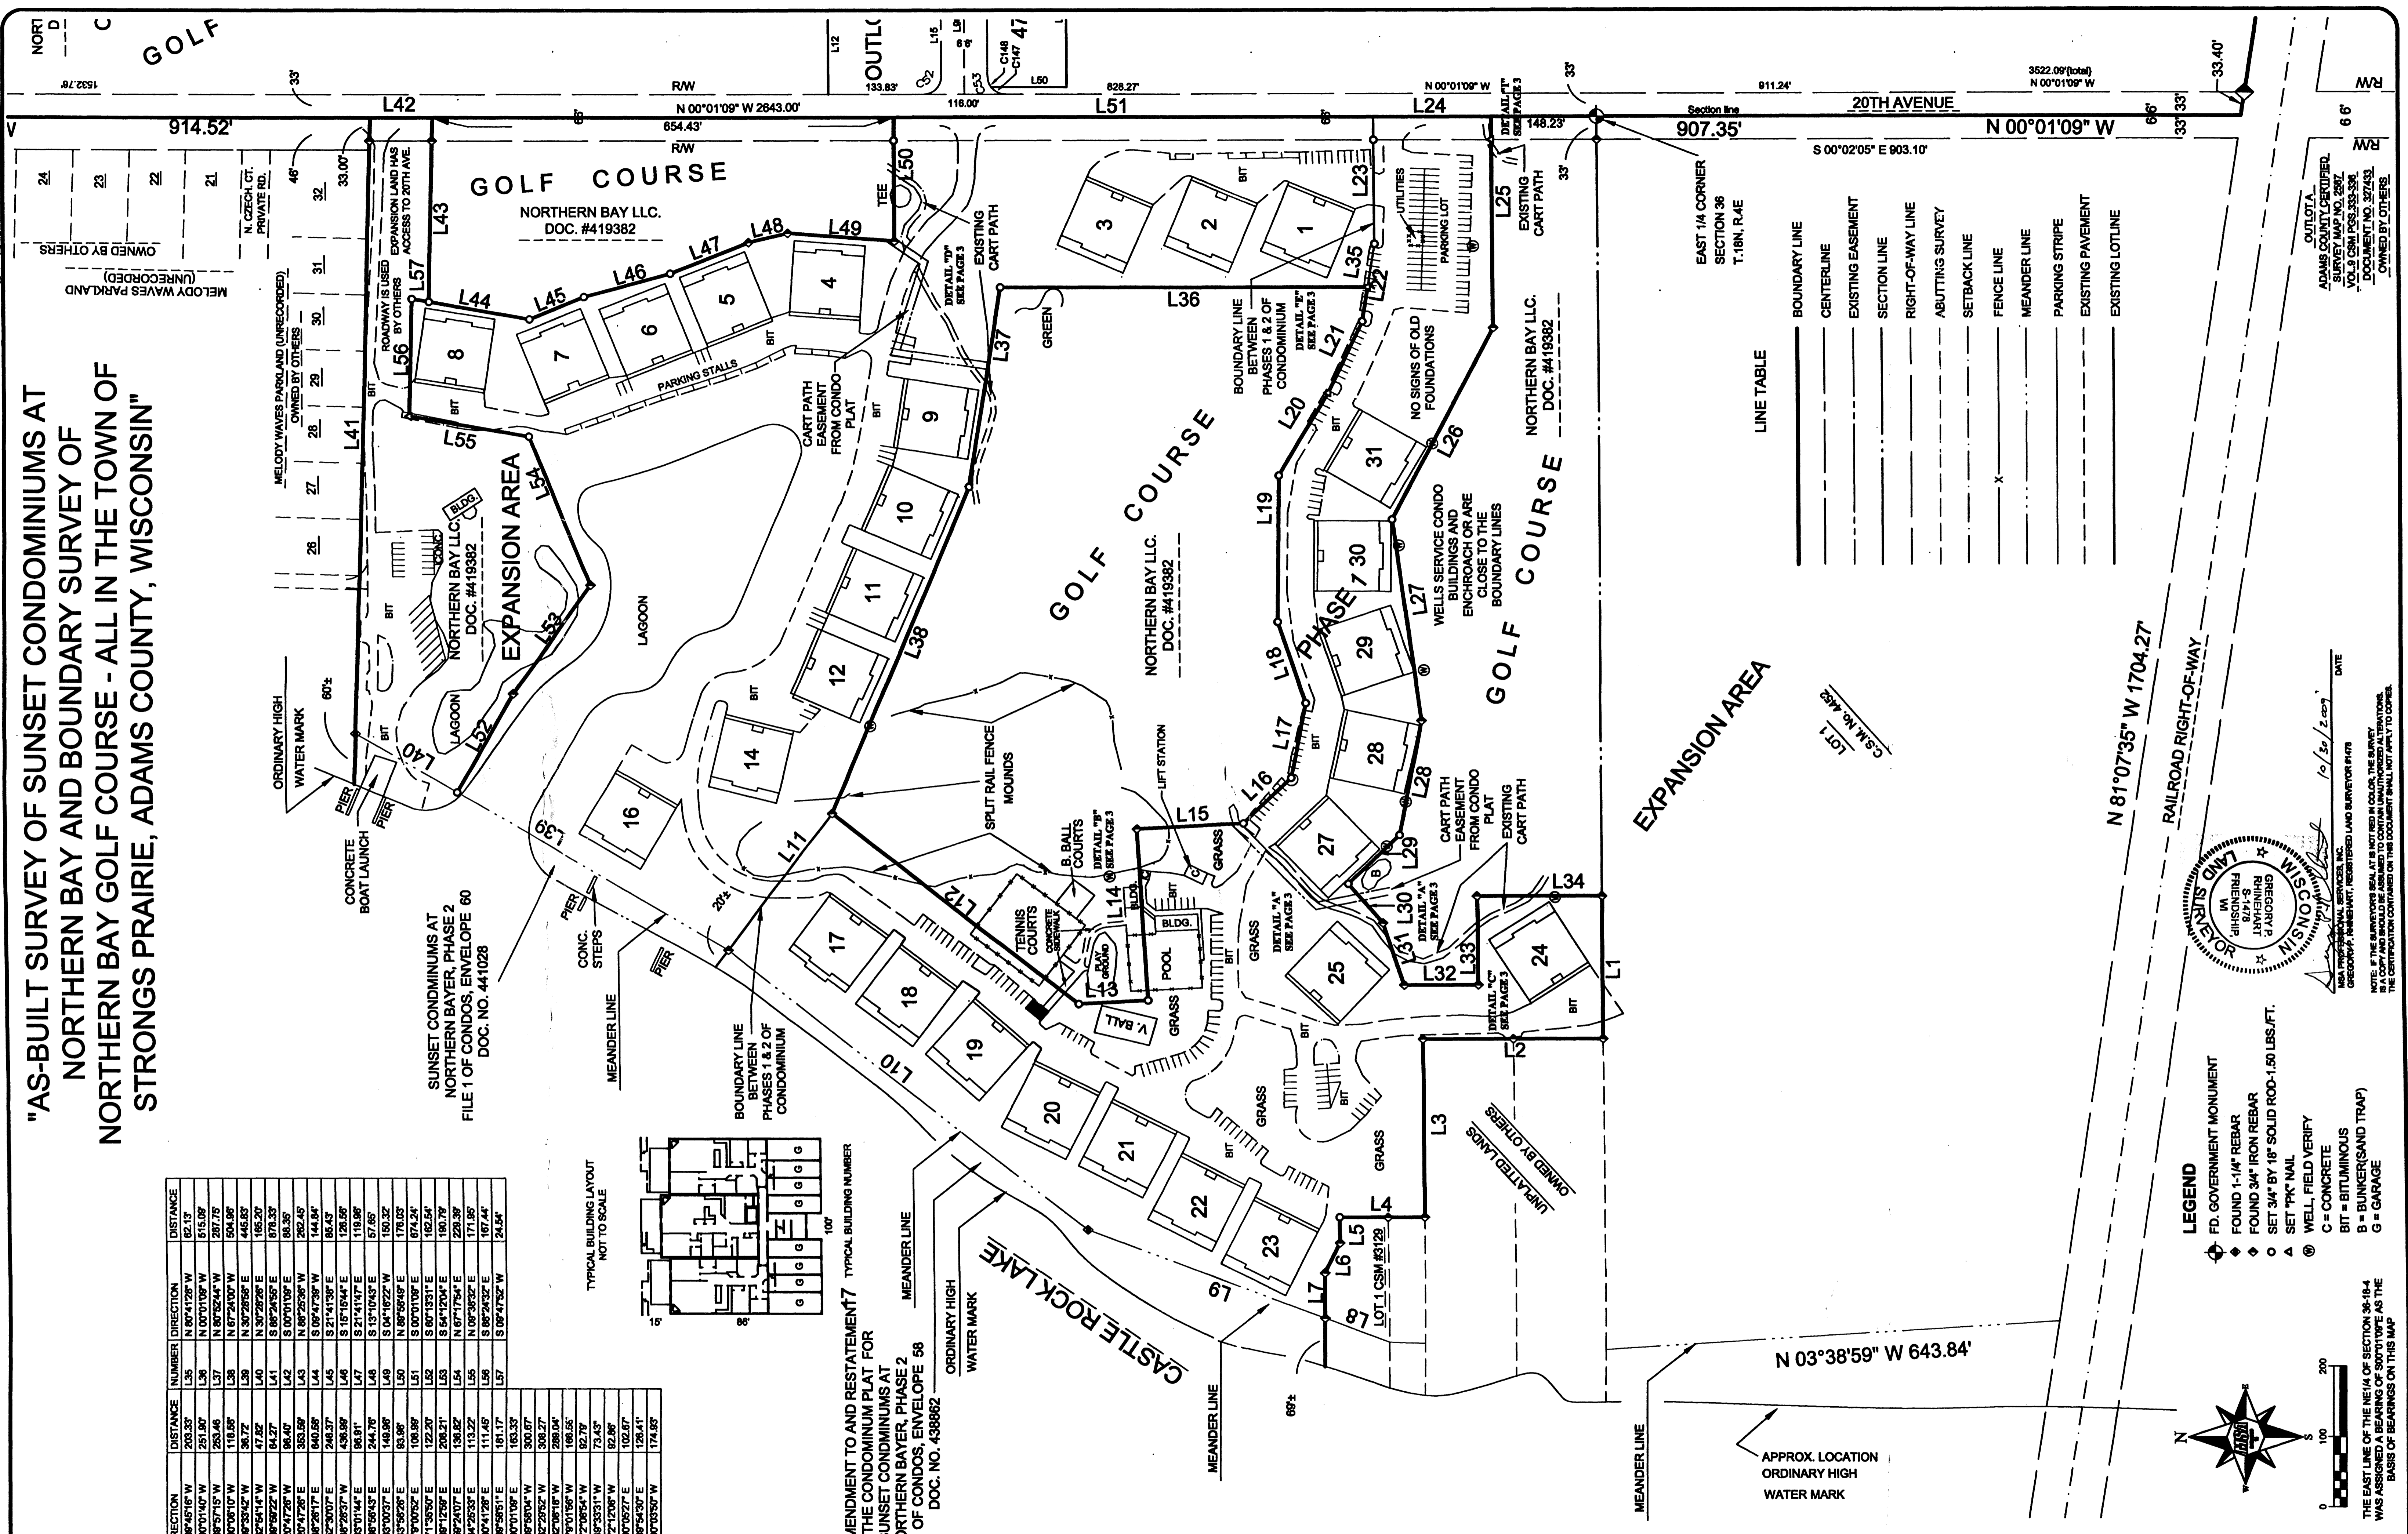


LINE TABLE

BOUNDARY LINE	---
CENTERLINE	---
EXISTING EASEMENT	---
SECTION LINE	---
RIGHT-OF-WAY LINE	---
ABUTTING SURVEY	---
SETBACK LINE	---
FENCE LINE	---
MEANDER LINE	---
PARKING STRIPE	---
EXISTING PAVEMENT	---
EXISTING LOTLINE	---

ADAMS COUNTY CERTIFIED SURVEY MAP NO. 286Z VOL. 3 CSM PGS. 353-358 DOCUMENT NO. 307453 OWNED BY OTHERS

POS 36 18041100 2

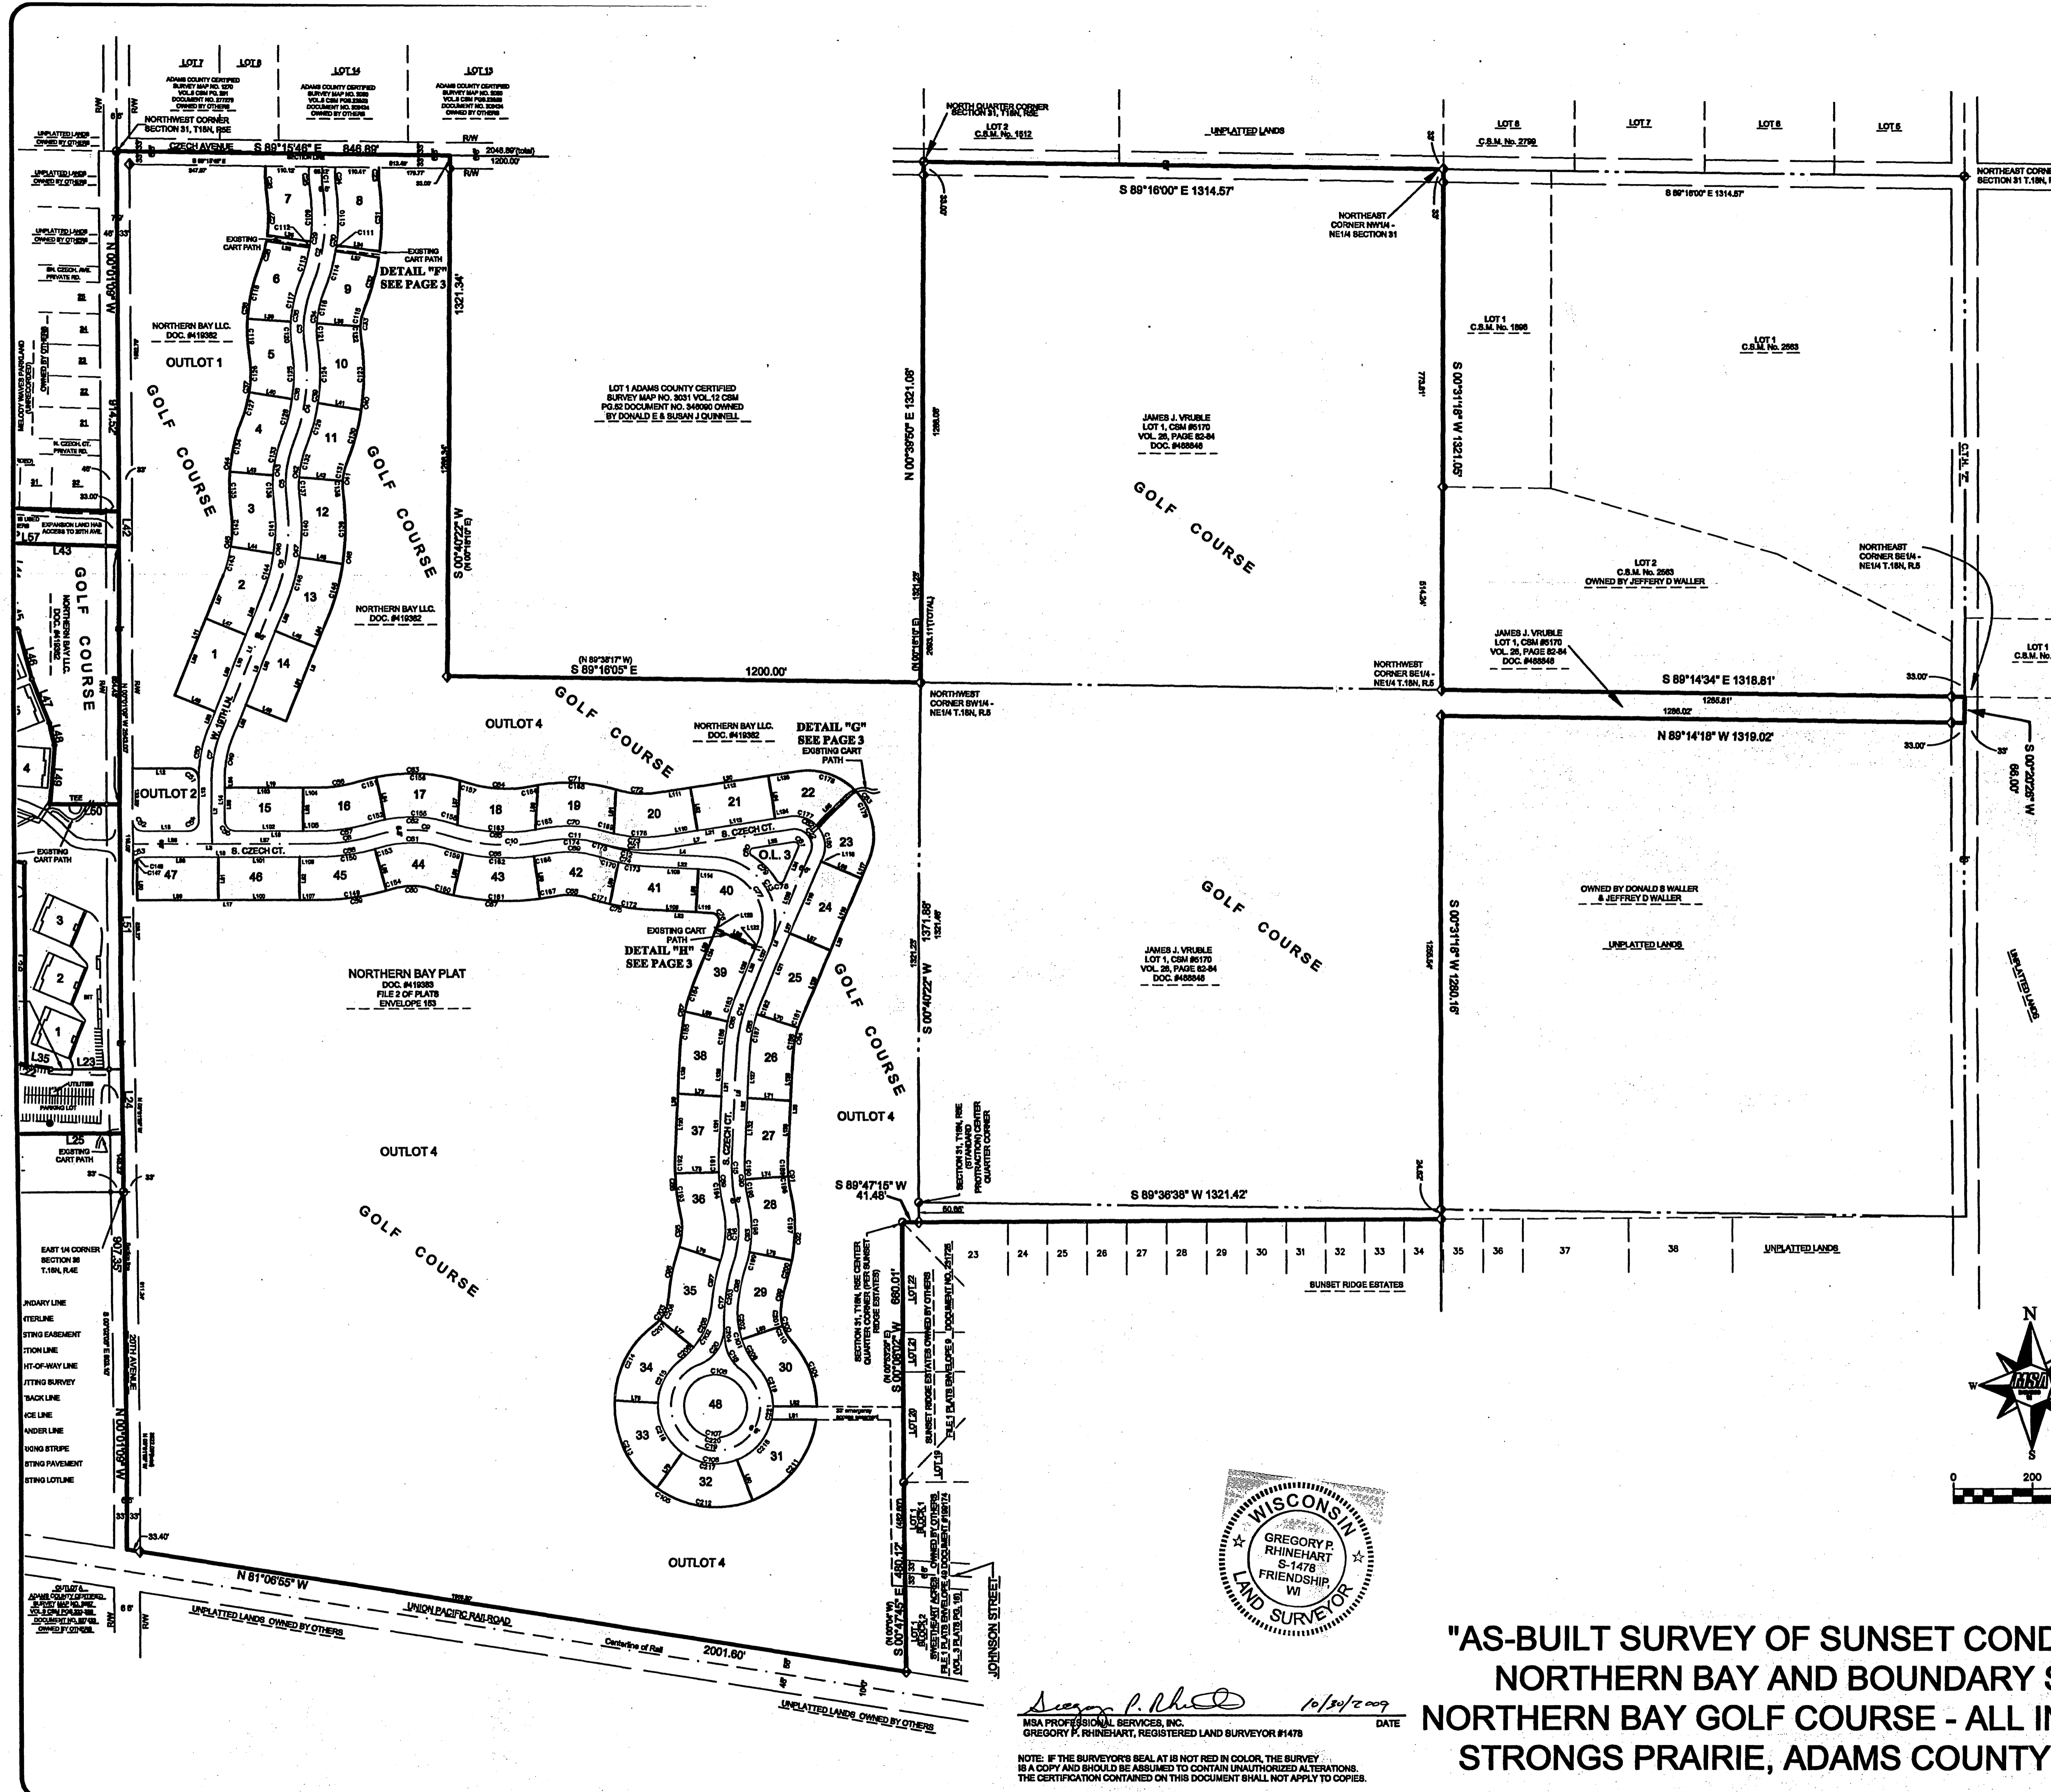

Lot No.	Area (sq. ft.)	Area (sq. m.)	Perimeter (ft.)	Perimeter (m.)
1	10,000	914.4	1,000	304.8
2	12,000	1,107.0	1,100	335.3
3	15,000	1,393.5	1,200	365.8
4	18,000	1,680.0	1,300	396.3
5	20,000	1,851.9	1,400	426.8
6	22,000	2,023.8	1,500	457.3
7	25,000	2,310.3	1,600	487.8
8	28,000	2,596.8	1,700	518.3
9	30,000	2,768.7	1,800	548.8
10	32,000	2,940.6	1,900	579.3
11	35,000	3,227.1	2,000	609.8
12	38,000	3,513.6	2,100	640.3
13	40,000	3,685.5	2,200	670.8
14	42,000	3,857.4	2,300	701.3
15	45,000	4,143.9	2,400	731.8
16	48,000	4,430.4	2,500	762.3
17	50,000	4,602.3	2,600	792.8
18	52,000	4,774.2	2,700	823.3
19	55,000	5,060.7	2,800	853.8
20	58,000	5,347.2	2,900	884.3
21	60,000	5,519.1	3,000	914.8
22	62,000	5,691.0	3,100	945.3
23	65,000	5,977.5	3,200	975.8
24	68,000	6,264.0	3,300	1,006.3
25	70,000	6,435.9	3,400	1,036.8
26	72,000	6,607.8	3,500	1,067.3
27	75,000	6,894.3	3,600	1,097.8
28	78,000	7,180.8	3,700	1,128.3
29	80,000	7,352.7	3,800	1,158.8
30	82,000	7,524.6	3,900	1,189.3
31	85,000	7,811.1	4,000	1,219.8
32	88,000	8,097.6	4,100	1,250.3
33	90,000	8,269.5	4,200	1,280.8
34	92,000	8,441.4	4,300	1,311.3
35	95,000	8,727.9	4,400	1,341.8
36	98,000	9,014.4	4,500	1,372.3
37	100,000	9,186.3	4,600	1,402.8
38	102,000	9,358.2	4,700	1,433.3
39	105,000	9,644.7	4,800	1,463.8
40	108,000	9,931.2	4,900	1,494.3
41	110,000	10,103.1	5,000	1,524.8
42	112,000	10,275.0	5,100	1,555.3
43	115,000	10,561.5	5,200	1,585.8
44	118,000	10,848.0	5,300	1,616.3
45	120,000	11,020.0	5,400	1,646.8
46	122,000	11,192.0	5,500	1,677.3
47	125,000	11,478.5	5,600	1,707.8
48	128,000	11,765.0	5,700	1,738.3



Gregory P. Rhinehart 10/24/2009
MSA PROFESSIONAL SERVICES, INC.
GREGORY P. RHINEHART, REGISTERED LAND SURVEYOR #1478 DATE

NOTE: IF THE SURVEYOR'S SEAL AT IS NOT RED IN COLOR, THE SURVEY IS A COPY AND SHOULD BE ASSUMED TO CONTAIN UNAUTHORIZED ALTERATIONS. THE CERTIFICATION CONTAINED ON THIS DOCUMENT SHALL NOT APPLY TO COPIES.

"AS-BUILT SURVEY OF SUNSET CONDOMINIUMS AT NORTHERN BAY AND BOUNDARY SURVEY OF NORTHERN BAY GOLF COURSE - ALL IN THE TOWN OF STRONGS PRAIRIE, ADAMS COUNTY, WISCONSIN"

- LEGEND**
- FD. GOVERNMENT MONUMENT
 - FOUND 2" IRON PIPE
 - ◆ FOUND 1-1/4" REBAR
 - ◇ FOUND 3/4" IRON REBAR
 - ◇ SET 3/4" BY 18" SOLID ROD-1.50 LBS./FT.
 - ▲ SET "PK" NAIL
 - ◎ WELL, FIELD VERIFY

MSA
TRANSPORTATION • MUNICIPAL DEVELOPMENT • ENVIRONMENTAL
1230 South Boulevard, Baraboo, WI 53913
608-556-7770 FAX 608-556-7770
© MSA PROFESSIONAL SERVICES


AS-BUILT SURVEY
SUNSET CONDOMINIUMS, PHASE 1 AND PHASE 2 AT NORTHERN BAY
1841 20TH AVENUE, ARKDALE, WI 54613

PROJECT NO.: 11387000
DATE: 5-21-09
SCALE: AS SHOWN


FILE NO.:
SHEET 2 OF 3

"AS-BUILT SURVEY OF SUNSET CONDOMINIUMS AT
NORTHERN BAY AND BOUNDARY SURVEY OF
NORTHERN BAY GOLF COURSE - ALL IN THE TOWN OF
STRONGS PRAIRIE, ADAMS COUNTY, WISCONSIN"


DETAIL "A"
NOT TO SCALE

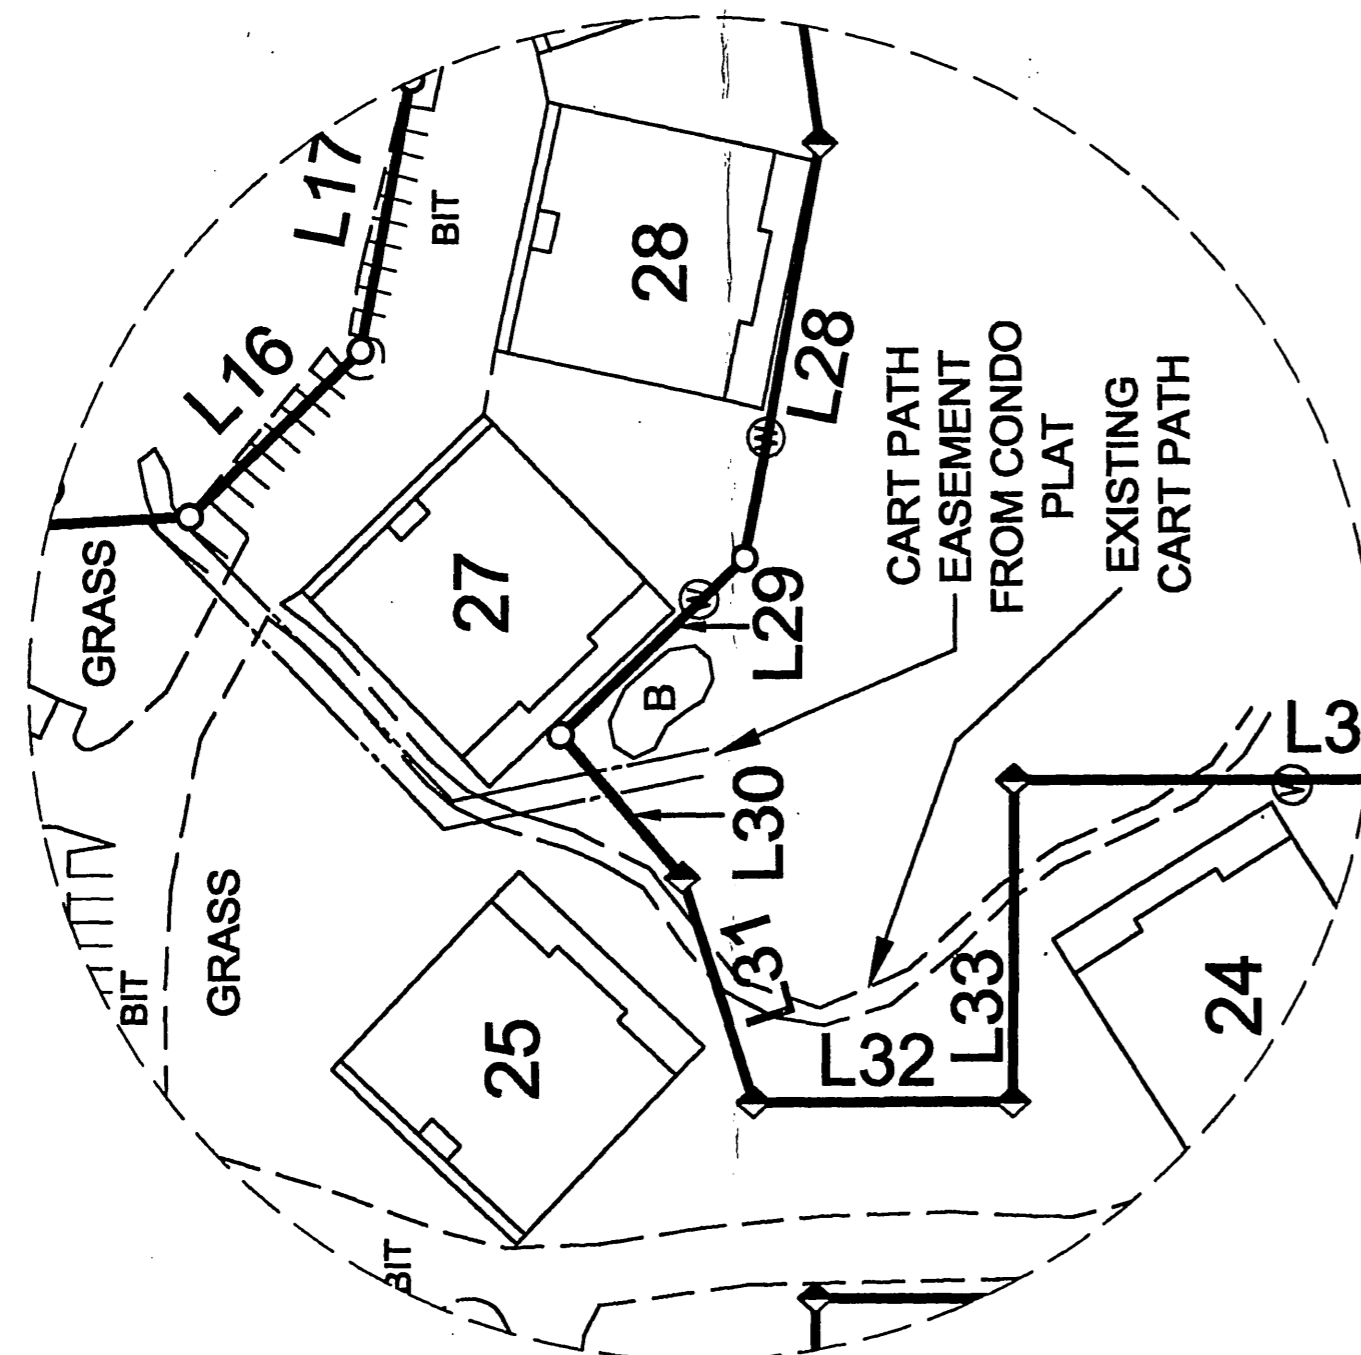


DETAIL "B"
NOT TO SCALE

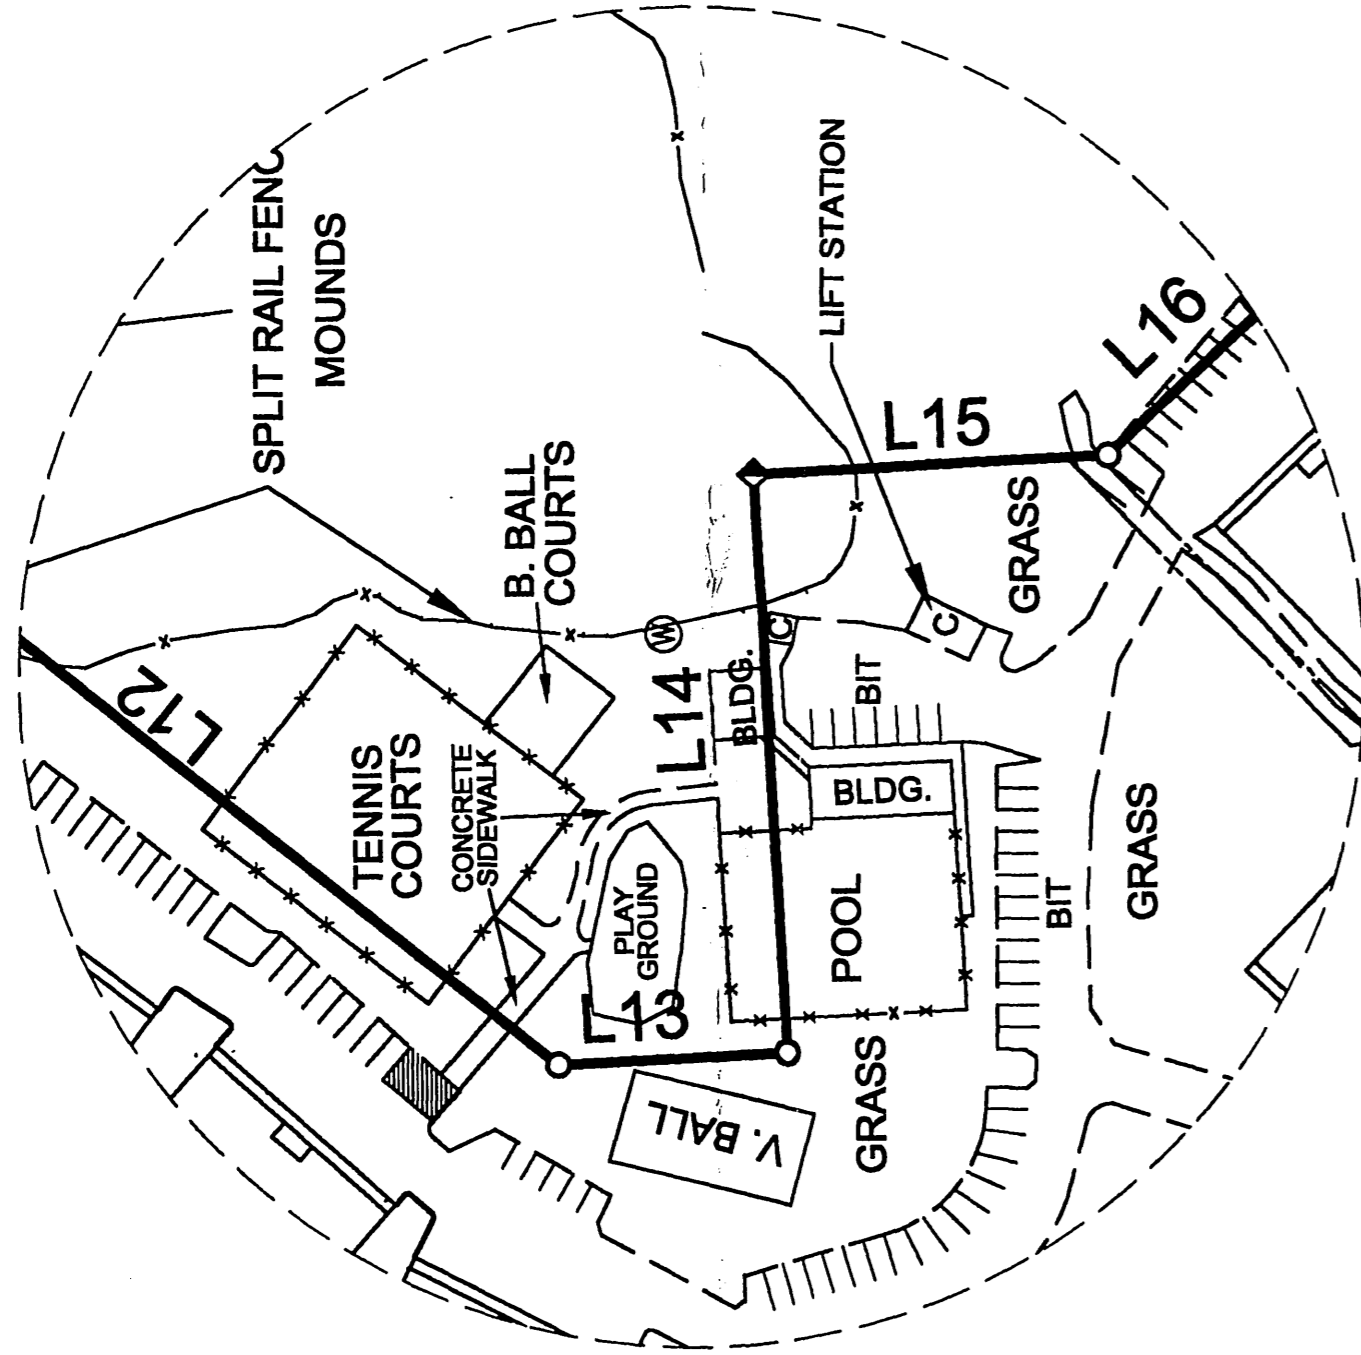


DETAIL "C"
NOT TO SCALE

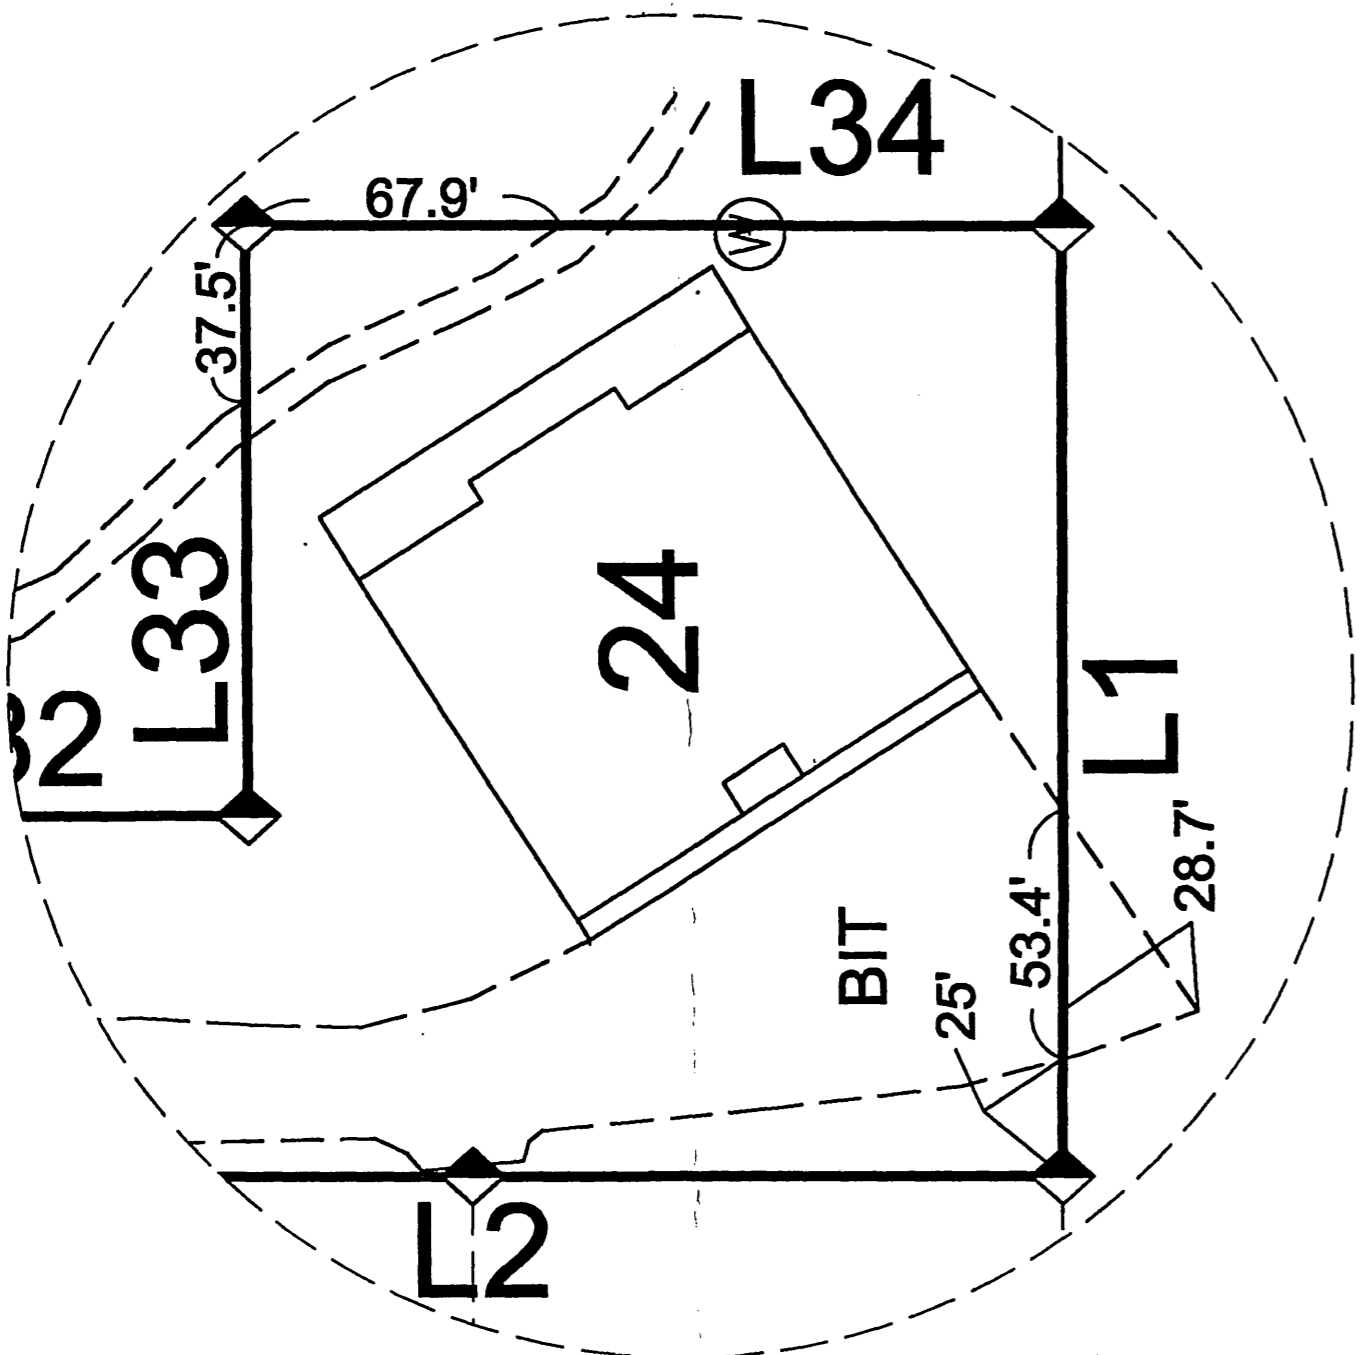


DETAIL "D"
NOT TO SCALE

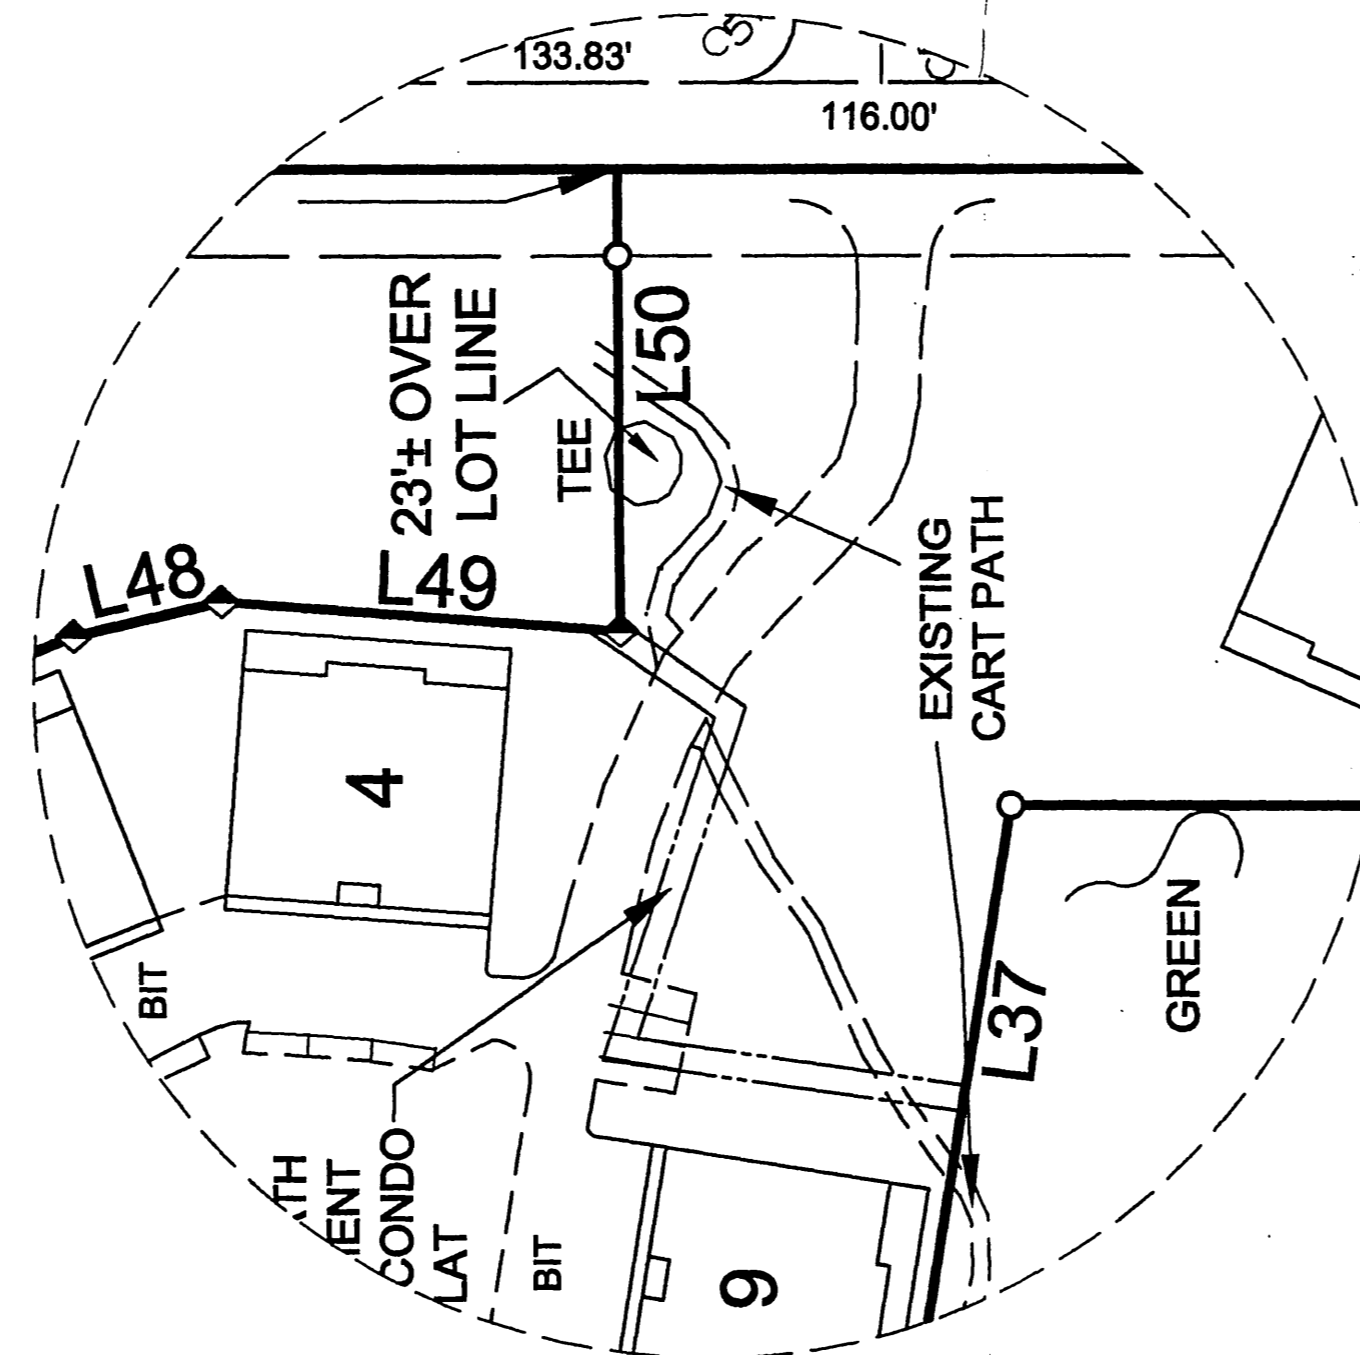


DETAIL "E"
NOT TO SCALE

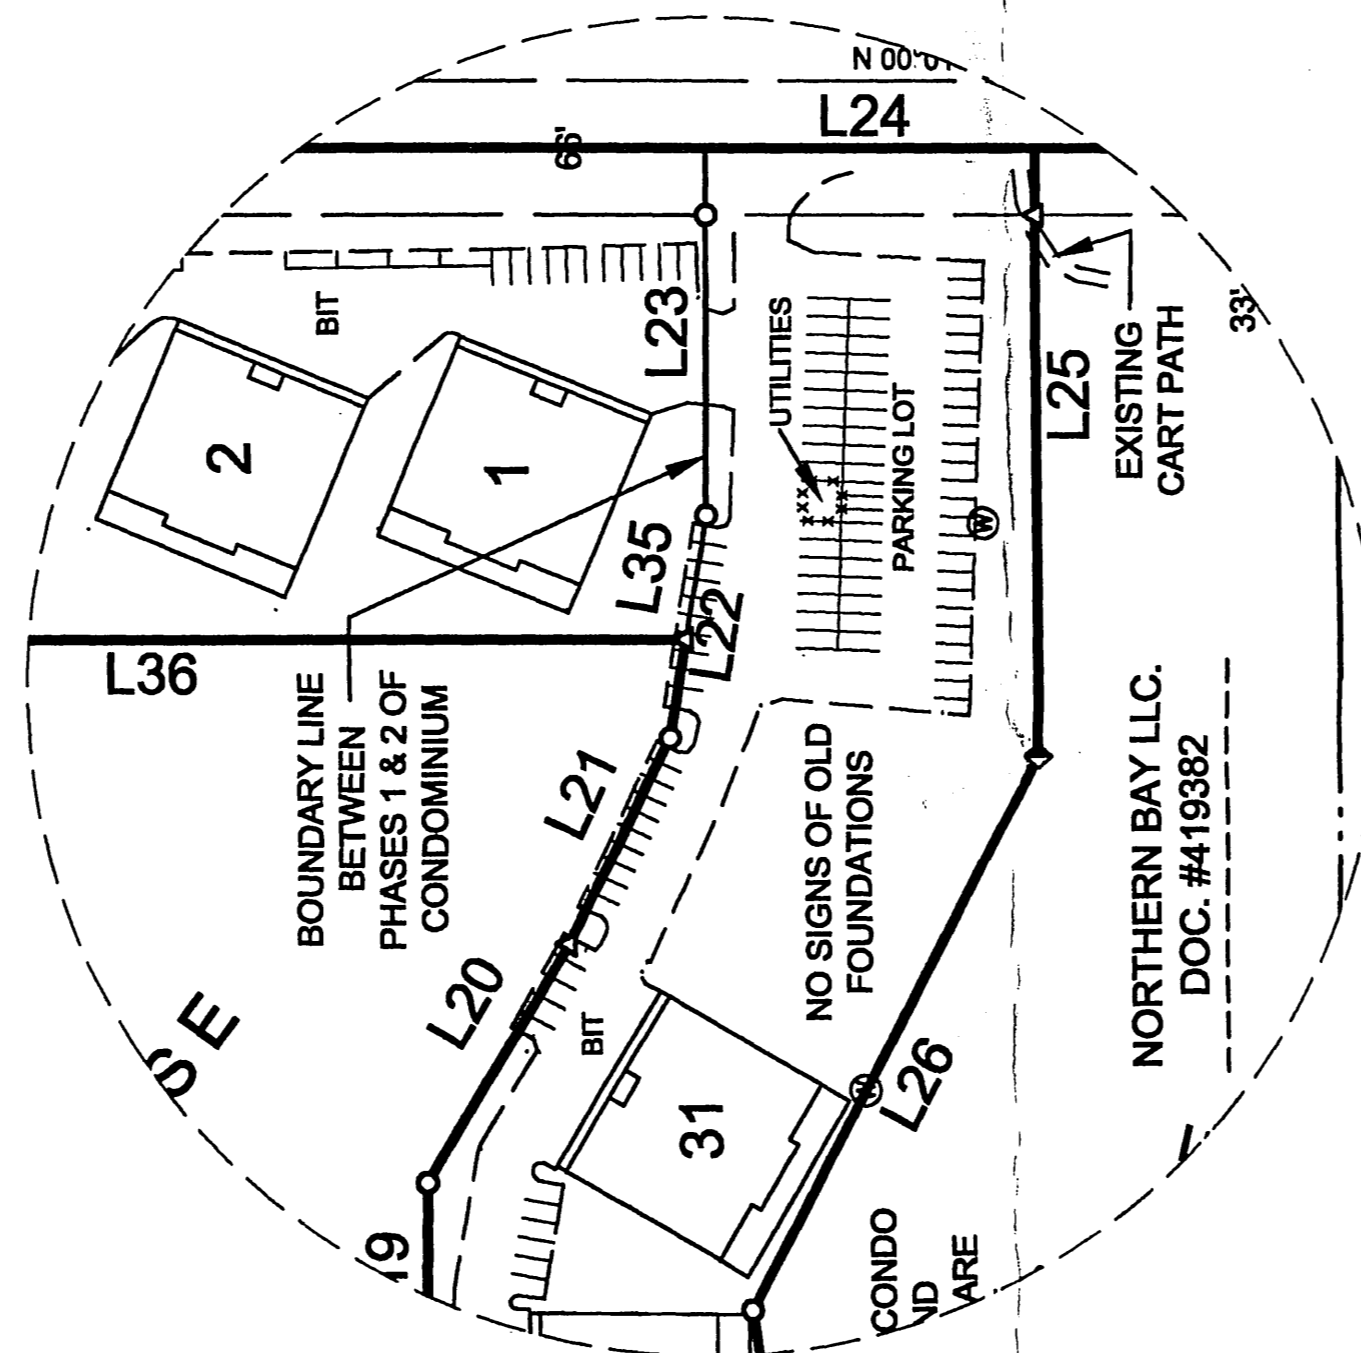


DETAIL "F"
NOT TO SCALE

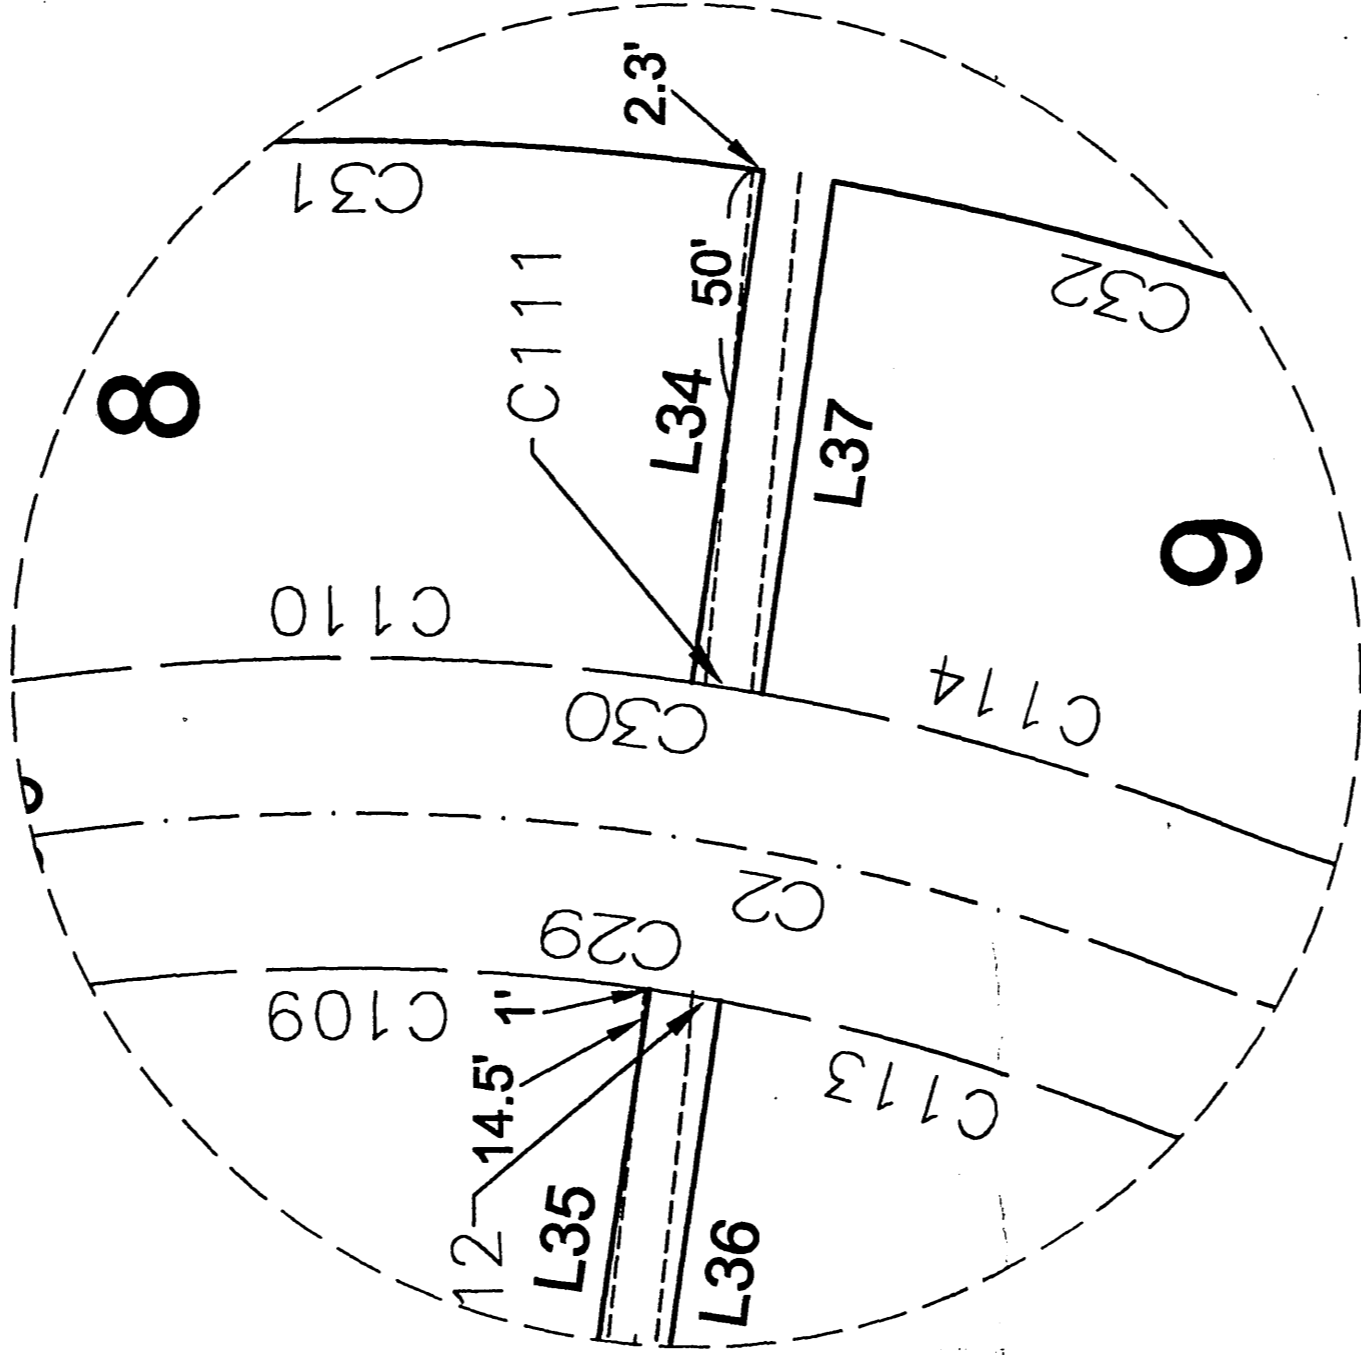


DETAIL "G"
NOT TO SCALE

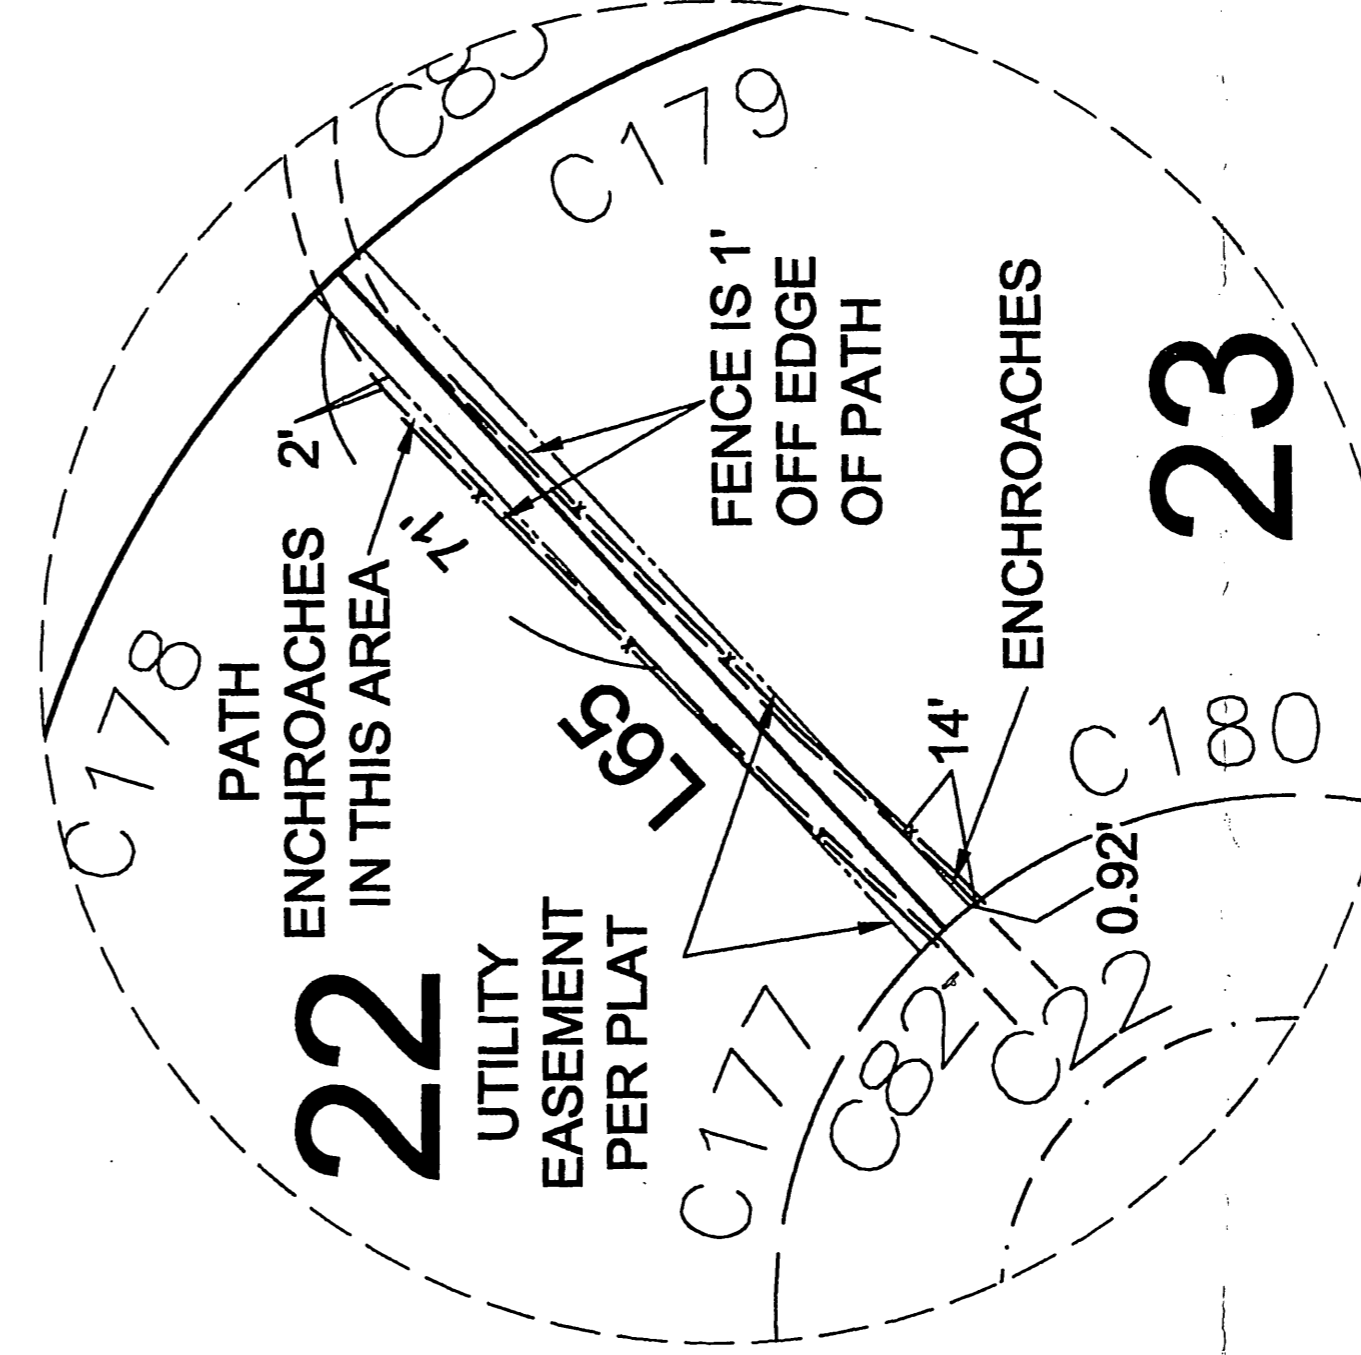

DETAIL "H"
NOT TO SCALE

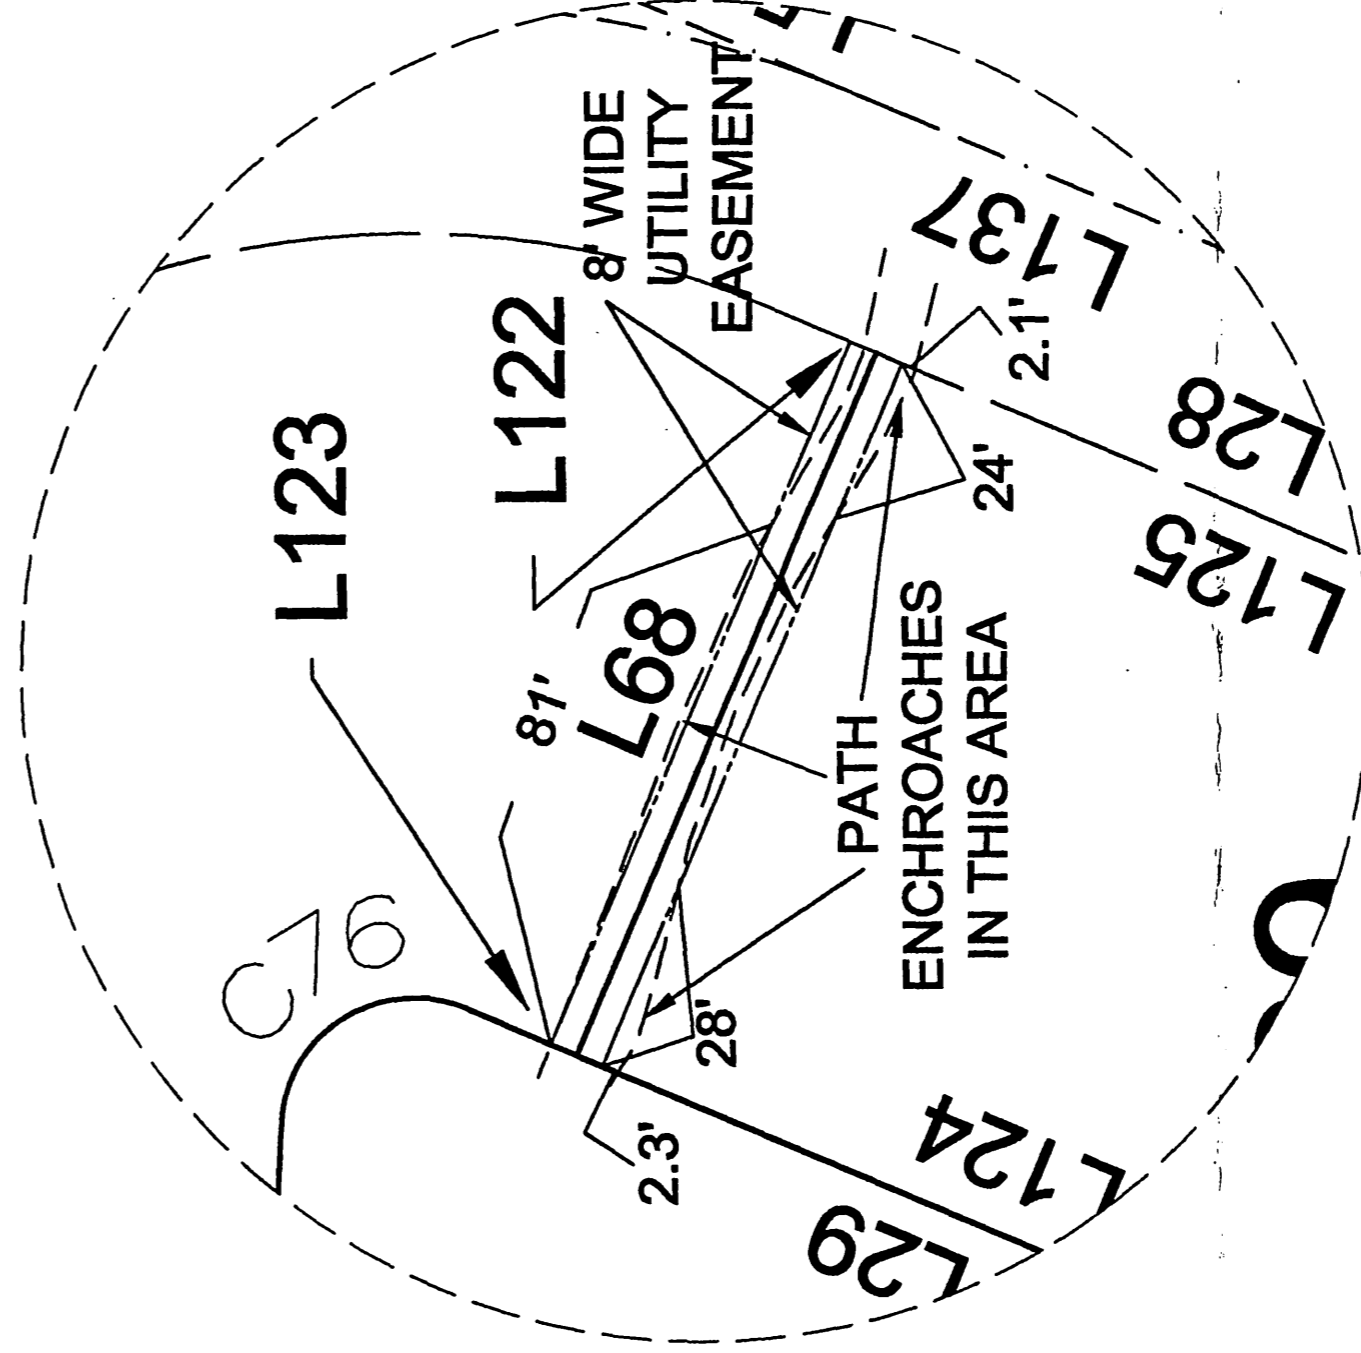

DETAIL "I"
NOT TO SCALE

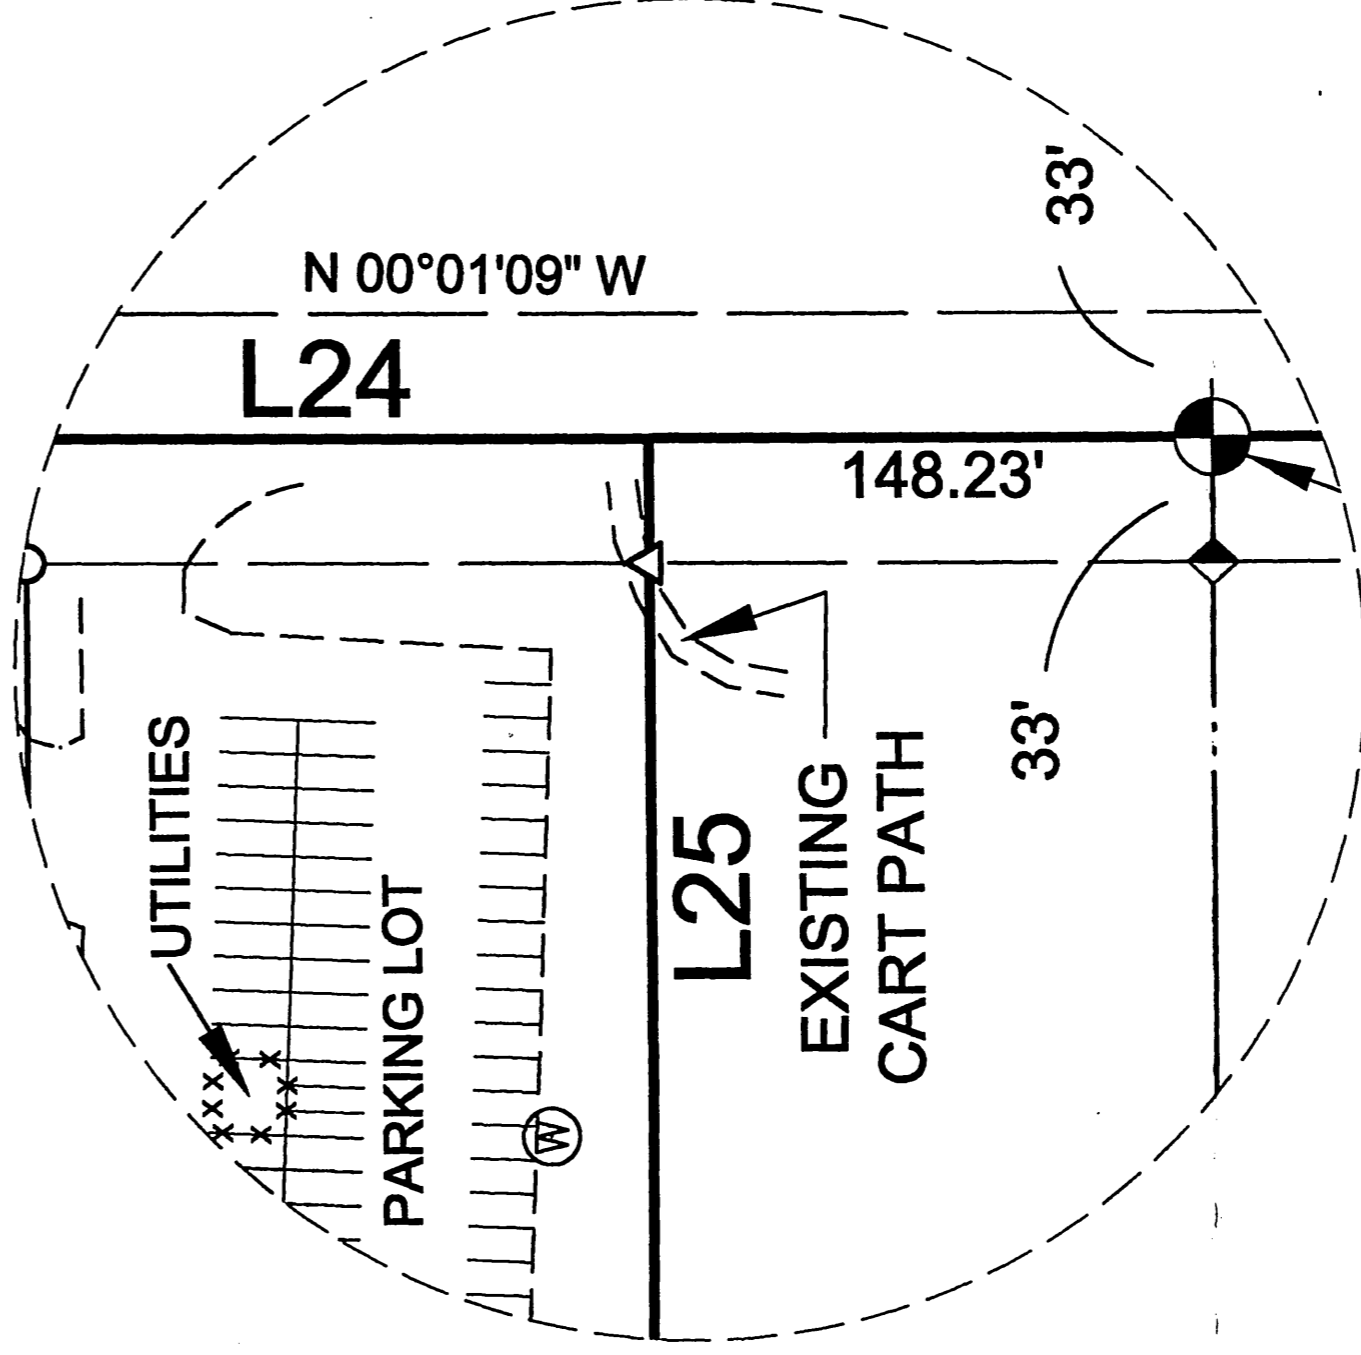

AS-BUILT SURVEY
SUNSET CONDOMINIUMS, PHASE 1 AND
PHASE 2 AT NORTHERN BAY
1841 20TH AVENUE, ARKDALE, WI. 54613

PROJECT NO:	11397000	F.B.I.:		NO.	DATE	REVISION	BY
PLAT DATE:	5-21-09	DRAWN BY:	MTS				
SCALE:	AS SHOWN	CHECKED BY:	GPR				

MSA
PROFESSIONAL SERVICES
TRANSPORTATION • MUNICIPAL
DEVELOPMENT • ENVIRONMENTAL
1230 South Boulevard • Baraboo, WI 53913
608-356-2771 1-800-362-4503 Fax: 608-356-2770
Web Address: www.msa-ps.com
MSA PROFESSIONAL SERVICES

DATE
10/30/09
REGISTERED LAND SURVEYOR #478
NOTE: IF THE SURVEYOR'S SEAL IS NOT RED IN COLOR, THE SURVEY
IS UNOFFICIAL AND THE CERTIFICATION CONTAINED IN THIS DOCUMENT SHALL NOT APPLY TO CORPES.