

32
SECTION

16
TOWN

06
RANGE

ADAMS COUNTY

COUNTY CORNER NO: 125
ROMPORTOL ID: 41606320000

PUBLIC LAND SURVEY MONUMENT RECORD


TYPE OF MONUMENT: HARRISON
ADAMS COUNTY COORDINATES, NAD 83 (2007)

N. 164675.063

E. 536588.224

ELEVATION- DATUM

FIELD WORK DATE: 11/14/2017

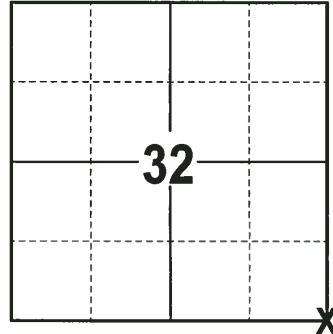

LOCATION
(INDICATE CORNER BY "X")

SEAL:




DATA SHOWN HERE ON THIS TIE SHEET IS CORRECT AND COMPLETE TO THE BEST OF MY KNOWLEDGE AND BELIEF.

PROFESSIONAL LAND SURVEYOR


DATE 12-4-17

- TIE SKETCH

NOTE: THE CORNER FALLS 8± EAST OF THE CENTERLINE OF 11TH AVE.

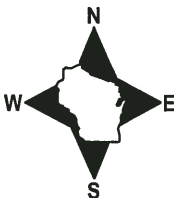

- 3/4" x 18" IRON REBAR SET, 1.50#/FT
- ⊕ HARRISON FOUND
- ⊙ WITNESS POWER POLE
- ┆ VINYL "T" POST
- ☼ WITNESS TREE FOUND

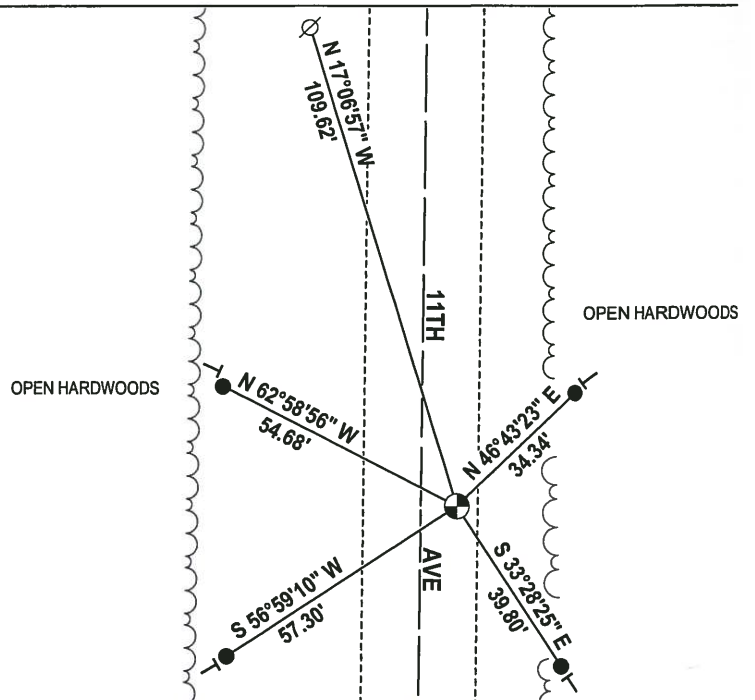

Government Land Corner Certificate

ADAMS

County

TYPE OF MONUMENT: STANDARD HARRISON

STATE PLANE COORDINATES: N _____

E _____


ELEVATION — M.S.L. DATUM: _____

THETA ANGLE: _____

FIELD BOOK: 567 PAGE 4

DRAWN BY: F. W. ZIETLOW

CORNER NO. 5
SECTION 4
TOWN 15N
RANGE 6E

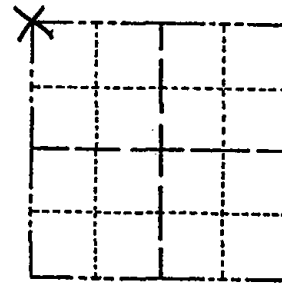


LOCATION
(Indicated by 'X')

BASIS FOR MONUMENT LOCATION

Show info such as: History of corner, with reference to Vol. and pg., dates, surveyor; exact description of monument replaced; if location computed, by taped or EDM traverse; landowner remarks, etc. (Use reverse side if necessary)

RESEARCHED ADAMS COUNTY SURVEY RECORDS AND COULD FIND NO RESURVEYS ON FILE WHICH WERE PERTINENT TO THIS CORNER. NO EVIDENCE OF ORIGINAL GOV'T CORNER OR WITNESS. FOUND A 1" IRON PIPE (ORIGIN UNKNOWN). RAN EXTENSIVE EDM TRAVERSE IN 4 DIRECTIONS & VERIFIED LOCATION. USED PIPE FOR CORNER AS BEST AVAILABLE EVIDENCE.

SEAL:

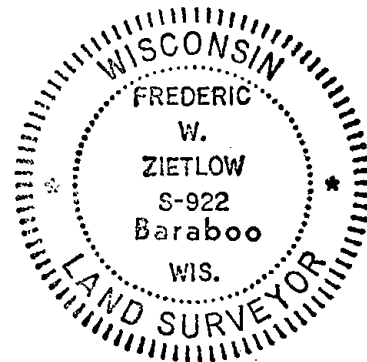


DATA SHOWN HERE ON CERTIFIED CORRECT:

Frederic W. Zietlow
Registered Land Surveyor

DATE: MARCH 28, 1978

TIE SKETCH

Show at least four ties, also fence lines, roads, topo, size and type of witness trees and if off road - best way to arrive at corner.

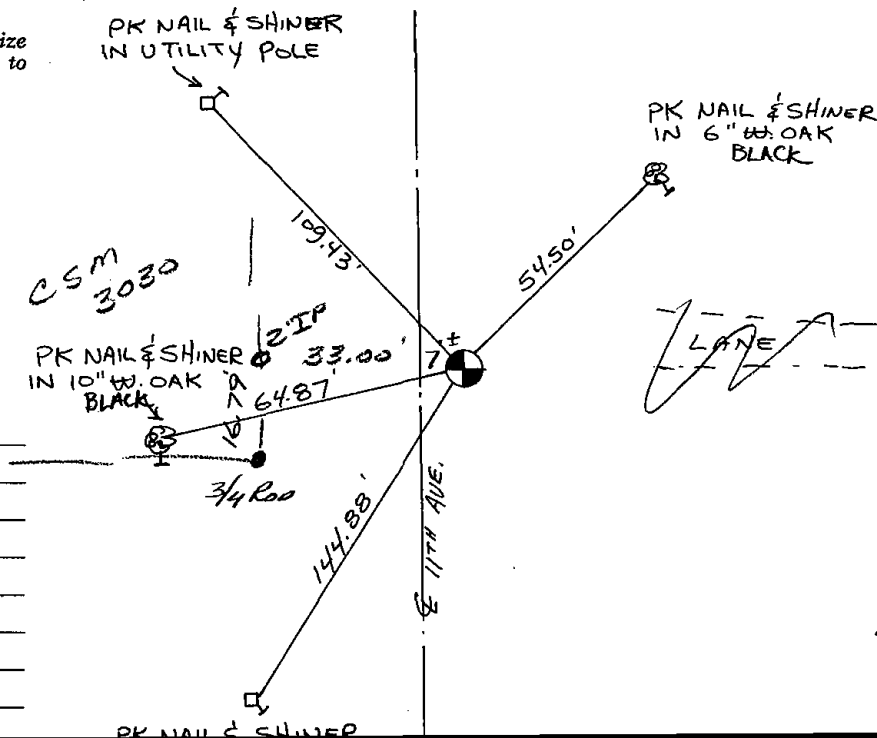

MAINTENANCE RECORD

Date	Init.	Remarks
1-17-86	GR	OK
1-10-91	KZJC	ALL OK
1-10-96	JG-SS	OK
1-25-01	JG	OK
3-06-06	SS	OK
1-24-11	SS	"