## OT ADAMS COUNTY COUNTY CORNER NO: 49

ROMPORTOL ID: 41407100000


## PUBLIC LAND SURVEY MONUMENT RECORD

**SURVEY NAIL** TYPE OF MONUMENT: ADAMS COUNTY COORDINATES, NAD 83 (2007) N. **121940.189** E. 578302.502 **ELEVATION-**DATUM 04/07/2020 FIELD WORK DATE:

## BASIS FOR MONUMENT LOCATION

1974 - PLS 922 RAN EDM TRAVERSE OF SECTION BY USING CENTERLINE OF ROADS AND EAST-WEST FENCE, THIS FIT GOOD FOR THE SECTION CORNER.

2020 - PLS 2675 FOUND SURVEY NAIL IN THE ROAD SURFACE AND 4 IRON RODS. REMOVED SURVEY NAIL AND FOUND NO EVIDENCE OF ADDITIONAL MONUMENTS BELOW. CORNER LOCATION WAS VERIFIED BY RECORDED DISTANCES ON SECTION 10 SECTION SUMMARY BY PLS 922 AND PLS 1274. ACCEPTED THE SURVEY NAIL AS THE BEST EVIDENCE OF THE CORNER LOCATION AND MEASURED TO THE 4 IRON RODS AND 2 PROPERTY CORNERS.

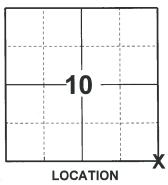

(INDICATE CORNER BY "X")




DATA SHOWN HERE ON THIS TIE SHEET IS CORRECT AND COMPLETE TO THE BEST OF MY KNOWLEDGE AND BELIEF.

PROFESSIONAL LAND SURVEYOR 2020

## -TIE SKETCH

NOTE: THE CORNER LANDS 1.8'± WEST OF CTH 'P' CENTERLINE.



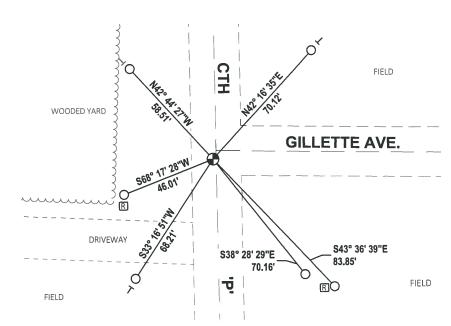

FOUND 3/4" IRON ROD

FOUND SURVEY NAIL MONUMENT

RIGHT OF WAY GUARD POST

VINYL "T" POST

<del></del>	(49)
ADAMS COUNTY	CORNER NO. 522
Survey Monument Record Set Harrison 5-8-75	SECTION 11
TYPE OF MONUMENT: 2"x 30" IRON PIPE	TOWN
STATE PLANE COORDINATES: N	RANGE R.7 E.
EELEVATION — M.S.L. DATUM: THETA ANGLE:	
FIELD BOOK: PAGE	
BASIS FOR MONUMENT LOCATION	
(Use reverse side if necessary)	<u> </u>
Show info such as: History of corner, with reference to Vol. and pg, dates, surveyor; exact description of monument replaced; if location computed, by taped or EDM traverse; landowner remarks, etc.	LOCATION (Indicated by 'X') SEAL:
	WIND CONS.
	MINISONOW WILL
Ran E.D.M. traverse of section by using centerline of roads and east-west fence,	FREDERIO W.
this fit good for the section corner.	FREDERIC  W.  ZIETLOW  S-922  Baraboo  WIS.  OSURVE
	S-922 Raraboo
CORNER O.K. 10-22-76 RN-SS	EC. WIS
" 6-17-91 JG	WIS. OLE
CORNER O.K. 10-22:16 RN-SS 11 11 6-17-91 JG 11 11 11/28/95 JG-55	"Manining"
" " [6]11/0] 36	
1-NEW TIE, 2-7-06-J6 OK, 3/10/2011 GTIL	CERTIFIED CORRECT:
OK , 3/10/2011 GTIL	Registered Land Surveyor
	Registered Land Surveyor DATE: Nov. 22, 1974
TIE SKETCH	
TIE SKETCH (Show at least four ties)	1
N	
$\leq \parallel \geq \parallel$	NAIL IN STOP SIGN
F	
E NIEW NAIL IN TO	44,30
UTILITY POLE 334'	GILLETTE AVE.
.55	SILLETTE AVE.
<b>5</b>	06'
NO SCALE	TOP CONTER OF TELEPHONE JUNCTION BOX
[2]	NAIL IN COME
	THE CORNER OF
	Telephone Service