14 TOWN

# ADAMS COUNTY COUNTY CORNER NO: 64 ROMPORTOL ID: 41407170020

## PUBLIC LAND SURVEY MONUMENT RECORD

HARRISON (BROKEN-TOP) TYPE OF MONUMENT: ADAMS COUNTY COORDINATES, NAD 83 (2007)

N. 116808.065

E. 565170.388


**ELEVATION-**DATUM - — —

FIELD WORK DATE: 04/20/2020

#### BASIS FOR MONUMENT LOCATION

1974 - PLS 776 AREA MACHINE EXCAVATED- NOTHING FOUND. DISTANCES CHECKED BY EDM. HARRISON SET.

2020 - PLS 2675 FOUND SURVEY NAIL IN THE ROAD SURFACE, REMOVED AND FOUND HARRISON (BROKEN-TOP) 24"± BELOW THE ROAD SURFACE, DID NOT RECOVER ANY TIES OR WITNESSES. VERIFIED THE MONUMENT IS NEAR ON LINE AND EQUIDISTANT BETWEEN ADJACENT SECTION CORNERS. ACCEPTED THE HARRISON (BROKEN-TOP) AS THE BEST EVIDENCE OF THE CORNER LOCATION. MEASURED TO 4 FOUND WISDOT ALUMINUM CAP MONUMENTS.

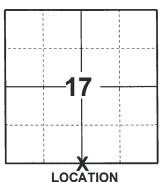

(INDICATE CORNER BY "X")



DATA SHOWN HERE ON THIS TIE SHEET IS CORRECT AND COMPLETE TO THE BEST OF MY KNOWLEDGE AND BELIEF.


PROFESSIONAL LAND SURVEYOR

#### -TIE SKETCH

NOTE: THE CORNER LANDS 6.7'± WEST OF 5TH DR. CENTERLINE.



VINYL "T" POST

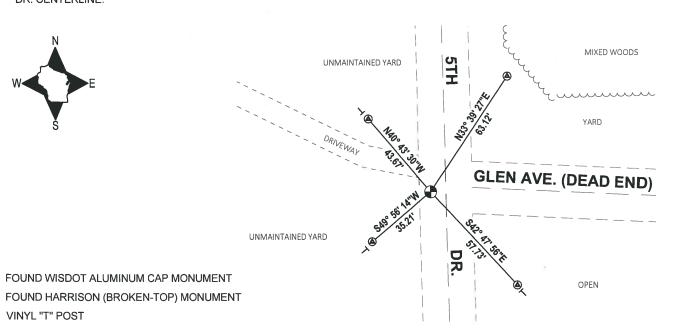

	(64)
ADAMS COUNTY	CORNER NO. <b>535</b>
Survey Monument Record	SECTION
TYPE OF MONUMENT: HARRISON	TOWN14
STATE PLANE COORDINATES: N	range7
ELEVATION — M.S.L. DATUM: THETA ANGLE:	
FIELD BOOK: PAGE	-++  N
BASIS FOR MONUMENT LOCATION	
(Use reverse side if necessary)	<u> </u>
Show info such as: History of corner, with reference to Vol. and pg, dates, surveyor; exact description of monument replaced; if location computed, by taped or EDM traverse; landowner remarks, etc.	LOCATION (Indicated by 'X') SEAL:
TIES ARE TO ZO# SPIKE.	11/10/16030000000
AREA MACHINE EXCAUATED - NOTHING FOON	STATE ON STATE
DISTANCES CHECKED BY E.D.M.	HEDMAN
MEASUREMENTS ARE HORIZONTAL	HERMAN S. HOLZMILLER BARABOO, WISCONSIN
CORNER O.K. 10-22-76 RN-55	BARABOO, WISCONSIN ON SURVINGE BARABOO, WISCONSIN ON SURVINGE BARABOO, WISCONSIN ON SURVINGE BARABOO,
11 11 2-12-86 GR-55	SURVE SURVES SERVE
" 11-5-90 JG-SS	SURVE OUT
" 11/28/95 JG-55	1 attaches as
-NEW CORDK LINE +	
1-NEN COR OK 6/11/01-JG	CERTIFIED CORRECT:
2-16-11 OK 55	German Hofmille
	Registered Land Surveyor 5-776  DATE:/Z-/6-74
	DATE:
TIE SKETCH	
(Show at least four ties)	
STUMP, MALL STILL D	
28" BURK OAK -1	
FO NAIL IN YARD	
FO NAIL IN YARD 30" BLACK OAK	,200 EV
8958' 24" RIK Oak O	314 200 60
+145° N 1000 Mail N 72740	
	TOWN ROAD
3/4" <sub>RoD</sub> 37 127.80 50.23	575° 20'E
3/4"ROD \\ \\ \\ \\ \\ \\ \\ \\ \\ \\ \\ \\ \\	10400
!   de	3/4" Power Pole
PASTURE	3/4" Power Pole
TASTURE	"/.
1	15"HICKORY/OT
	Vot

### CORNER NO. <u>535</u> MS COUNTY SECTION rvey Monument Record 14 TOWN TYPE OF MONUMENT: MARRISON RANGE STATE PLANE COORDINATES: N\_ ELEVATION — M.S.L. DATUM: \_\_\_\_\_ THETA ANGLE: FIELD BOOK: \_\_\_\_\_ PAGE \_\_\_\_ BASIS FOR MONUMENT LOCATION (Use reverse side if necessary) LOCATION Show info such as: History of corner, with reference to Vol. and pg, dates, surveyor; exact description of monument replaced; if location computed, by taped or EDM traverse; landowner (Indicated by 'X') SEAL: remarks, etc. TIES ARE TO ZO# SPIKE. MACHINE EXCAUATED - NOTHING FOUND. DISTANCES CHECKED BY E.D.M. HERMAN S. MCASUREMENTS ARE HORIZONTAL HOLZMILLER BARABOO. WISCONSIN CORNER O.F. 10-22.76 2-12-86 . 6-12-55 11/28/95 JG-SS 12/14/00 SH-MC NEW TIES CERTIFIED CORRECT: Registered Land Surveyor DATE: 12-16 -74 TIE SKETCH (Show at least four ties) 3/4 ROD FD. TOWN ROAD 127.80

Prower Pole