

PUBLIC LAND SURVEY MONUMENT RECORD

TYPE OF MONUMENT: HARRISON
ADAMS COUNTY COORDINATES, NAD 83 (2007)

N. 103416.244

E. 578397.286


ELEVATION- _____ DATUM _____

FIELD WORK DATE: 05/06/2020

BASIS FOR MONUMENT LOCATION


1976 - PLS 1191 RESEARCHED COUNTY SURVEY RECORDS FOUND SURVEY BY A.J. BARRETT, JUNE 8, 1896, VOL. 2 PG. 184. FOUND NO EVIDENCE IN FIELD OF LOCATION OF CORNER. SET HARRISON EQUIDISTANT BETWEEN THE NW CORNER AND SW CORNER SECTION 35 AND IN NORTH-SOUTH FENCE LINE. EDM TRAVERSE.

2020 - PLS 2675 FOUND HARRISON FLUSH WITH THE GROUND AND 1 WITNESS. THE MONUMENT AGREES WITH THE WITNESS AND IS NEAR EQUIDISTANT BETWEEN THE NE AND SE CORNERS OF SECTION 34. ACCEPTED THE HARRISON AS THE CORNER LOCATION. SET 4 NEW TIES, MEASURED TO A FOUND PROPERTY IRON AND THE EXISTING WITNESS.

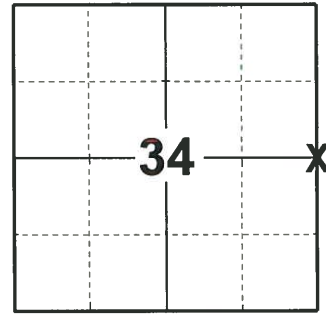

LOCATION
(INDICATE CORNER BY "X")

SEAL:

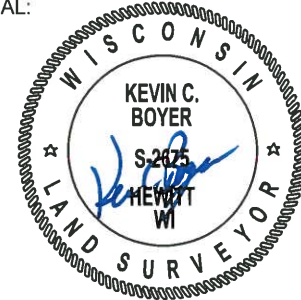


DATA SHOWN HERE ON THIS TIE SHEET IS CORRECT AND COMPLETE TO THE BEST OF MY KNOWLEDGE AND BELIEF.

PROFESSIONAL LAND SURVEYOR

DATE 5/28/2020


- TIE SKETCH

NOTE: THE CORNER LANDS 132'± NORTH OF STH "23" CENTERLINE.

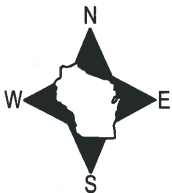

FIELD

FIELD

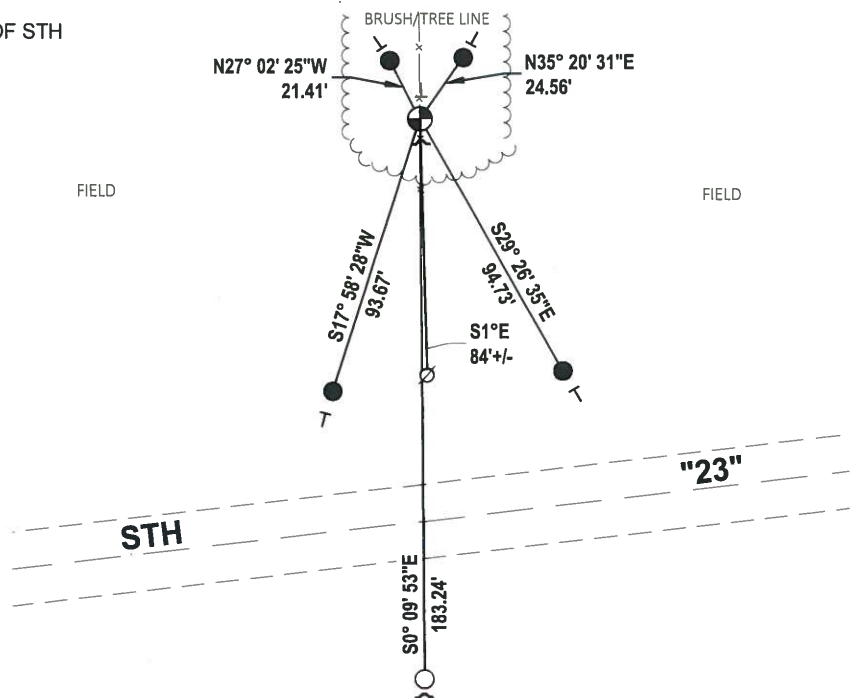

- SET 3/4" x 18" IRON REBAR, 1.50#/FT
- FOUND 3/4" IRON ROD
- ⊕ FOUND HARRISON MONUMENT
- ⊗ WITNESS POWER POLE
- ┘ STEEL FENCE POST
- └ VINYL "T" POST

ADAMS COUNTY

Survey Monument Record

TYPE OF MONUMENT: HARRISON

STATE PLANE COORDINATES: N _____

E _____

ELEVATION — M.S.L. DATUM: _____

THETA ANGLE: _____


FIELD BOOK: 486 PAGE 46

CORNER NO. 118

¹⁰⁹⁸ SECTION 35

TOWN 14 N

RANGE 7 E

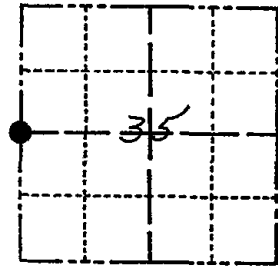

LOCATION
(Indicated by 'X')

SEAL:

BASIS FOR MONUMENT LOCATION

(Use reverse side if necessary)

Show info such as: History of corner, with reference to Vol. and pg, dates, surveyor; exact description of monument replaced; if location computed, by taped or EDM traverse; landowner remarks, etc.

Research county survey records
found survey by A. J. BARRETT,
June 8, 1896, Vol. 2 Pg 184. Found no
evidence in field of location of corner
Set HARRISON equa-distance between
The NW Cor & SW Cor Sec 35-14-7
And in N-S Fence line E.D.M
Traverse




CERTIFIED CORRECT:

Allen D. Rohde
Registered Land Surveyor

DATE: 10-7-76

TIE SKETCH

(Show at least four ties)

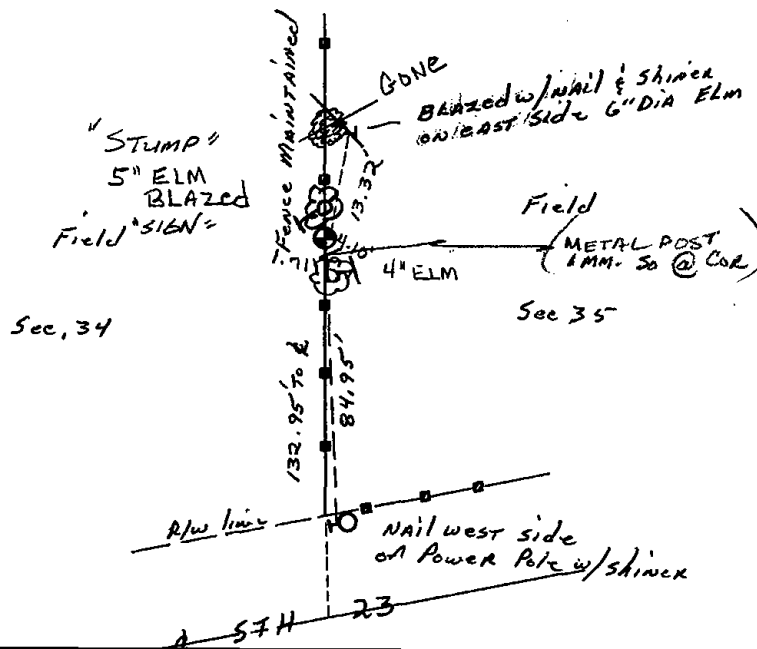

MAINTENANCE RECORD

Date	Init.	Remarks
3-5-86	GR. SS	OK
10-17-91	JG	OK
6-7-96	BS. SS	OK
12-18-01	JG	OK, CHECK SURVEY
1-23-06	JG	OK
1-3-12	MS	OK

GROTHMAN

