## ADAMS COUNTY COUNTY CORNER NO: 28 ROMPORTOL ID: 41506030020


## PUBLIC LAND SURVEY MONUMENT RECORD


TYPE OF MONUMENT:	HARRISON	
ADAMS COUNTY COORDINATES, NAD 83 (2007)		
N159403.656	_	
E. 544462.240	_	
ELEVATION	DATUM <del>-</del>	
FIELD WORK DATE: 06/14	/2018	

## BASIS FOR MONUMENT LOCATION

1979 - PLS 1478 CALCULATED THE CORNER ON LINE BETWEEN ADJACENT SECTION CORNERS AND ON A NORTH-SOUTH LINE DETERMINED BY SURVEYS TO THE SOUTH. SET HARRISON AT CALCULATED POSITION AND TIED OUT.

2018 - PLS 2994 FOUND A HARRISON MONUMENT 2" BELOW THE ROAD SURFACE AND 2 TIES. THE MONUMENT AGREES WITH THE EXISTING TIES. ACCEPTED THE HARRISON MONUMENT AS THE CORNER LOCATION. SET 2 NEW TIES AND MEASURED TO THE TIES.

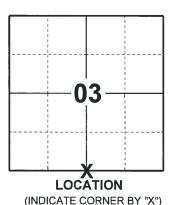

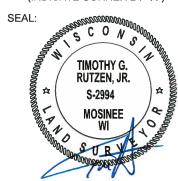

DATA SHOWN HERE ON THIS TIE SHEET IS CORRECT AND COMPLETE TO THE BEST OF MY KNOWLEDGE AND BELIEF.

PROFESSIONAL LAND SURVEYOR


DATE \_\_\_ 7-18-18

## - TIE SKETCH

NOTE: THE CORNER FALLS 7'± NORTH OF THE CENTERLINE OF FERN AVE.



- SET 3/4" x 18" IRON REBAR, 1.50#/FT
- O FOUND 3/4" IRON ROD
- O FOUND 1-1/4" O.D. IRON PIPE
- FOUND HARRISON MONUMENT
- STEEL FENCE POST
- VINYL "T" POST

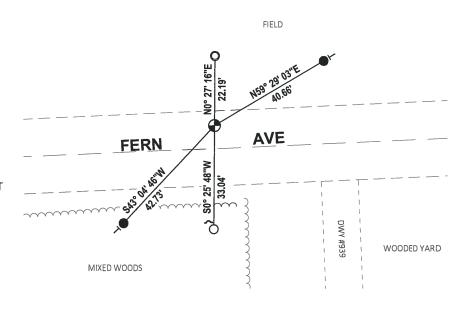

Government Land Corner Certificate		_
ADAMS County	CORNER NO	
TYPE OF MONUMENT: HARRISON	SECTION _	3
STATE PLANE COORDINATES: N	TOWN _	15
ELEVATION — M.S.L. DATUM:	RANGE _	6
THETA ANGLE:		7
FIELD BOOK: 57 PAGE 98		
DRAWN BY: R. NUBER		
BASIS FOR MONUMENT LOCATION		M
Show info such as History of annual id.		
and pg., dates, surveyor; exact description of monument replaced; if location computed, by taped or EDM traverse; landowner remarks, etc. (Use reverse side if necessary)	LOCATION	
Set corner on line between adjacent section corners	SEAL: (Indicated by 'X')	
on N-S 1/4 line determined by surveys to the south.	SEAL: and  GREGORY P. RHINEHART S-1478 Wisconsin Rapid Wis.  DATA SHOWN HERE ON	THE TOTAL OF THE PARTY OF THE P
MAINTENANCE RECORD	Relian 19	Van.
Date Init. Remarks	☆ GREGORY P.	\\\\\\\\\\\\\\\\\\\\\\\\\\\\\\\\\\\\\\
12-30-81 SK-BW CORNER O.K.	RHINEHART S-1478	
1-17-86 CR OR 1-31-91 KF-JG ALL OR	Wisconsin Hapid Wis.	8
1-31-91 KFJG ALL OK 11-21-95 SS BK	E .	Jor .
1-25-01 JG 1-GONE, 1-NEW TIE	NO SURVE	RIFA
4-26-06 JG OK	AND 18181868	•
1-24-11 SS / NEW	DATA SHOWN HERE ON CERTIFIED CORRECT:	6
	CERTIFIED CORRECT:	what
	Registered Land Surveyor	when
	DATE:9/4/3	79
TIE SKETCH		
Show at least four ties, also fence lines, roads, topo, size and type of witness trees' and if off road - best way to		
irrive at corner.	ER	
31.7 - NW CORN ELEC, BOX	1728523"	
OPEN FIE		
O 1,x54, I	CON PIPE	
	FORMERLY HARRISON	
89 89		
n)		
0 Frank		
L' FERN 1	35 NE.	
3/4" ROD	TO DRIVE	
5° 0° 0° 5° 0° 0° 0° 0° 0° 0° 0° 0° 0° 0° 0° 0° 0°	\$ 7 E	
8,	2 4 E	
(2) (2) (2) (2) (3) (4) (4) (4) (4) (4) (4) (4) (4) (4) (4	CF3 A	
4£,)	16"RED OAK 4"	GONE FACK PING/B
16" BLACK DAK/BT OAK/BT OAK/BT	N %r STUM o	B. INE

MAINTENANCE RECORD

DATE	BY WHOM	REMARKS
		<u> </u>
<del>-</del>		