ADAMS COUNTY COUNTY CORNER NO: 31 ROMPORTOL ID: 41506020000


PUBLIC LAND SURVEY MONUMENT RECORD

TYPE OF MONUMENT: HARRISON		
ADAMS COUNTY COORDINATES, NAD 83 (2007)		
N. 159472.256		
E. 552381.359		
ELEVATION DATUM — —		
FIELD WORK DATE: 06/13/2018		

BASIS FOR MONUMENT LOCATION

1975 - PLS 878 EXCAVATED WITH A BACKHOE AND FOUND A 4"x12"x12" SANDSTONE. LOWERED THE STONE AND SET A HARRISON ABOVE AND TIED OUT CORNER, WITNESSED BY ADOLPH BORW, LOCAL LANDOWNER AND COUNTY BOARD CHAIRMAN. THE STONE WAS BELIEVED TO BE SET BY A. BARRETT, 1902, VOL 1, PG 2.

2018 - PLS 2994 FOUND A HARRISON MONUMENT 3" BELOW THE ROAD SURFACE AND 1 PROPERTY IRON. THE MONUMENT AGREES WITH THE PROPERTY IRON BEING 33' FROM C/L. ACCEPTED THE HARRISON MONUMENT AS THE CORNER LOCATION. SET 3 NEW TIES AND MEASURED TO THE TIES.

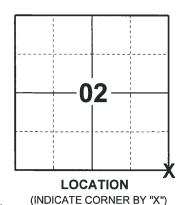

SEAL: TIMOTHY G. RUTZEN. JR. S-2994 MOSINEE

DATA SHOWN HERE ON THIS TIE SHEET IS CORRECT AND COMPLETE TO THE BEST OF MY KNOWLEDGE AND BELIEF.


PROFESSIONAL LAND SURVEYOR

7-18-18

-TIE SKETCH

NOTE: THE CORNER FALLS 5'± NORTH OF THE CENTERLINE OF FERN AVE.



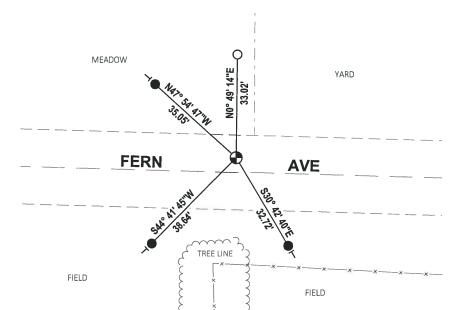

- SET 3/4" x 18" IRON REBAR, 1.50#/FT
- FOUND 3/4" IRON ROD
- FOUND HARRISON MONUMENT
- VINYL "T" POST

ADAMS COUNTY	CORNER NO. <u>642</u> (31)
Survey Monument Record	SECTION/
TYPE OF MONUMENT: Harrison standard	TOWN
STATE PLANE COORDINATES: N	RANGE 6
ELEVATION — M.S.L. DATUM: THETA ANGLE: FIELD BOOK: PAGE	A N
BASIS FOR MONUMENT LOCATION	
(Use reverse side if necessary)	<u> </u>
Show info such as: History of corner, with reference to Vol. and pg, dates, surveyor; exact description of monument replaced; if location computed, by taped or EDM traverse; landowner remarks, etc.	LOCATION (Indicated by 'X') SEAL:
,	esternium mile
Excavated with backhoe. Found 4"x12"x12" sandstone. Lowered stone and set Harrison on top. Witnessed by Adolph Bork, local landowner and County Board Chairman.	ANTHONY B. KIEDROWSKI S-878 Wisconsin Rapids, Wis.
Stone believed to be set by A. Barrett, 1902, Vol 1, Pg 2.	
CORNER O.K. 4-23-76 RN-55	William SURVERS
ALL OK 1-14-91 - KZ-JG 1 GONE- SEE CSM SS 11-22-95 CHECK FOR CSM - 1-29-01, SG-MH. 7-11-11 OK SS	CERTIFIED CORRECT: JULY 15, KONOVILLE Registered Land Surveyor DATE: 4/24/75
TIE SKETCH	
(Show at least four ties)	
Ties are to nail and disc.	C 5 M
Power Pole	8"BLK OAK (NO 87, IN YARD)
WEST EDGE OF FIGEL OPTICS POST 4"RED OAK AT	ξ-