

04  
SECTION

15  
TOWN

07  
RANGE

# ADAMS COUNTY

COUNTY CORNER NO: 27

ROMPORTOL ID: 41507040000

## PUBLIC LAND SURVEY MONUMENT RECORD

TYPE OF MONUMENT: HARRISON

ADAMS COUNTY COORDINATES, NAD 83 (2007)

N. 159327.212

E. 573156.543


ELEVATION-          DATUM         

FIELD WORK DATE: 03/02/2021

### BASIS FOR MONUMENT LOCATION

1978 - PLS 878 EXCAVATED WITH BACKHOE AND FOUND DEFINITE STAIN OF POST 20" INTO THE SUBSOIL. THIS POSITION "FIT" A TRAVERSE BY MIDSTATE ASSOC. WELL AND WAS ACCEPTED AS THE LOCATION OF THE CORNER.

2021 - PLS 2675 FOUND A HARRISON MONUMENT 6"± BELOW THE ROAD SURFACE AND 1 WITNESS. THE MONUMENT AGREES WITH THE EXISTING WITNESS. ACCEPTED THE HARRISON AS THE CORNER LOCATION. SET 4 NEW TIES AND MEASURED TO THE EXISTING WITNESS.

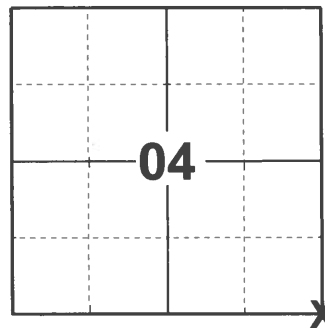

LOCATION

(INDICATE CORNER BY "X")

SEAL:





DATA SHOWN HERE ON THIS TIE SHEET IS CORRECT AND COMPLETE TO THE BEST OF MY KNOWLEDGE AND BELIEF.

PROFESSIONAL LAND SURVEYOR

DATE 5/20/21

### - TIE SKETCH

NOTE: THE CORNER LANDS 2'± SOUTH OF CENTERLINE OF FERN AVE. AND 2.5'± WEST OF 4TH AVE.

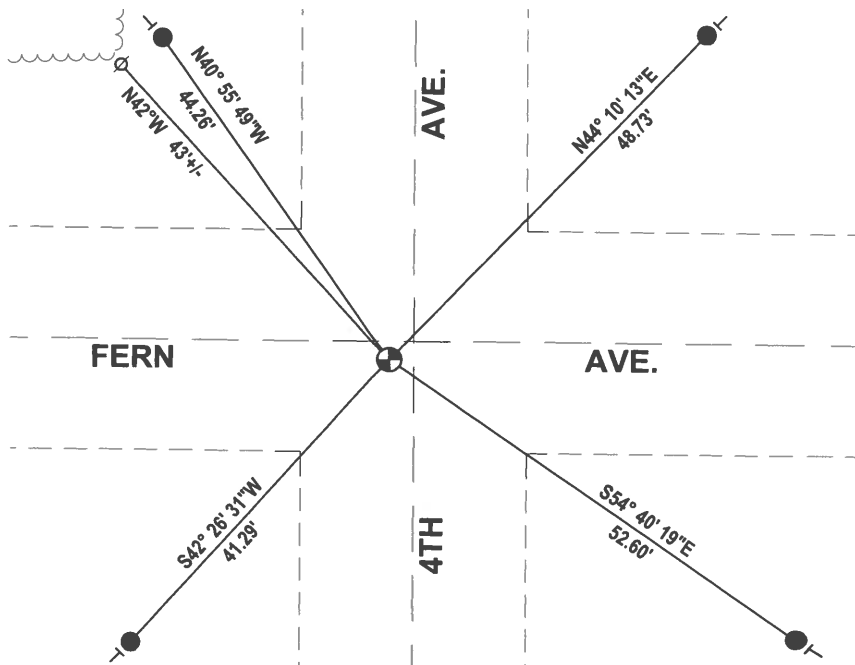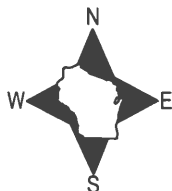

- SET 3/4" x 18" IRON REBAR, 1.50#/FT
- ⊕ FOUND HARRISON MONUMENT
- ⊗ WITNESS POWER POLE
- ⊥ VINYL "T" POST

# Government Land Corner Certificate

ADAMS County

TYPE OF MONUMENT: HARRISON

STATE PLANE COORDINATES: N \_\_\_\_\_

E \_\_\_\_\_

ELEVATION — M.S.L. DATUM: \_\_\_\_\_

THETA ANGLE: \_\_\_\_\_

FIELD BOOK: 54 PAGE 48


DRAWN BY: G. RHINEHART

CORNER NO. 27

SECTION 10

TOWN 15

RANGE 7

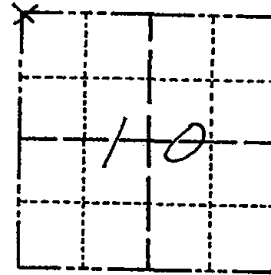

LOCATION  
(Indicated by 'X')

## BASIS FOR MONUMENT LOCATION

Show info such as: History of corner, with reference to Vol. and pg., dates, surveyor; exact description of monument replaced; if location computed, by taped or EDM traverse; landowner remarks, etc. (Use reverse side if necessary)

Excavated with backhoe and found definite stain of post 20" into the subsoil. This position "fit" a traverse by Midstate Assoc. well and was accepted as the location of the corner.

SEAL:




DATA SHOWN HERE ON  
CERTIFIED CORRECT:

*Anthony B. Kiedrowski*  
Registered Land Surveyor

DATE: 12/22/28

## TIE SKETCH

Show at least four ties, also fence lines, roads, topo, size and type of witness trees' and if off road - best way to arrive at corner.

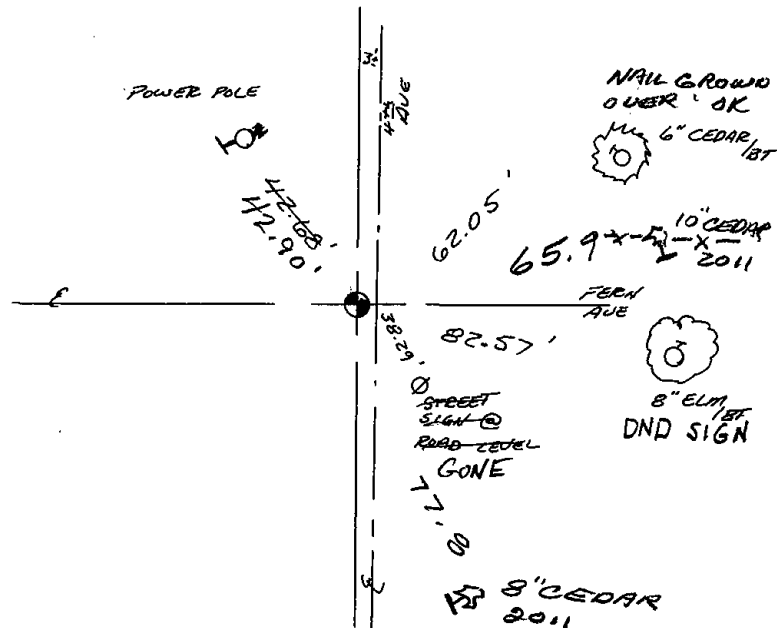

## MAINTENANCE RECORD

Date	Init.	Remarks
12-21-81	TH-NJ	MOYD. O.K.
2-3-86	GR-SS	O.K.
3-26-91	JG	1-GONE, CORNER O.K.
11-21-95	SS	OK
2-16-01	JG	OK
4-8-06	JG	OK
2-15-11	SS	2 NEW TIES