OT ADAMS COUNTY COUNTY


PUBLIC LAND SURVEY MONUMENT RECORD

HARRISON TYPE OF MONUMENT: ADAMS COUNTY COORDINATES, NAD 83 (2007) N. 148760.486 E. 570482.100 ELEVATION- - - DATUM 03/31/2021 FIELD WORK DATE:


BASIS FOR MONUMENT LOCATION

1979 - PLS 1478 SET HARRISON MONUMENT OPPOSITE FENCES AND ON LINE BETWEEN THE ADJACENT SECTION CORNERS, CORNER LOCATION MATCHED THE POSSESSION TO THE EAST AND WEST. ALSO FIT THE PROPORTION OF M.C. SMITH NOTE IN ACSR VOLUME 2 PAGE 50 VERY WELL.

2021 - PLS 2675 FOUND HARRISON MONUMENT FLUSH WITH GROUND SURFACE. DID NOT RECOVER ANY EXISTING TIES OR WITNESSES. ACCEPTED THE HARRISON MONUMENT AS THE CORNER LOCATION AND SET 4 NEW TIES.

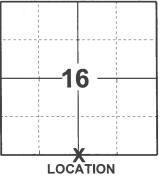

(INDICATE CORNER BY "X")

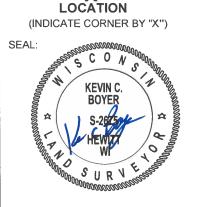


DATA SHOWN HERE ON THIS TIE SHEET IS CORRECT AND COMPLETE TO THE BEST OF MY KNOWLEDGE AND BELIEF.

PROFESSIONAL LAND SURVEYOR 19/21 DATE

-TIE SKETCH

NOTE: CORNER LANDS 26.6'± NORTH OF THE CENTERLINE OF STH 82.



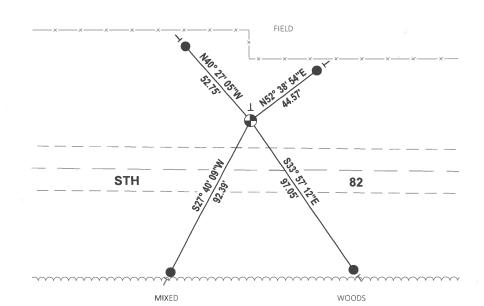

- SET 3/4" x 18" IRON REBAR, 1.50#/FT
- FOUND HARRISON MONUMENT
- VINYL "T" POST

Government Land Corner Certificate CORNER NO. County SECTION TYPE OF MONUMENT: HARRISON TOWN STATE PLANE COORDINATES: RANGE ELEVATION — M.S.L. DATUM: . THETA ANGLE: 76 18 FIELD BOOK: _ PAGE . DRAWN BY: B. SULLIVAN BASIS FOR MONUMENT LOCATION Show info such as: History of corner, with reference to Vol. and pg., dates, surveyor; exact description of monument replaced; if location computed, by taped or EDM traverse; landowner remarks, etc. (Use reverse side if necessary) SEAL: Set corner opposite fences and on line between the adjacent section corners. this location matched the possesion to the east and west and also fit the proportion of M.C. Smith note in ACSR Vol. 2 page 50 very well. Excavation was not attempted at this location. DATA SHOWN HERE ON CERTIFIED CORRECT: DATE: TIE SKETCH Show at least four ties, also fence lines, roads, topo, size and type of witness trees' and if off road - best way to arrive at corner. POWER POLE ST. HWY. *2. 66 14"BLACK 10 WHITE DAK ! OAK OAK NAIL @3' NAIL @ 3' ABOVE GROUND ABOVE GROUND

MAINTENANCE RECORD

DATE	BY WHOM	REMARKS
12-29-81	TH-NJ	MONETIES O.K.
3-3-86	GR-55	n
3-26-91	16	ALL DK
4-19-96	56-55	OK.
	·	
	<u> </u>	