

27
SECTION

16
TOWN

05
RANGE

ADAMS COUNTY

COUNTY CORNER NO: 108

ROMPORTOL ID: 41605270020

PUBLIC LAND SURVEY MONUMENT RECORD

TYPE OF MONUMENT: HARRISON

ADAMS COUNTY COORDINATES, NAD 83 (2007)

N. 170000.211

E. 512642.849


ELEVATION- DATUM

FIELD WORK DATE: 02/16/2021

BASIS FOR MONUMENT LOCATION

1977 - PLS 878 EXCAVATED WITH BACKHOE. FOUND BROKEN SANDSTONE 8" ON SIDES, 13" HIGH, POINTED. PUT PIECES OF STONE AROUND WEST AND NORTH SIDE OF HARRISON. NO RESURVEYS ON RECORD. LOCATION VERIFIED BY EDM TRAVERSE.

2021 - PLS 2675 FOUND HARRISON 6" BELOW THE ROAD SURFACE AND 3 WITNESSES. ACCEPTED THE HARRISON AS THE CORNER LOCATION. SET 4 NEW TIES AND MEASURED TO THE EXISTING WITNESSES.

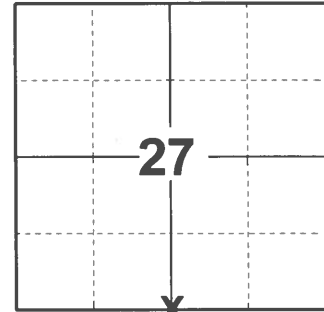

LOCATION

(INDICATE CORNER BY "X")

SEAL:





DATA SHOWN HERE ON THIS TIE SHEET IS CORRECT AND COMPLETE TO THE BEST OF MY KNOWLEDGE AND BELIEF.

PROFESSIONAL LAND SURVEYOR

DATE 3/3/2021

- TIE SKETCH

NOTE: THE CORNER LANDS 2± NORTH OF EVERGREEN AVE. CENTERLINE AND 2± EAST OF 16TH DR. CENTERLINE.

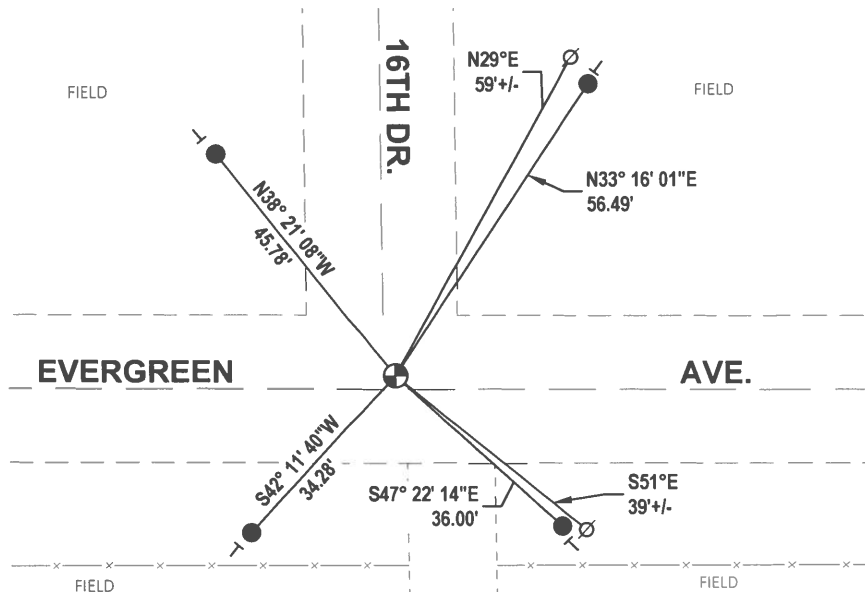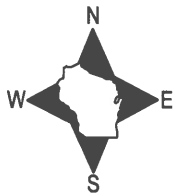


- SET 3/4" x 18" IRON REBAR, 1.50#/FT
- ⊕ FOUND HARRISON MONUMENT
- ⊙ WITNESS POWER POLE
- ┆ VINYL "T" POST

Government Land Corner Certificate

ADAMS County
 TYPE OF MONUMENT: HARRISON STD.
 STATE PLANE COORDINATES: N _____
 E _____
 ELEVATION — M.S.L. DATUM: _____
 THETA ANGLE: _____
 FIELD BOOK: 101 PAGE 114
 DRAWN BY: SCOTT SORENSEN

CORNER NO. 108
 SECTION 27
 TOWN 16
 RANGE 5

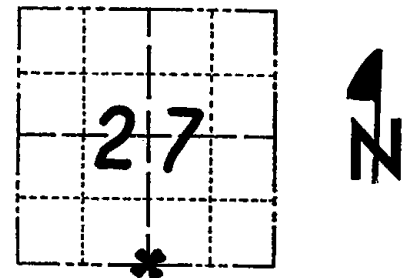

LOCATION
(Indicated by 'X')


BASIS FOR MONUMENT LOCATION

Show info such as: History of corner, with reference to Vol. and pg., dates, surveyor; exact description of monument replaced; if location computed, by taped or EDM traverse; landowner remarks, etc. (Use reverse side if necessary)

Excavated with backhoe. Found broken sandstone 8" on sides, 13" high, pointed. Put pieces of stone around west and north side of Harrison. No resurveys on record. Location verified by EDM traverse.

ALL OK 4/15/85 D.K.

SEAL:

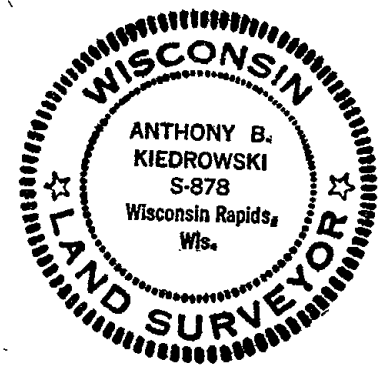


DATA SHOWN HERE ON CERTIFIED CORRECT:

Anthony B. Kiedrowski
 Registered Land Surveyor

DATE: 11/1/77

TIE SKETCH

Show at least four ties, also fence lines, roads, topo, size and type of witness trees' and if off road - best way to arrive at corner.

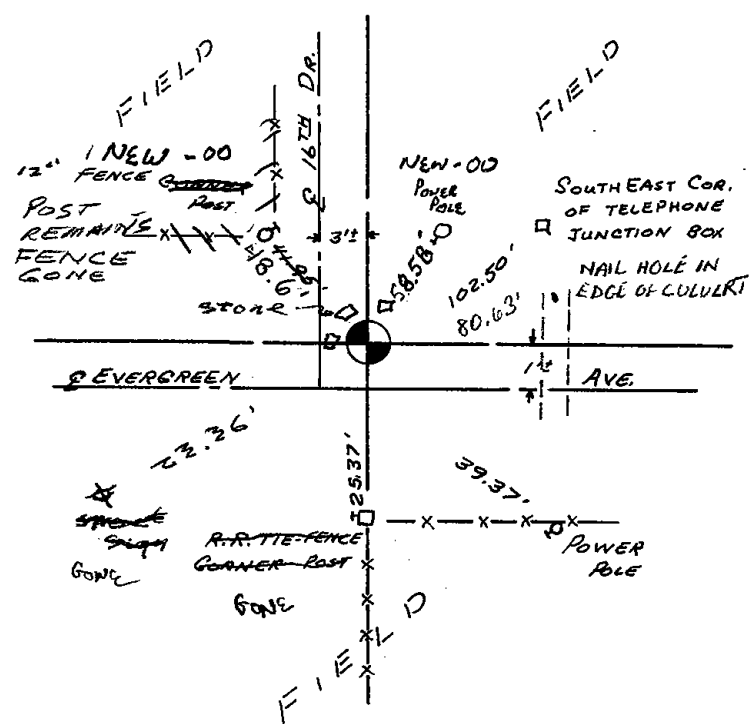

MAINTENANCE RECORD

Date	Init.	Remarks
10/6/80	KV-SK	COR. OK
2-15-90	KZ-GR	ALL OK
2-7-95	JG	ALL OK
2-10-00	TN.SS	2 NEW 3 GONE
3-4-05	SS JS	ALL OK
7-7-10	SS	OK