

32
SECTION

16
TOWN

06
RANGE

ADAMS COUNTY

COUNTY CORNER NO: 116

ROMPORTOL ID: 41606322000

PUBLIC LAND SURVEY MONUMENT RECORD

TYPE OF MONUMENT: HARRISON

ADAMS COUNTY COORDINATES, NAD 83 (2007)

N. 167315.175

E. 536579.226


ELEVATION- _____ DATUM _____

FIELD WORK DATE: 11/25/2020

BASIS FOR MONUMENT LOCATION

1975 - PLS 922 CHECKED COUNTY SURVEY RECORDS AND NO RESURVEYS WERE FOUND. SET HARRISON MONUMENT AT INTERSECTION OF CENTERLINES. FIT TAPED TRAVERSE OF SECTION GOOD. IN 1962 DON MCCONAGHY DID A SURVEY IN THIS SECTION. BACKED OUT HIS SURVEY TO FIT THIS CORNER. THE CORNER WAS NOT MONUMENTED BY MCCONAGHY.

2020 - PLS 2675 FOUND HARRISON 2"± BELOW THE ROAD SURFACE AND 3 WITNESSES. THE MONUMENT AGREES WITH ALL 3 WITNESSES. ACCEPTED THE HARRISON AS THE CORNER LOCATION. SET 4 NEW TIES AND MEASURED TO THE EXISTING 3 WITNESSES.

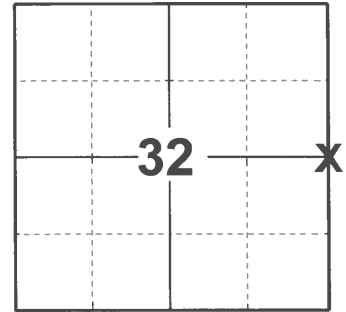

LOCATION

(INDICATE CORNER BY "X")

SEAL:





DATA SHOWN HERE ON THIS TIE SHEET IS CORRECT AND COMPLETE TO THE BEST OF MY KNOWLEDGE AND BELIEF.

PROFESSIONAL LAND SURVEYOR

DATE 12/3/2020

TIE SKETCH

NOTE: THE CORNER LANDS ON THE CENTERLINE OF EVERGREEN DR.

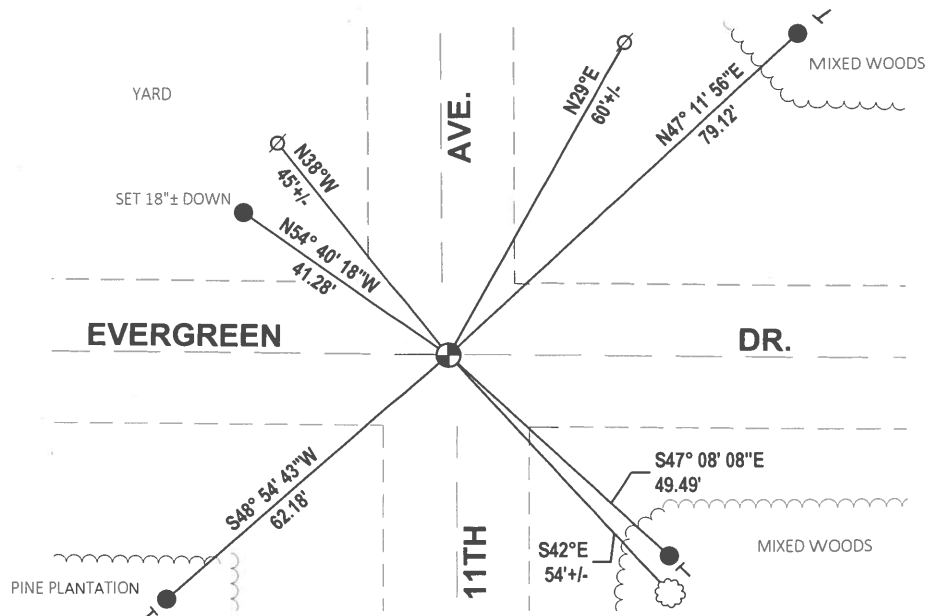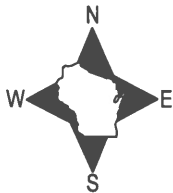

- SET 3/4" x 18" IRON REBAR, 1.50#/FT
- ⊕ FOUND HARRISON MONUMENT
- ⊙ WITNESS POWER POLE
- ┆ VINYL "T" POST
- ⊙ WITNESS TREE

ADAMS COUNTY

Survey Monument Record

TYPE OF MONUMENT: 30" HARRISON MONUMENT


STATE PLANE COORDINATES: N _____
E _____

ELEVATION — M.S.L. DATUM: _____

THETA ANGLE: _____


FIELD BOOK: 429 ADAMS CO. PAGE 36

CORNER NO. 729 ⁽¹¹⁶⁾
SECTION 33
TOWN 16
RANGE 6

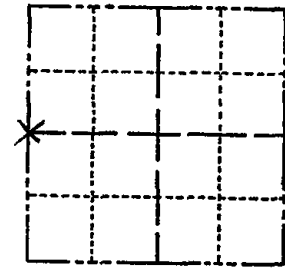

LOCATION
(Indicated by 'X')

SEAL:

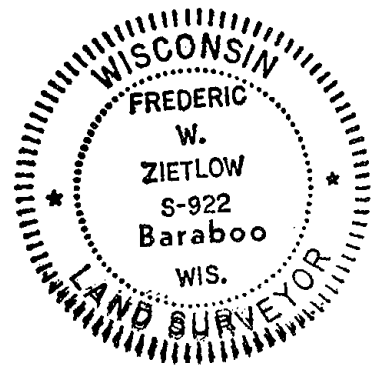

BASIS FOR MONUMENT LOCATION

(Use reverse side if necessary)

Show info such as: History of corner, with reference to Vol. and pg. dates, surveyor; exact description of monument replaced; if location computed, by taped or EDM traverse; landowner remarks, etc.

CHECKED COUNTY SURVEY RECORDS
AND NO RESURVEYS WERE FOUND.
SET HARRISON MONUMENT AT INTERSECTION
OF CENTERLINES. FIT TAPED TRAVERSE
OF SECTION GOOD.
IN 1962 DON MCGONAGHY DID A SURVEY IN THIS
SECTION. WE BACKED OUT HIS SURVEY TO FIT
THIS CORNER. THE CORNER WAS NOT MONUMENTED
BY MCGONAGHY
COR OK 10/17/80 KV-JK
ALL OK 6-26-85 GR-SS
ALL OK 2-12-90 K2-GR
ALL OK 1-9-95 JG-BS
OK 2-17-00 SS
ALL OK 2-25-05-JG
OK 1-15-10 SS

CERTIFIED CORRECT:

Frederic W. Zietlow

Registered Land Surveyor

DATE: MAY 15, 1975

TIE SKETCH

(Show at least four ties)

