17 TOWN

06 RANGE ADAMS COUNTY CORNER NO: 29 ROMPORTOL ID: 41706030000

PUBLIC LAND SURVEY MONUMENT RECORD

TYPE OF MONUMENT: HARRISON
ADAMS COUNTY COORDINATES, NAD 83 (2007)
N. 218911.494
E. 546776.230
ELEVATION DATUM
FIELD WORK DATE: 08/06/2018


BASIS FOR MONUMENT LOCATION

1973 - PLS 878 EXCAVATED WITH A BACKHOE AND FOUND A 3/4" x 24" IRON ROD, REPLACED THE IRON ROD WITH A HARRISON AND TIED OUT, AFTER CHECKING ITS LOCATION BY A TRAVERSE OF THE ENTIRE SECTION.

2018 - PLS 2994 FOUND A HARRISON MONUMENT 4" BELOW THE ROAD SURFACE AND 1 TIE. THE MONUMENT AGREES WITH THE EXISTING TIE. ACCEPTED THE HARRISON MONUMENT AS THE CORNER LOCATION. SET 3 NEW TIES AND MEASURED TO THE TIES.



(INDICATE CORNER BY "X")

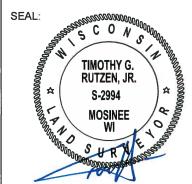


DATA SHOWN HERE ON THIS TIE SHEET IS CORRECT AND COMPLETE TO THE BEST OF MY KNOWLEDGE AND BELIEF

PROFESSIONAL LAND SURVEYOR


DATE

-TIE SKETCH

NOTE: THE CORNER FALLS 0.5'± EAST OF THE CENTERLINE OF THE NORTH SIDE OF 9TH AVE AND 0.5'± NORTH OF THE CENTERLINE OF DEERBORN AVE.

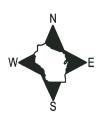

- SET 3/4" x 18" IRON REBAR, 1,50#/FT
- FOUND 3/4" IRON ROD
- FOUND HARRISON MONUMENT
- STOP SIGN
- VINYL "T" POST

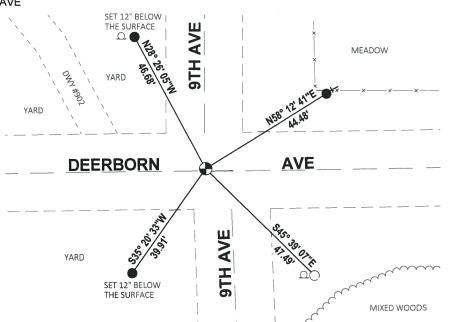

CORNER NO. _ 322 ADAMS COUNTY **SECTION** Survey Monument Record TOWN TYPE OF MONUMENT: 30" HARRISON RANGE STATE PLANE COORDINATES: N. ELEVATION - M.S.L. DATUM: _ THETA ANGLE: _ FIELD BOOK: ______ PAGE _ BASIS FOR MONUMENT LOCATION (Use reverse side if necessary) LOCATION Show info such as: History of corner, with reference to Vol. and pg, dates, surveyor; exact description of monument replaced; if location computed, by taped or EDM traverse; landowner (Indicated by 'X') SEAL: remarks, etc. Excavated with backhoe. Found $\frac{3}{4}$ " x 24" iron rod, and replaced it with Harrison after checking its location by a traverse of the entire Section 10. S-878 Wisconsin Rapids, COR O.K. 9.20-75 RN-55 1/23/80 OK CERTIFIED CORRECT: ALL OK 7-12-85 DK-SS July, 1973 Registered Land Syrveyor 2-6-90 KZ-GR ALL OK 7-27-94 JG-BS TIE SKETCH ALL OK 1-6-00, -JG (Show at least four time) (Show at least four time) 2 NEW TIES 7-21-10 (Show at least four ties)

7"W. P.W. = 18" BAX 18T

& POWER POLE

Q DEERBORN AVE.

12" NORWAY WY SONE BLACK

The Road

BLK AME 1BT CS
DAK
FO 3/4" ROD = 5'SW FROM 164