**ELEVATION-**

# OS RANGE ADAMS COUNTY CORNER NO: 103 ROMPORTOL ID: 41805300000

# PUBLIC LAND SURVEY MONUMENT RECORD

**HARRISON** TYPE OF MONUMENT:\_ ADAMS COUNTY COORDINATES, NAD 83 (2007) N. 229383.331 E. 499351.537


11/21/2018 FIELD WORK DATE:

## BASIS FOR MONUMENT LOCATION

1975 - PLS 1103 RAN A EDM/TRANSIT TRAVERSE AROUND SECTION 32 AND TO ADJACENT SECTION CORNERS, FOUND NO EVIDENCE OF THE ORIGINAL CORNER OR ANY REMONUMENTATION BY EXCAVATION WITH A BACKHOE, SET THE CORNER LOCATION AT THE RECORD DISTANCE FROM THE NORTHEAST CORNER OF SECTION 32 AS RECORDED IN VOLUME 1, PAGE 193 OF THE ADAMS COUNTY SURVEY RECORDS AND AS COMPLETED BY M.C. SMITH, COUNTY SURVEYOR, ON APRIL 1914. SET A HARRISON AT THE CORNER LOCATION AND TIED OUT.

DATUM - -----

2018 - PLS 2675 FOUND A HARRISON MONUMENT 4" BELOW THE ROAD SURFACE 1 TIE, 3 RIGHT-OF-WAY IRONS AND 1 NGS MONUMENT. THE MONUMENT AGREES WITH THE EXISTING TIE. ACCEPTED THE HARRISON MONUMENT AS THE CORNER LOCATION AND RE-MEASURED TO THE EXISTING TIE, RIGHT-OF-WAY IRONS AND NGS MONUMENT.

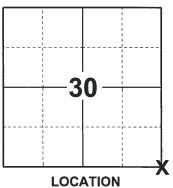

(INDICATE CORNER BY "X")



DATA SHOWN HERE ON THIS TIE SHEET IS CORRECT AND COMPLETE TO THE BEST OF MY KNOWLEDGE AND BELIEF


PROFESSIONAL LAND SURVEYOR

### -TIE SKETCH

NOTE: THE CORNER FALLS 1'± SOUTH OF THE CENTERLINE OF CZECH AVE AND 5'± WEST OF THE CENTERLINE OF CTH Z.



- FOUND 3/4" IRON ROD
- FOUND NGS MONUMENT 4F04
- FOUND HARRISON MONUMENT
- **RIGHT-OF-WAY GUARD POST**
- VINYL "T" POST

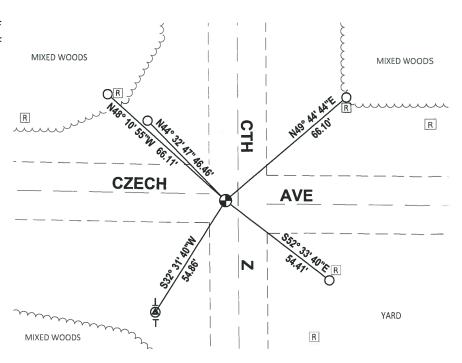

### ADAMS COUNTY CORNER NO. SECTION Survey Monument Record 18 TOWN TYPE OF MONUMENT: Standard Harrison 5 RANGE STATE PLANE COORDINATES: N\_ E\_ ELEVATION — M.S.L. DATUM: \_\_ THETA ANGLE: \_\_ FIELD BOOK: \_\_ \_ PAGE . BASIS FOR MONUMENT LOCATION (Use reverse side if necessary) LOCATION Show info such as: History of corner, with reference to Vol. and pg, dates, surveyor; exact description of monument replaced; if location computed, by taped or EDM traverse; landowner SEAL: remarks, etc. Ran EDM/transit traverse around Section 32 and to adjacent section corners. Could find no evidence of the original corner or subsequent remonumentation by excavation with backhoe. Set corner at record distance from Northeast corner of Section 32 as rocorded in Volume 1, Page 193 of Adams County Survey records and as completed by M.C. Smith, County Surveyor, on April, 1914. RN-55 11-17-78 OK 3-TIES GONE, 3-NEW TIES, MON.OK. 8-20-92-JG ALLOK 2-4-98-56 OK, 1-30-03-JG DATE: August OK 12-11-07- 56-55 TIE SKETCH NOTE: Ties in trees to (Show at least four ties) nail in disc. GONE BIRCH 10" Aspen 181 Ø Power Pole Q, 42.3<sup>5</sup> CSM IRON ROD 46.60 CZECH 81.42 G-ONE 24"W. Oak (Not blazed) NW Corner of GUIDE WIRE POWER POLE 10"BIK. Oak

GONE