17 SECTION 19 TOWN

OT ADAMS COUNTY COUNTY CORNER NO: 65

ROMPORTOL ID: 41907170000

PUBLIC LAND SURVEY MONUMENT RECORD

ADAMS COUNTY ALUMINUM CAP TYPE OF MONUMENT: ADAMS COUNTY COORDINATES, NAD 83 (2007)

N. 271891.824

E. 567445.179

ELEVATION-DATUM

05/15/2019 FIELD WORK DATE:


BASIS FOR MONUMENT LOCATION

1977 - PLS 878 ABK DUG WITH BACKHOE AND FOUND THREE POSTS NEXT TO EACH OTHER. EDM/T2 TRAVERSE WAS RUN TO DETERMINE SEARCH AREAS IN THE VICINITY. THIS SPOT WAS MONUMENT WITH A STANDARD HARRISON MONUMENT.


1990 - PLS 1821 ACCEPTED THE LOCATION BY A.B. KIEDROWSKI. THE SOUTHWEST AND SOUTHEAST ASPEN TREES WERE DEAD. THE NORTHWEST AND NORTHEAST TIES WERE FOUND AS RECORDED. I REREFERENCED AS SHOWN BELOW.

2000 - PLS 2281 HARRISON MONUMENT RESET AFTER COMPLETION OF COUNTY HIGHWAY C RECONSTRUCTION PROJECT. LOCATION IS BASED ON THE EXISTING MONUMENT FOUND BEFORE CONSTRUCTION BEGAN.

2019 - PLS 2675 FOUND MAG NAIL IN THE ROAD SURFACE, REMOVED AND FOUND ADAMS COUNTY ALUMINUM CAP 6" BELOW THE ROAD SURFACE, AND 4 TIES. THE MONUMENT AGREES WITH 3 OF THE 4 TIES. ACCEPTED THE ADAMS COUNTY ALUMINUM CAP AS THE CORNER LOCATION. SET 1 NEW TIE AND MEASURED TO THE EXISTING TIES.

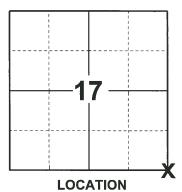

(INDICATE CORNER BY "X")

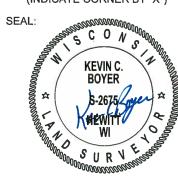

DATA SHOWN HERE ON THIS TIE SHEET IS CORRECT AND COMPLETE TO THE BEST OF MY KNOWLEDGE AND BELIEF.


PROFESSIONAL LAND SURVEYOR

DATE

-TIE SKETCH

NOTE: THE CORNER LANDS 3'± SOUTH OF CTH "C" CENTERLINE AND 2'± WEST OF 5TH AVE. CENTERLINE.



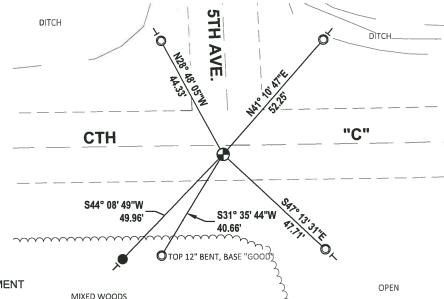


- SET 3/4" x 18" IRON REBAR, 1.50#/FT
- FOUND 1-1/4" O.D. IRON PIPE
- FOUND ADAMS CO. ALUMINUM CAP MONUMENT
- VINYL "T" POST

ADAMS COUNTY U.S. PUBLIC LAND S	SURVEY	CORNER # (65)
MONUMENT LOCATION RECORD	☐ FOUND	SECTION
	☐ FOUND ☐ SET ☑ RE-SET	RANGE 7 EAST
CORNER IDENTITY: SOUTH EAST QUATER CONER	RE-TIED	SECTION 15
STATE PLANE COORDINATE: N:	,	
E:		
ZONE:	1	
ELEVATION:	[]	
DATUM:	7	
THETA ANGLE:	i i	
DATE OF SURVEY: 11/4/99	1	
	• •	
SURVEY PARTY: MARK HINTZ / CHRIS THORSON		LOCATION
BASIS FOR MONUMENT LOCATION:		SEAL
(DESCRIBE METHOD OF SURVEY AND CORNER AUTHENTICATION)		
	1	Manual Canada
HARRISON MONUMENT RESET AFTER COMPLETION OF	, the	" SOM NOW
COUNTY HIGHWAY C RECONSTRUCTION PROJECT. LOCATION IS BASED ON THE EXISTING MONUMENT FOUND BEFORE	, i a	
CONSTRUCTION BEGAN.		· SCOTTER * =
OK, 9-24-07- JG	TA:	Section 1
		· Cigren
		· William
		100000000000000000000000000000000000000
		Trus Villania
	1.1	+ Cre-
	SCOTT GRO	//
	20011 6160	HOLSKI (KLS #ZZOI)
	\overline{DATE}	fill do
TIE SKETCH: SHOW MINIMUM OF FOUR (4) HORIZONTAL		O DIVED WITHERS MONITMENTS
DESCRIBE ALL MONUMENTS FOUND OR SE		
LEGEND TEMPERATURE OF 68° F.	. •	•
© 1 1/4" IRON PIPE SET		DRAWING IS NOT TO SCALE.
○ 1 1/4" IRON PIPE SET R.O.W. POST SET HARISON MONUMENT SET		
HARISON MONUMENT SET		1
VV		
CENTER LINE STATE WILDLIFE AREA SIGN		
STATE WILDLIFE AREA SIGN		
	,	WATER
'		···········
		7711 252 0
	<u></u>	
	P	
Zent 19.5.	O CONTRACTOR OF THE CONTRACTOR	
XX	Q XX	XX XX XX
XX	A NAME OF THE PARTY OF THE PART	xx xx xx
XX	N XX	XX
XX	i v xx xx	xx xx xx
		**

Government Land Corner Certificate CORNER NO. __65 County <u>ADAMS</u> SECTION TYPE OF MONUMENT: <u>HARRISON</u> 19 N TOWN STATE PLANE COORDINATES: N__ TE RANGE ELEVATION - M.S.L. DATUM: ____ THETA ANGLE: ____ DRAWN BY: LANCE HABECH BASIS FOR MONUMENT LOCATION Show info such as: History of corner, with reference to Vol. and pg., dates, surveyor; exact description of monument replaced; if location computed, by taped or EDM traverse; landowner remarks, etc. (Use reverse side if necessary) ANTHONY B. KIEDRO LOCATION SEAL: ABK dug with backhoe and found three posts next to each other. **e**xtensive EDM/T2 traverse was run to determine search areas in the vicinity. This spot was monumented with a standard Harrison monument. Wis. DATA SHOWN HERE ON CERTIFIED CORRECT: Androw & Ko Registered Land Surveyor DATE: S VISSER 7/5/90 NEXT PAGE TIE SKETCH Show at least four ties, also fence lines, roads, topo, size and type of witness trees' and if off road - best way to BLUE PAINT arrive at corner. CROSS, TOP CENTER WEST END Ties to nail and bottle cap. DITCH AR TIE CORNER POST MAINTENANCE RECORD Date Remarks Init. 1"IF 6.23.8z PK-SS 0,5 GR- 55 2-9-87 OK New TIES GROHOLSKI 1/11/00 1-04-02

REVISED 1977

Government Land Corner Certificate 65 CORNER NO. ADAMS County 21 SECTION HARRISON TYPE OF MONUMENT: _ 19N TOWN STATE PLANE COORDINATES: 7E RANGE \mathbf{F}_{-} ELEVATION - M.S.L. DATUM: __ THETA ANGLE: _____ FIELD BOOK: _ _ PAGE _ DRAWN BY: N.L.VISSERS BASIS FOR MONUMENT LOCATION NORBERT L. VISSERS S-1821 BOULDEP Show info such as: History of corner, with reference to Vol. and pg., dates, surveyor; exact description of monument replaced; if location computed, by taped or EDM traverse; landowner remarks, etc. (Use reverse side if necessary) I accepted the location by Kiedrowski. The Southwest and Southeast Aspen trees were dead. The Northwest and Northeast ties were found as recorded. I rereferenced as shown below. DATA SHOWN HERE ON CERTIFIED CORRECT: Registered Land Surveyor July 5, 1990 DATE: ___ 5th Ave. TIE SKETCH Show at least four ties, also fence lines, roads, topo, size and type of witness trees' and if off road - best way to arrive at corner. Found RR Tie Cor. Post Found Culvert w/Painted X

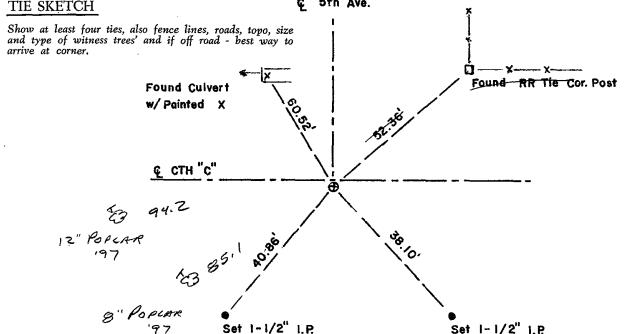

MAINTENANCE RECORD

DATE	BY WHOM	REMARKS		
12-20-97		ok		
	<u></u>			
	· · · · · · · · · · · · · · · · · · ·			