# ADAMS COUNTY COUNTY CORNER NO: 39 ROMPORTOL ID: 42005112000


## PUBLIC LAND SURVEY MONUMENT RECORD

TYPE OF MONUMENT:	COTTON GIN SPINDLE
ADAMS COUNTY COORDIN	ATES, NAD 83 (2007)
N_ 311340.845	
E. 520238.613	
ELEVATION	DATUM <del></del>
FIELD MODE DATE: 06/04/2018	


### BASIS FOR MONUMENT LOCATION

1973- PLS 878 REPLACED RAILROAD SPIKE FOUND AND BELIEVED SET BY WM. ROHDE IN A SURVEY HE DID IN SECTION 12. LOCATION ACCEPTED AFTER A TRAVERSE OF THE NORTH 1/2 OF SECTION 11. REPLACED RR SPIKE WITH A HARRISON MONUMENT AND TIED OUT.

2018- PLS 2994 FOUND COTTON GIN SPINDLE 2" BELOW THE ROAD SURFACE, 2 WITNESSES AND 1 TIE. REMOVED THE COTTON GIN SPINDLE AND FOUND NO EVIDENCE OF ANY ADDITIONAL MONUMENTS BELOW. THE COTTON GIN SPINDLE LOCATION AGREES WITH THE EXISTING WITNESSES AND TIE. ACCEPTED THE COTTON GIN SPINDLE LOCATION AS THE CORNER. RE-SET THE COTTON GIN SPINDLE AT THE CORNER LOCATION. SET 4 NEW TIES AND MEASURED TO THE TIES AND WITNESSES.

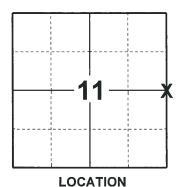

(INDICATE CORNER BY "X")

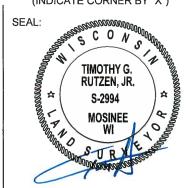

DATA SHOWN HERE ON THIS TIE SHEET IS CORRECT AND COMPLETE TO THE BEST OF MY KNOWLEDGE AND BELIEF.

PROFESSIONAL LAND SURVEYOR


DATE \_ 7-18-18

#### -TIE SKETCH

NOTE: THE CORNER FALLS 5'± NORTH OF THE CENTERLINE OF ALPINE DRIVE AND 6'± WEST OF THE CENTERLINE OF 15TH AVE.



- SET 3/4" x 18" IRON REBAR, 1.50#/FT
- FOUND 1-1/4" O.D. IRON PIPE
- **COTTON GIN SPINDLE**
- WITNESS POWER POLE
- VINYL "T" POST

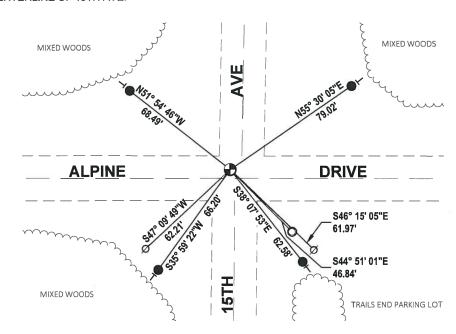


## ADAMS COUNTY

## Survey Monument Record

TYPE OF MONUMENT: 30" HARRISON STATE PLANE COORDINATES: N\_

ELEVATION - M.S.L. DATUM: \_ THETA ANGLE: \_

FIELD BOOK: \_\_\_\_\_ PAGE \_\_\_\_

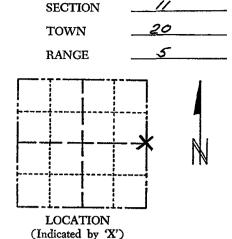

CORNER NO. \_303

SEAL:

## BASIS FOR MONUMENT LOCATION

(Use reverse side if necessary)

Show info such as: History of corner, with reference to Vol. and pg, dates, surveyor; exact description of monument replaced; if location computed, by taped or EDM traverse; landowner

Replaced railroad spike found and believed set by Wm. Rohde in a survey he did in Sec. 12. Location accepted after a traverse of the N1/2 of Sec. 11.


See the reverse side for the updated map Nov. 11, 1983

00 77-5-29 35-50 CERTIFIED CORRECT: Andhon 7 B. Ku chowa Registered Land Surveyor DATE: 9/18/73

#### TIE SKETCH

(Show at least four ties) STOP SIGN D Q C.T.H. "D" ALL TIES ARE TO NAIL PRISC ALL TREES ARE BLAZED و<sup>ر-</sup> ريم POWER

REVISED 1972

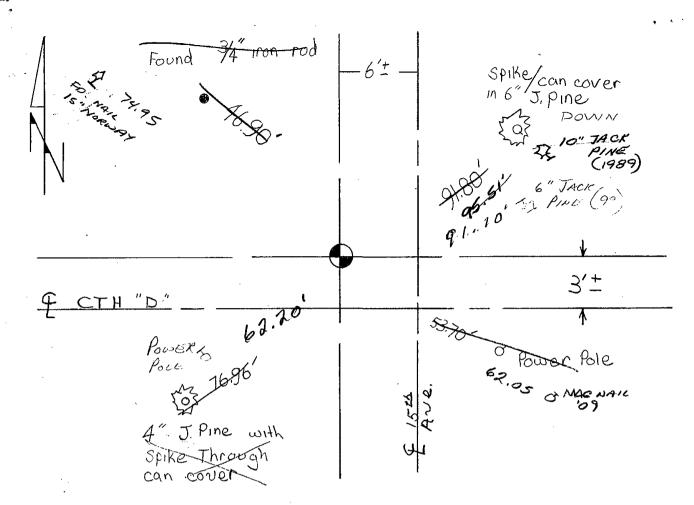

Map updated on Nov. 11, 1983 Ken Carlson

/ NEW TIE 6-12-89 MK.55 DK 3MARCH 94 CR-19

2-GONE, 2-NEW, 2-16-99-J6-55 OK, 2-26-04-JG

2 NEW TIES - FO 1/2" SPLINED? NAIL? FITS TIES SWENE

\* \*