# 06 ADAMS COUNTY COUNTY CORNER NO: 71 ROMPORTOL ID: 42006140000

## PUBLIC LAND SURVEY MONUMENT RECORD

HARRISON (BROKEN-TOP) TYPE OF MONUMENT: ADAMS COUNTY COORDINATES, NAD 83 (2007) N. 303622.973 E. 551750.433 ELEVATION- - - DATUM


## BASIS FOR MONUMENT LOCATION

FIELD WORK DATE:\_


05/08/2018

1977 - PLS 878 RAN TRAVERSE AROUND SECTIONS 36, 25 AND PARTS OF ADJOINING SECTIONS TO DETERMINE SEARCH AREA FOR INVESTIGATION, EXCAVATION WITH A BACKHOE AT CORNER BY ANTHONY B. KIEDROWSKI, ADAMS COUNTY SURVEYOR, YIELDED THE BOTTOM 12" OF A 3" DIAMETER POINTED WOOD POST IN VERY ROTTED CONDITION. POST HAD BEEN SET BY ORIGINAL GOVERNMENT SURVEYOR. REPLACED THE POST WITH A HARRISON MONUMENT ON NOV. 9, 1977 AND TIFD OUT.

2018 - PLS 2994 FOUND A HARRISON MONUMENT WITH A BROKEN-TOP 18" BELOW THE ROAD SURFACE, FOUND NO EVIDENCE OF ANY OF THE WITNESSES, ACCEPTED THE HARRISON MONUMENT WITH A BROKEN-TOP AS THE BEST EVIDENCE OF THE CORNER LOCATION. SET 4 NEW TIES AND MEASURED TO THE TIES.

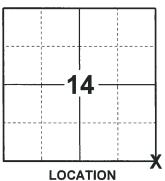

(INDICATE CORNER BY "X")

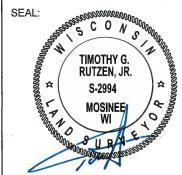

DATA SHOWN HERE ON THIS TIE SHEET IS CORRECT AND COMPLETE TO THE BEST OF MY KNOWLEDGE AND BELIEF.


PROFESSIONAL LAND SURVEYOR

7-18-18

## -TIE SKETCH

NOTE: THE CORNER FALLS 3'± WEST OF THE CENTERLINE OF 8TH AVE AND 6'± SOUTH OF THE CENTERLINE OF APACHE AVE.



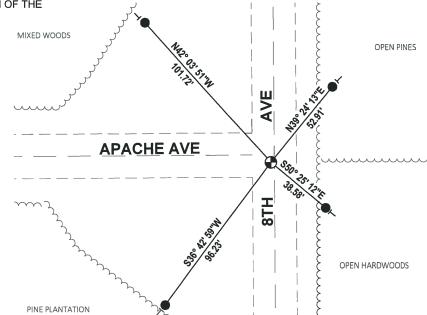

- SET 3/4" x 18" IRON REBAR, 1.50#/FT
- FOUND HARRISON MONUMENT
- VINYL "T" POST

## **Government Land Corner Certificate**

A DAMS County	
TYPE OF MONUMENT: <u>HARRISON</u> STO.  STATE PLANE COORDINATES: N	<del></del> -
E	<del></del>
ELEVATION — M.S.L. DATUM:	
FIELD BOOK: 57 (101) PAGE 39 ( DRAWN BY: Scott SORENSEN	

## BASIS FOR MONUMENT LOCATION

Show info such as: History of corner, with reference to Vol. and pg., dates, surveyor; exact description of monument replaced; if location computed, by taped or EDM traverse; landowner remarks, etc. (Use reverse side if necessary)

Ran EDM/T2 traverse around Sections 36, 25 and parts of adjoining sections to determine search area for investigation.

Excavation with backhoe by Anthony B.
Kiedrowski, Adams County Surveyor, yielded
bottom 12" of 3" diameter pointed wood
post in very rotted condition. Post had been
set by Original Government Surveyor.

Replaced post with Harrison Monument on Nov. 9, 1977.


see the reverse side for the updated map 4-19-84

 CORNER NO.
 7/

 SECTION
 24

 TOWN
 20

 RANGE
 6

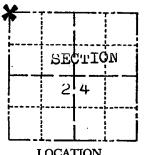

A

LOCATION
(Indicated by 'X')
L:

ANTHONY B.
KIEDROWSKI
S-878
Wisconsin Rapids.
Wis.

DATA SHOWN HERE ON CERTIFIED CORRECT:

SEAL:

Registered Land Surveyor

DATE: December 27, 1977

## TIE SKETCH


Show at least four ties, also fence lines, roads, topo, size and type of witness trees' and if off road - best way to arrive at corner.


#### NOTE

Ties in trees to nail in disc.

## MAINTENANCE RECORD

Date	Init.	Remarks
4-13-79	JSK-SZ	0 K
13-07-94	66.65	DIC
1-11-99	J6-JF	OK
2-24-04	JG	OK MAGNAIL @ CORNER
3-04-09	SE	2 NEW TIES TO MAG

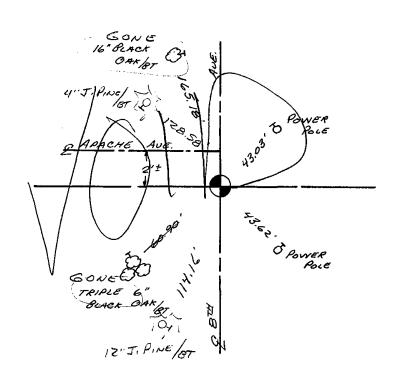

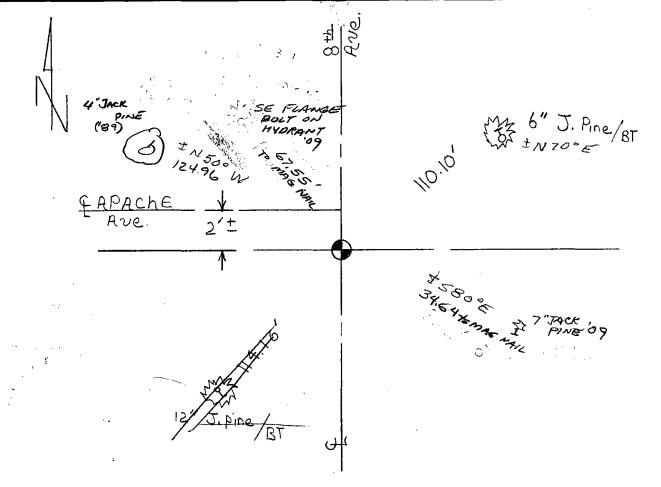

2 new ties were set on 4-19-84 DK-SS