

34
SECTION

20
TOWN

07
RANGE

ADAMS COUNTY

COUNTY CORNER NO: 118

ROMPORTOL ID: 42007342000

PUBLIC LAND SURVEY MONUMENT RECORD

TYPE OF MONUMENT: HARRISON
ADAMS COUNTY COORDINATES, NAD 83 (2007)

N. 290559.561

E. 578012.984


ELEVATION- DATUM

FIELD WORK DATE: 03/11/2020

BASIS FOR MONUMENT LOCATION

1979 - PLS 1478 ABK EXCAVATED WITH BACKHOE AND FOUND NO EVIDENCE OF ANY PREVIOUS MONUMENTATION. THIS POINT WAS SET EQUIDISTANT AND ON LINE BETWEEN ADJACENT SECTION CORNERS.

2020 - PLS 2675 FOUND HARRISON 4"± BELOW THE ROAD SURFACE AND 2 WITNESSES. THE MONUMENT AGREES WITH BOTH WITNESSES. ACCEPTED THE HARRISON AS THE CORNER LOCATION. SET 4 NEW TIES AND MEASURED TO THE EXISTING WITNESSES.

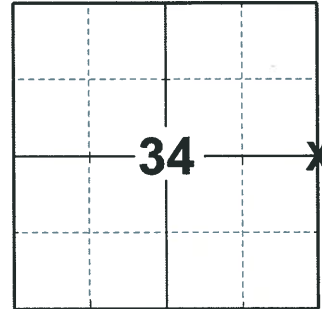

LOCATION

(INDICATE CORNER BY "X")

SEAL:




DATA SHOWN HERE ON THIS TIE SHEET IS CORRECT AND COMPLETE TO THE BEST OF MY KNOWLEDGE AND BELIEF.

PROFESSIONAL LAND SURVEYOR

DATE 3/25/2020

- TIE SKETCH

NOTE: THE CORNER LANDS 5.2'± WEST OF 3RD AVE. CENTERLINE

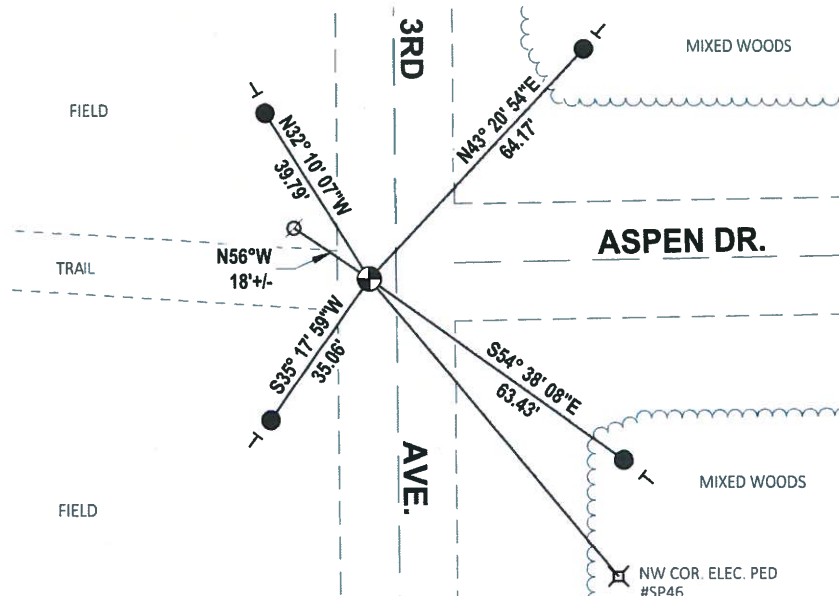


- SET 3/4" x 18" IRON REBAR, 1.50#/FT
- ⊕ FOUND HARRISON MONUMENT
- ⊙ WITNESS POWER POLE
- ┌ VINYL "T" POST

Government Land Corner Certificate

ADAMS County
 TYPE OF MONUMENT: HARRISON STANDARD
 STATE PLANE COORDINATES: N _____
 E _____
 ELEVATION — M.S.L. DATUM: _____
 THETA ANGLE: _____
 FIELD BOOK: 64 PAGE 134
 DRAWN BY: JOHN S. KEDROWSKI

CORNER NO. 118
 SECTION 34
 TOWN 20 N
 RANGE 7 E

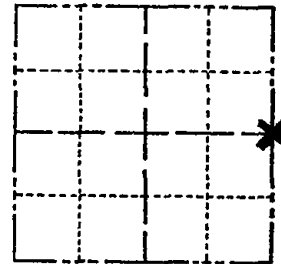

LOCATION
(Indicated by 'X')


BASIS FOR MONUMENT LOCATION

Show info such as: History of corner, with reference to Vol. and pg., dates, surveyor; exact description of monument replaced; if location computed, by taped or EDM traverse; landowner remarks, etc. (Use reverse side if necessary)

ABK excavated with backhoe and found no evidence of any previous monumentation.
 This point was set equidistant and on line between adjacent section corners.

See the reverse side for the updated map 4-30-84

SEAL:

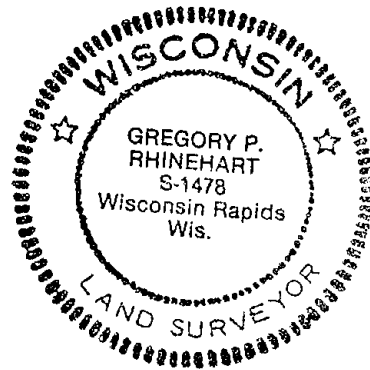


DATA SHOWN HERE ON
 CERTIFIED CORRECT:

Gregory P Rhinehart
 Registered Land Surveyor

DATE: 3 / 23 / 79


TIE SKETCH

Show at least four ties, also fence lines, roads, topo, size and type of witness trees and if off road - best way to arrive at corner.

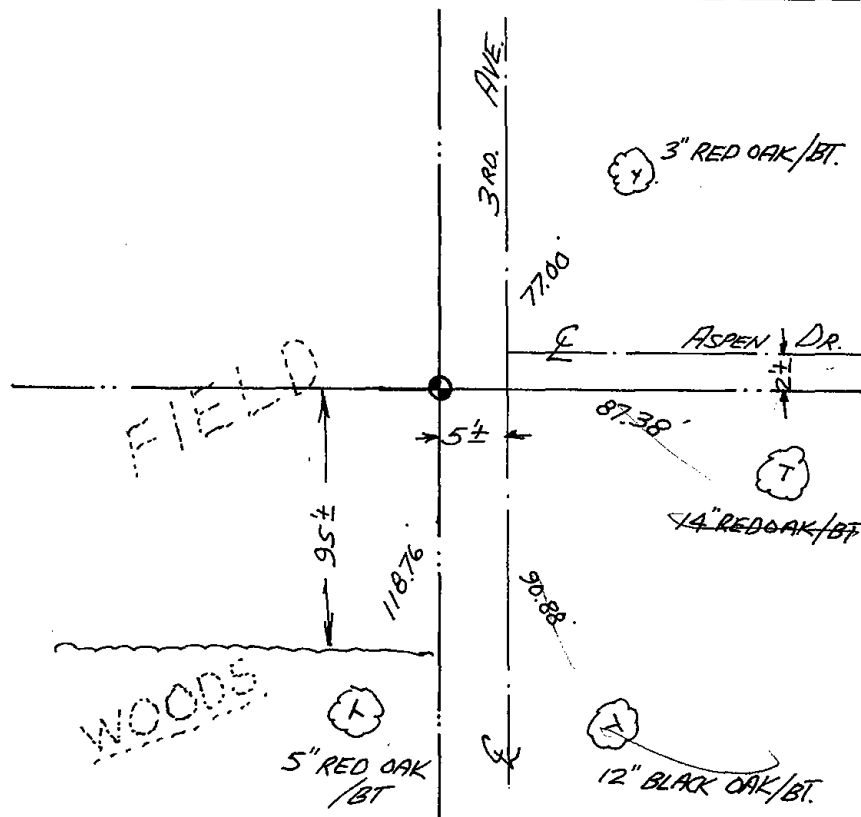

MAINTENANCE RECORD

Date	Init.	Remarks

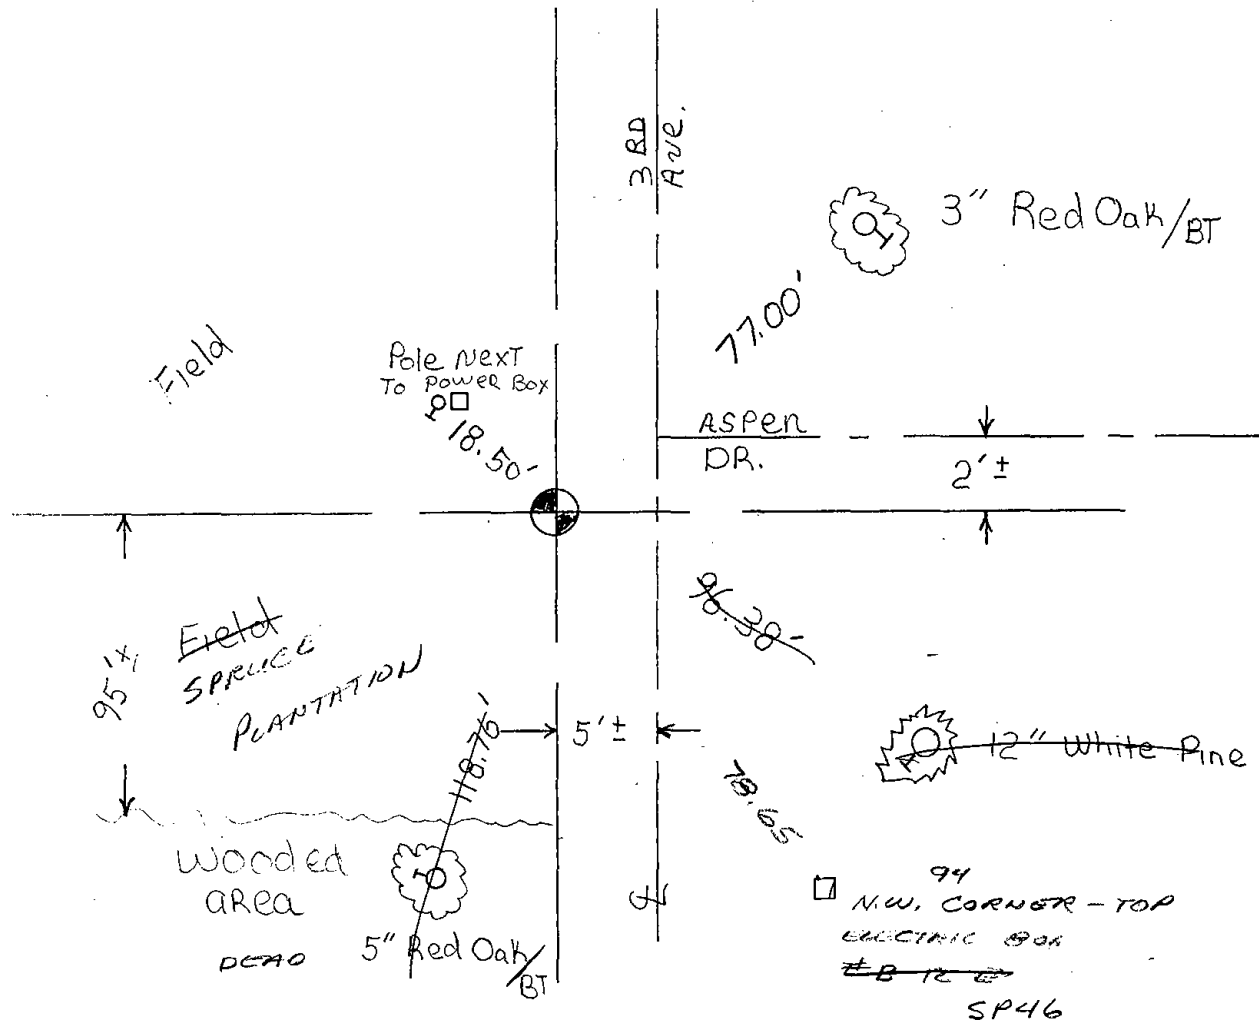

Map updated and new ties were set on 4-30-84 SS-DK

ADD. 1 NEW 3-21-94 JG-SS

OK 2-12-99 - JG

MAR 3 3 TIES OK 7-6-04 SS NOTHING AVAILABLE

" " 2-06-09 SS