SECTION

D6 ADAMS COUNTY

COUNTY CORNER NO: 122 ROMPORTOL ID: 41506310020


PUBLIC LAND SURVEY MONUMENT RECORD

TYPE OF MONUMENT: ADAMS COUNTY COORDINATES, NAD 83 (2007) N. **132918.942** E. 528739.146 DATUM **ELEVATION-**FIELD WORK DATE: 10/31/2017


BASIS FOR MONUMENT LOCATION

1976 - PLS 1191 RESEARCHED GOV'T AND COUNTY SURVEYOR'S RECORD. FOUND NOTHING ON RECORD AS CORNER BEING SET. FOUND SURVEY FROM 1874 BY WISE, IN VOL. 2, PG. 110. FOUND EVIDENCE OF THE FIRST BEARING TREE, A ROTTEN STUMP THAT FIT THE FENCE CORNER FOR BEARING AND DISTANCE. ALSO FOUND A ¾" X 24" ROD AT THE FENCE CORNER FROM ELMEN OWENS SURVEY PROJECT # 6314. SET A HARRISON MONUMENT AT THE CORNER LOCATION AND TIED OUT.

2017 - PLS 2994 FOUND A HARRISON MONUMENT FLUSH WITH THE GROUND SURFACE AND 2 WITNESS TREES. THE MONUMENT AGREES WITH THE EXISTING WITNESS TREES. ACCEPTED THE HARRISON MONUMENT AS THE CORNER LOCATION. SET 4 NEW TIES AND MEASURED TO THE TIES AND WITNESS TREES.

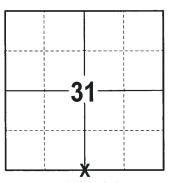

LOCATION (INDICATE CORNER BY "X")

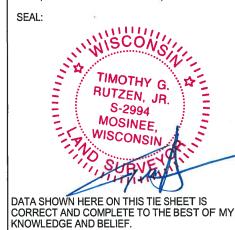

PROFESSIONAL LAND SURVEYOR

DATE


– TIE SKETCH

NOTE: THE CORNER FALLS 31'± NORTHEAST OF THE CENTERLINE OF THE TRAIL.



- 3/4" x 18" IRON REBAR SET, 1.50#/FT → HARRISON FOUND

- → VINYL "T" POST
- $\mathbb{P}^{\mathbb{N}}$ WITNESS TREE STUMP FOUND
- WITNESS TREE FOUND

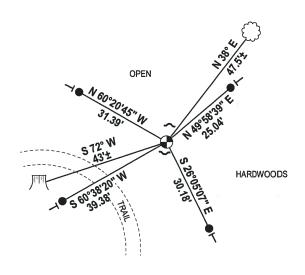

ADAMS COUNTY	CORI	ver no. <u> </u>	
Survey Monument Record	SECT	1	
TYPE OF MONUMENT: HARRISON	TOW	N 14 N	
STATE PLANE COORDINATES: N	RANG	GE <u>6 E</u>	
E .	 	*	
ELEVATION — M.S.L. DATUM:			4
THETA ANGLE: PAGE	1	-	1
PAGEPAGE	├ -	\$- -	U
BASIS FOR MONUMENT LOCATION			
(Use reverse side if necessary)	<u> </u>	<u> </u>	
Show info such as: History of corner, with reference to Vol. and pg, dates, surveyor; exact description of monument replaced; if location computed, by taped or EDM traverse; landowner remarks, etc.	SEAL: (Indicate	ATION d by 'X')	
Researched Gou'T & COUNTY SURVEYOR'S	Wise State	SCONSINI	
Records, Found Nothing on Accord AS D	ernig griffy	A The	<u>.</u>
SET. Found Survey made in 1874 by	Wise	ALLEN D. Y	
in Vol. 2, bg. 110 BIK Pine 16" N9°E 37 1, " ", 15" 534 2 W 23	uks 3	BARABOD,	Main
Found evidence of first Bearing fre	that the	WIR.	Ş
Above Mentioned from Rotted Stump	11.	Edu	
Pir the Lence corner for bearing &	die sin	SURVINIO	
FIT THE FEWER CORNER / OR DEARING G			
Also Sound 34424" Rod AT Lence con	ver		
Also Sound 34424" Rod AT Sence con Prom Elmen Owens survey Pros #6	vek	***************************************	
Also Lound 34424" Rod AT Lence con PROM Elmen Owens SURVEY PROF #6. Ser HARRISON MONUMENT AT This	vek	ECT:	
Also Sound 34424" Rod AT Sence con PROM Elmen Owens survey Prog #6. Set HARRISON MONUMENT AT This location	CERTIFIED CORR	. Roll	···
Also Sound 34424" Rod AT Sence COAD PROM Elmen Owens SURVEY PROF #6. SET HARRISON MONUMENT AT This LOCATION TAPE TRAVERSE	CERTIFIED CORR Segistered Land Surv	eyor eyor	
Also Sound 34424" Rod AT Sence con PROM Elmen Owens survey Prog #6. Set HARRISON MONUMENT AT This location	CERTIFIED CORR	eyor eyor	
Also Lound 34424" Rod AT Lence conf PROM Elmen Owens survey Prof #6. SET HARRISON MONUMENT AT This location TAPE TRAVERSE CORNER O.K. 12/22/81 O.W-SK TIE SKETCH CORNER OK 10-29-90 JG	CERTIFIED CORR Description	eyor eyor	
Also Sound 34424" Rod AT Sence CORP PROM Elmer Owens Survey Prof #6. Set HARRISON MONUMENT AT This location Tape Travers. CORNER O.K. 12/22/81 O.W.SK TIE SKETCH LORNER OK 10-29-90 JG (Show at least four ties) 2-60NE, 2-NEW TIES, MON. DK, 3-7-01 JG-M	CERTIFIED CORR Registered Land Surv DATE:	eyor 7C	
Also Sound 34424" Rod AT Sence CORP. PROM Elmen Owens survey Prof #6. SET HARRISON MONUMENT AT This location Tape Traverse CORNER O.K. 12/22/81 D.W.SK TIE SKETCH LORNER OK 10-29-90 JG	CERTIFIED CORR CERTIFIED CORR Registered Land Surv DATE:6-7-	eyor 76	
Also Sound 34424" Rod AT Sence CORP PROM Elmer Owens Survey Prof #6. Set HARRISON MONUMENT AT This location Tape Travers. CORNER O.K. 12/22/81 O.W.SK TIE SKETCH LORNER OK 10-29-90 JG (Show at least four ties) 2-60NE, 2-NEW TIES, MON. DK, 3-7-01 JG-M	CERTIFIED CORR Registered Land Surv DATE:	eyor 76	4
Also Sound 34424" Rod AT Sence CORP PROM Elmer Owens survey Prof #6 SET HARRISON MONUMENT AT This location Tape Traverse CORNER O.K. 12/22/81 O.W.SK TIE SKETCH LORNER OK 10-29-90 JG (Show at least four ties) 2-60NE, 2-NEW TIES MON. DK, 3-7-01 JG-M ALL OK, 10-30-06-JG 10" POPLAR	CERTIFIED CORR Registered Land Surv DATE:G-7-	eyor 76	
Also Sound 34424" Rod AT Sence CORN PROM Elmer Owens Survey Prof #6 Set Harrison Monument At This location Tape Travers CORNER O.K. 12/22/81 O.W.SK TIE SKETCH LORNER OK 10-29-90 JG (Show at least four ties) 2-60NE, 2-NEW TIES, MON. OK, 3-7-01 JG-M ALL OK, 10-30-06-JS 10" POPLAR 10" POPLAR	CERTIFIED CORR Registered Land Surv DATE:	eyor 76	
Also Sound 34424" Rod AT Sence CORP PROM Elmer Owens Survey Prof #6 Set HARRISON MONUMENT AT This location Tape Traverse CORNER O.K. 12/22/81 O.W.SK TIE SKETCH LORNER OK 10-29-90 JG (Show at least four ties) 2-60NE, 2-NEW TIES MON. DK, 3-7-01 JG-M ALL OK, 10-30-06-D 10" POPLAR	CERTIFIED CORR Registered Land Surv DATE:G-7- 12" O AK GONE DEAD + LEANING	eyor 76	
Also Sound 34424" Rod AT Sence CORN PROM Elmer Owens Survey Prof #6 Set Harrison Monument At This location Tape Travers. CORNER O.K. 12/22/81 O.W.SK TIE SKETCH LORNER OK 10-29-90 JG (Show at least four ties) 2-60NE, 2-NEW TIES, MON. OK, 3-7-01 JG-M ALL OK, 10-30-06-JS 10" POPLAR 10" POPLAR 10" POPLAR 10" POPLAR	CERTIFIED CORR Registered Land Surv DATE: 6-7- 12" O AK GONE DÉAD + LEANING 8" WHIT	eyor 76	
A/30 Sound 34424" Rod AT Sence CORP PROM Elmen Owens SURVEY Prof #6 SET HARRISON MONUMENT AT THIS JOCATION TAPE TRAVERS. CORNER O.K. 13/23/81 D.W.SK TIE SKETCH LORNER OK 10-29-90 JG (Show at least four ties) 2-60NE, 2-NEW TIES, MON. DK, 3-7-01 JG-M ALL OK, 10-30-06-JG 10" POPLAR 10"	CERTIFIED CORR Registered Land Surv DATE:G-7- 12" O AK GONE DEAD + LEANING	eyor 76	
A/30 Sound 34424" Rod AT Sence CORP PROM Elmen Owens SURVEY Prof #6 SET HARRISON MONUMENT AT THIS JOCATION TAPE TRAVERS. CORNER O.K. 13/23/81 D.W.SK TIE SKETCH LORNER OK 10-29-90 JG (Show at least four ties) 2-60NE, 2-NEW TIES, MON. DK, 3-7-01 JG-M ALL OK, 10-30-06-JG 10" POPLAR 10"	CERTIFIED CORR Registered Land Surv DATE: 6-7- 12" O AK GONE DÉAD + LEANING 8" WHIT	eyor 76	
Also Sound 34424" Rod AT Lence EORI PROM Elmen Owens SURVEY PROF #6. SET HARRISON MONUMENT AT THIS LOCATION TAPE TRAVENSE CORNER O.K. 19/29/81 O.W-SK THE SKETCH LORNER OK 10-29-90 JG (Show at least four ties) 2-60NE, 2-NEW TIES MON. OK, 3-7-01 JG-M ALL OK, 10-30-06-JG 10" POPLAR "METHU POST OF CRIVER NITH NETHU POST OF CRIVER NITH 16. 68	CERTIFIED CORR Registered Land Surv DATE: 6-7- 12" O AK GONE DÉAD + LEANING 8" WHIT	eyor 76	
A/SO Sound 34424" Rod AT Sence cons PROM Elmen Owens SURVEY Prof #6. SET HARRISON MONUMENT AT This loc A TION TAPE TRAVERS. CORNER OK. 13/22/81 O.W.SK TIE SKETCH (ORNER OK 10-29-90 JG (Show at least four ties) 2-60NE, 2-NEW THES, MON. DK, 3-7-01 JG-M ALL OK, 10-30-06-JG 10" POPLAR 10	CERTIFIED CORR Registered Land Surv DATE: 6-7- 12" O AK GONE DÉAD + LEANING 8" WHIT	eyor 76	
Also Sound 34424" Rod AT Lence EORI PROM Elmen Owens SURVEY PROF #6. SET HARRISON MONUMENT AT THIS LOCATION TAPE TRAVENSE CORNER O.K. 19/29/81 O.W-SK THE SKETCH LORNER OK 10-29-90 JG (Show at least four ties) 2-60NE, 2-NEW TIES MON. OK, 3-7-01 JG-M ALL OK, 10-30-06-JG 10" POPLAR "METHU POST OF CRIVER NITH NETHU POST OF CRIVER NITH 16. 68	CERTIFIED CORR Registered Land Surv DATE: 6-7- 12" O AK GONE DÉAD + LEANING 8" WHIT	eyor 76	
A/SO Sound 34424" Rod AT Sence cons PROM Elmen Owens SURVEY Prof #6. SET HARRISON MONUMENT AT This loc A TION TAPE TRAVERS. CORNER OK. 13/22/81 O.W.SK TIE SKETCH (ORNER OK 10-29-90 JG (Show at least four ties) 2-60NE, 2-NEW THES, MON. DK, 3-7-01 JG-M ALL OK, 10-30-06-JG 10" POPLAR 10	CERTIFIED CORR Registered Land Surv DATE: 6-7- 12" O AK GONE DÉAD + LEANING 8" WHIT	eyor 76	
A/SO Sound 34424" Rod AT Sence cons PROM Elmen Owens SURVEY Prof #6. SET HARRISON MONUMENT AT This loc A TION TAPE TRAVERS. CORNER OK. 13/22/81 O.W.SK TIE SKETCH (ORNER OK 10-29-90 JG (Show at least four ties) 2-60NE, 2-NEW THES, MON. DK, 3-7-01 JG-M ALL OK, 10-30-06-JG 10" POPLAR 10	CERTIFIED CORR Registered Land Surv DATE: 6-7- 12" O AK GONE DÉAD + LEANING 8" WHIT	eyor 76	