SECTION

FIELD WORK DATE:

## OB ADAMS COUNTY

COUNTY CORNER NO: 123

ROMPORTOL ID: 41506310000

## PUBLIC LAND SURVEY MONUMENT RECORD


**HARRISON (BROKEN-TOP)** TYPE OF MONUMENT: ADAMS COUNTY COORDINATES, NAD 83 (2007) N. **132928.957** E. 531365.284 DATUM

10/03/2017

## BASIS FOR MONUMENT LOCATION

1975 - PLS 1191 RESEARCHED OLD RECORDS AND FOUND NOTHING AS BEING SET BY ADAMS 1975 - PLS 1191 RESEARCHED OLD RECORDS AND FOUND NOTHING AS BEING SET BY ADAMS SURVEYORS. FOUND EXISTING MASONRY NAIL SET BY DEAN JESSES (FAWN LAKE PROJ.) BUT COULD NOT FIND BEARING TREES SET BY STUNTZ AND SARGENT FROM WHEN THE BOUNDARY WAS RUN OUT. A. J. BARRETT SURVEYED 13TH AVE. IN 1902 AND USED THE CENTERLINE OF THE ROAD TO THE EAST, KNOWN THEN AS TOWN LINE ROAD TO ESTABLISH THE CORNER BUT DID NOT SET ANYTHING AT THE CORNER. MEASURED WEST FROM THE MASONRY NAIL TO THE N1/4 OF SECTION 6 AND FOUND THE NAIL TO BE SET TOO FAR EAST. SET A HARRISON MONUMENT 12.36' WEST OF THE MASONRY NAIL AND 2' WEST OF THE WESTERLY EDGE OF PAVEMENT.

2017 - PLS 2994 FOUND A HARRISON MONUMENT WITH A BROKEN-TOP 6" BELOW THE SURFACE, 1 PROPERTY IRON USED AS A TIE AND 3 WITNESSES. THE MONUMENT AGREES WITH THE EXISTING PROPERTY IRON AND WITNESSES. ACCEPTED THE HARRISON MONUMENT WITH THE BROKEN-TOP AS THE CORNER LOCATION. SET 3 NEW TIES AND MEASURED TO THE TIES, PROPERTY IRON AND WITNESSES.

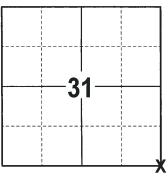

LOCATION (INDICATE CORNER BY "X")



DATA SHOWN HERE ON THIS TIE SHEET IS CORRECT AND COMPLETE TO THE BEST OF MY KNOWLEDGE AND BELIEF.

PROFESSIONAL LAND SURVEYOR

DATE


## - TIE SKETCH

NOTE: THE CORNER FALLS 11'± WEST OF THE CENTERLINE OF 13TH AVE AND 1'± SOUTH OF THE CENTERLINE OF GALE AVE.



- 3/4" x 18" IRON REBAR SET, 1.50#/FT 3/4" IRON ROD FOUND HARRISON (BROKEN-TOP) FOUND

WITNESS SIGN d STEEL FENCE POST VINYL "T" POST

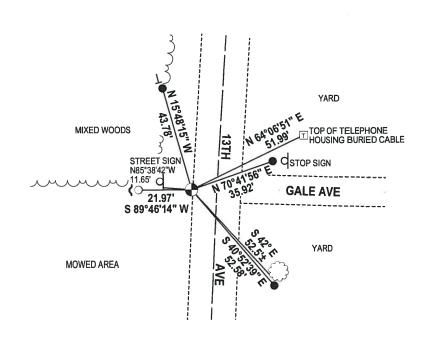

111111000	LUNTY					CORN	er no. <u>8</u>	39
ADAMS COUNTY Survey Monument Record						SECTI		5
Lower and						TOWN	4.5	+N
TYPE OF MONUM	AENI:	711		_		RANG	6	SE
SIAIE PLAINE (	COORDINATES: N			<del>-</del>	r.	A	31	
ELEVATION — M	I.S.L. DATUM:			<del></del>	יכ		· · · · · · · · · · · · · · · · · · ·	4
THETA ANGLE: _		·						-
FIELD BOOK:	<u>501</u> F	AGE _	18	_	15	<u>_</u>	k11	NI
					ر <del>-</del> -			N
BASIS FOR MOI	NUMENT LOCAT	ION						
(Use reverse side if necessary)					25	<u></u>	<sub>21</sub> ـــا <sub>21</sub>	1
Show info such as: History of corner, with reference to Vol. and pg, dates, surveyor; exact description of monument replaced;					-	LOCA (Indicated		•
and pg, dates, survey if location computed remarks, etc.	or; exact description of a	nonume: traverse;	nt replaced; landowner		SEAL:	(Indicated	by 'A.)	
A.J. Ba east, known t anything at c	ed west from to be set to fa of masonry na	ed 1; Line Mason ar ea il an	3th Ave. Road to nry nail ast. Set nd 2' wes	establish to N 1/4 Harrison st of	Sec. 6 CERTIFE	ED CORRE	CT:	
CORNER ON	k. 3-31-76 6	عی۔ج،	2-C	-86 OK G	DATE: _	/2-	<u> 75-75</u>	•
MON AN TIES	t. 3-31-76 6 0.K 10/12/81	<u>TH-1</u>	LC WRNER				7.1 1.1.5015	
	TIE SKETCH		, , -			93-NC	W, 1-GONE,	
		! }	coe			FOK 7-5-	11 55	10-30-06
	ties)		أسيبها	* MALDE	3/5/0,	POK 7-5-	// <u>SS</u>	10-30-66
TIE SKETCH (Show at least four		AVE.	أسيبها		3/5/0,	OR 7-5-	// <u>\$\$</u>	10-30-66
TIE SKETCH	WOODS	13 th AVE.	ALL 0	An to sec	3/5/0,	OR 7-5-	<i>,,, ,,,,,,,,,,,,,,,,,,,,,,,,,,,,,,,,,</i>	10-30-66
TIE SKETCH (Show at least four	WOODS DOU BLAZED 20" DIA BURK OAK	© 13 th AVE.	ALL 0	An to sec	3/5/0,	aintained by 2-2-6	// <u>\$</u> \$	10-30-b
SEC. 31	WOODS  DOU BLAZED 20*  DIA BURR OAK  W/NAIL 8 SHINER	G 13 th AVE.	FIELD Solution	MINITAL MANAGEMENT AND SEC	3/5/6, ; . <b>32</b>	OR 7-5-	<i>,,,</i>	10-30-b6
TIE SKETCH (Show at least four SEC. 31	WOODS DOU.BLAZED 20" DIA. BURR OAK	94 2 C 13 th AVE.	ALL 0	MINITAL MANAGEMENT AND SEC	3/5/6, . 32 318.18 <sup>1</sup>	aintained by 2-2-6	// <i>SS</i> .	10-30-be
SEC. 31	WOODS  DOU, BLAZED 20"  DIA. BURR OAK  W/ NAIL & SHINED  NE'LY SIDE 5" BURK  GLACK C 33 30.	40	FIELD  FIELD  FOP OF TE  HOUSING E  CABLE	Paried Williams	3/5/6, . 32 318.18 <sup>1</sup>	aintained by 2-2-6	// <i>SS</i> .	10-30-06 N
TIE SKETCH  (Show at least four SEC. 31	WOODS  DOU, BLAZED 20" DIA. BURR OAK W/ NAIL & SHINER NE'LY SIDE 5" BURR JOAK 33 3AK 313.87" 344 800 322.00	40	FIELD  FIELD  FIELD  FOR ON S  TOP OF TE  HOUSING E  CABLE  PK. NAIL	Per SEC	3/5/6, . 32 318.18 <sup>1</sup>	aintained by 2-2-6	// <i>SS</i> .	10-30-06 N
SEC. 31	WOODS  DOU, BLAZED 20"  DIA. BURR OAK  W/NAIL & SHINEA  NE'LY SIDE 5" BURR  PLACE STAR STAR SON  13.87" 3/4 ROD 22.80,  174" SURVEY ROD 22.80,  174" SURVEY ROD 22.80,	40	FIELD  FIELD  FOP OF TE  HOUSING E  CABLE	SEC SEC SELE BURIED 2636.07'	3/5/5/5/5.32 318.18 <sup>1</sup> 0005	aintained by 2-2-6	// <u>S</u> S .	10-30-06 N
TIE SKETCH  (Show at least four SEC. 31	WOODS  DOU. BLAZED 20"  DIA. BURR OAK  W/NAIL 8 SHINES  NE'LY SIDE 5" BURE  START START SO  13.87" 3/4 80 32.80  174" SURE START SO  174" SURE SO  174" SURE START SO  174" SURE SO  174" SURE SO  174" SURE START SO  174" SURE SO  174" SURE START SO  175" SURE START S	46.46	FIELD  FIELD  FIELD  FOR ON S  TOP OF TE  HOUSING E  CABLE  PK. NAIL	SEC SEC SELE BURIED 2636.07'	3/5/6, . 32 318.18 <sup>1</sup>	HARRI	SON	10-30-06 N
TIE SKETCH  (Show at least four SEC. 31	WOODS  DOU, BLAZED 20"  DIA. BURR OAK  W/NAIL & SHINEA  NE'LY SIDE 5" BURR  PLACE STAR STAR SON  13.87" 3/4 ROD 22.80,  174" SURVEY ROD 22.80,  174" SURVEY ROD 22.80,	46.46	FIELD  FIELD  FIELD  FOR ON S  TOP OF TE  HOUSING E  CABLE  PK. NAIL	SEC SEC SELE BURIED 2636.07'	3/5/5/5/5.32 318.18 <sup>1</sup> 0005	HARRI N.1/4-2	SON.	10-30-06 N
TIE SKETCH  (Show at least four SEC. 31	WOODS  DOU. BLAZED 20"  DIA. BURR OAK  W/NAIL 8 SHINES  NE'LY SIDE 5" BURE  START START SO  13.87" 3/4 80 32.80  174" SURE START SO  174" SURE SO  174" SURE START SO  174" SURE SO  174" SURE SO  174" SURE START SO  174" SURE SO  174" SURE START SO  175" SURE START S	3.41 ch. 84 54 ch. 6	FIELD  FIELD  FIELD  FOR ON S  TOP OF TE  HOUSING E  CABLE  PK. NAIL	SEC. 5 DOUBLE BLA	3/5/ . 32 318.18 - 00DS 18.04 - LE AVE.	HARRI N.1/4-0 SEC. 5	SON.	10-30-06 N
TIE SKETCH  (Show at least four  SEC. 31  1311.50'  2627	WOODS  DOU. BLAZED 20"  DIA. BURR OAK  W/NAIL & SHINED  NE'LY SIDE 5" BURR  33 AK  313.87 34 800 22.00  74 502 22 800  PAINTE MERA  PAI	45 48 H	FIELD  FIELD  FIELD  FOR ON S  TOP OF TE  HOUSING E  CABLE  PK. NAIL	SEC. 5 DOUBLE BLA	3/5/ . 32 318.18 - 00DS 18.04 - LE AVE.	HARRI N.1/4-0 SEC. 5	SON.	10-30-06 N
TIE SKETCH  (Show at least four  SEC. 31  1313.87'  2627	WOODS  DOU. BLAZED 20"  DIA. BURR OAK  W/ NAIL & SHINER  NE'LY SIDE 5" BURE  13.87"  313.87"  34.800 22.00  74"  PASSIDE ME 1.80  PASSIDE ME 1.80  ST. SIGN  ST. SIGN  CONTRACTOR  PASSIDE ME 1.80  PASSIDE ME 1.	T. 18.41 ch. 64 50 mea.	FIELD  FIELD  TOP OF TE HOUSING IE CABLE  PK. NAIL  1318.0	BURIED 2636.07'	3/5/	HARRI N.1/4-0 SEC. 5	SON.	10-30-be
TIE SKETCH  (Show at least four  SEC. 31  1311.50'  2627	WOODS  DOU. BLAZED 20"  DIA. BURR OAK  W/NAIL & SHINED  NE'LY SIDE 5" BURR  33 AK  313.87 34 800 22.00  74 502 22 800  PAINTE MERA  PAI	3.41 ch. 84 54 ch. 6	FIELD  FIELD  TOP OF TE HOUSING IE CABLE  PK. NAIL  1318.0	SEC.5 DOUBLE BLAW, NASWIN NAIL NAIL HE	3/5/	HARRI N.1/4*0 SEC. 5	SON.	<b>4 N</b>
TIE SKETCH  (Show at least four  SEC. 31  1313.87'  2627	WOODS  DOU. BLAZED 20" DIA. BURR - OAK W/ NAIL 8 SHINES NE'LY SIDE 5" BURR 33.87" 34.800 22.80 74" PANDE MERAL PAN	T. 18.41 ch. 64 50 mea.	FIELD  FIELD  FIELD  FLELD  FLELD	SEC.5 DOUBLE BLAN SWELY SIDE WENN NAIL OX IY NAIL BEC.5 P. DOUBLE BLAN SWELY SIDE W. OAK W/NA SWELY SIDE REC.5 P. DOUBLE BLAN	3/5/	HARRI N.1/4*0 SEC. 5	SON FOR. -14-6 West of ]	<b>4</b> N

