OB ADAMS COUNTY

COUNTY CORNER NO: 128 ROMPORTOL ID: 41506340020

PUBLIC LAND SURVEY MONUMENT RECORD

TYPE OF MONUMENT: 1-1/4" IRON ROD ADAMS COUNTY COORDINATES, NAD 83 (2007) N. **132871.854** E. 544514.171


ELEVATION-DATUM — -

09/20/2017 FIELD WORK DATE:


BASIS FOR MONUMENT LOCATION

1975 - PLS 922 FOUND A 3/"X24" IRON ROD SET BY PERSONS UNKNOWN. SET A HARRISON 12' SOUTH OF PRESENT GRADED (½ ROAD WITH NO GRAVEL ON TOP, SAND TRAIL). FIT TRANSIT TAPE TRAVERSE OF THE SECTION GOOD. CHECKED COUNTY SURVEY RECORDS AND THERE WAS NO RESURVEYS ON FILE.

2017 - PLS 2994 FOUND A 1-1/4" IRON ROD 4" BELOW THE GROUND AND 2 WITNESS TREES. THE MONUMENT AGREES WITH THE EXISTING WITNESS TREES. ACCEPTED THE 1-1/4" IRON ROD AS THE CORNER LOCATION. SET 4 NEW TIES AND MEASURED TO THE TIES AND

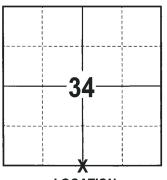

LOCATION (INDICATE CORNER BY "X")

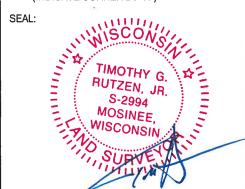

DATA SHOWN HERE ON THIS TIE SHEET IS CORRECT AND COMPLETE TO THE BEST OF MY KNOWLEDGE AND BELIEF.

PROFESSIONAL LAND SURVEYOR


1-15-17

- TIE SKETCH

NOTE: THE CORNER FALLS 18± SOUTH OF THE CENTERLINE OF GALE AVE.



3/4" x 18" IRON REBAR SET, 1.50#/FT 1-1/4" IROD ROD FOUND VINYL "T" POST WITNESS TREE FOUND

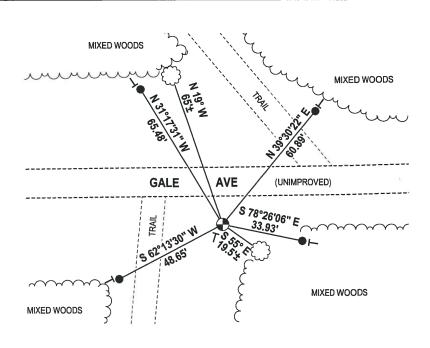

| | | | <u></u> |
|---|---------------------------------------|---|---------|
| ADAMS COUNTY | | CORNER NO. | 737 |
| Survey Monument Record | - | SECTION | · 3 |
| TYPE OF MONUMENT: 30" HARRISON | | TOWN | 14-N |
| STATE PLANE COORDINATES: N | | RANGE . | 6-E |
| <u>E</u> | 1 | · | 7 |
| ELEVATION — M.S.L. DATUM: THETA ANGLE: | | | |
| FIELD BOOK: PAGE | | | |
| BASIS FOR MONUMENT LOCATION | | | |
| (Use reverse side if necessary) | , , , , , , , , , , , , , , , , , , , | LOCATION | |
| Show info such as: History of corner, with reference to Vol. and pg, dates, surveyor; exact description of monument replaced; if location computed, by taped or EDM traverse; landowner remarks, etc. | SEAL: | LOCATION (Indicated by 'X') | |
| FOUND - 3/4" x 24" IRON ROD SET BY PERSONS UNKNOW | /A/ \$ | (Indicated by X') SCONS/N FREDERIC W. ZIETLOW S-922 Baraboo WIS. | Willy. |
| HARRISON SET 12' SOUTH OF PRESENT GRADED | | W . | |
| 12 ROAD NO GRAVEL TOP, SAND TRAIL. FIT | = 3 | ZIETLOW | *= |
| TRANSIT TAPE TRAVERSE OF SECTION GOOD CHECKED CO. SURVEY RECORDS & NO | Ξ' | S-922 | Ξ |
| RESURVEYS ON FILE. | | WIS. | 23 |
| COPNER O.K. 11-14-76 JS-55 | | WIS. | |
| Mon 1 ties O.K 10121181 TH-LC | | William Sokin | ,• |
| 11 OK 10/29/90 JG | | | |
| 11 11 OR 10/29/90 JG | CERTIFII | ED CORRECT: | |
| COR OK 12/6/95 JG-55 | Fred | nie W. Zietlow | ۔ |
| 2-NEW TIES MAN OK 3-20-01 - JG 3-GONE, 3-NEW, MON. OK 10-30-86 - JG | | Land Surveyor JULY 31,19 | 75 |
| TIE SKETCH | | | |
| (Show at least four ties) | | | |
| Course as source from second | Santa y | 3477 11 8.4 | |

