35 SECTION

OF ADAMS COUNTY

COUNTY CORNER NO: 131

ROMPORTOL ID: 41506350000


PUBLIC LAND SURVEY MONUMENT RECORD

TYPE OF MONUMENT:	HARRISON
ADAMS COUNTY COORDINATES, NAD	83 (2007)
N. <u>132902.976</u>	
E. <u>552392.715</u>	
ELEVATION DATUM	
ELEVATION- — — DATUM_	
FIELD WORK DATE: 09/20/2017	
TILLD WORK DATE. OUZOIZOTT	

BASIS FOR MONUMENT LOCATION

2014 - PLS 2443 THE LAST TIE SHEET ON FILE FOR THIS CORNER IS DATED MAY 26, 1976 BY FREDERIC W. ZIETLOW, R.L.S 922. ZIETLOW STATES HE FOUND A POINTED STONE AT THIS CORNER AND REPLACED IT WITH A HARRISON MONUMENT. NUMEROUS NOTATIONS BY OTHER SURVEYORS ALSO APPEAR ON THE TIE SHEET. FOUND THE STANDARD HARRISON CAST IRON MONUMENT AS NOTED BY ZIETLOW AND ESTABLISHED REFERENCE TIES TO PERPETUATE THE CORNER LOCATION.

2017 - PLS 2994 FOUND A HARRISON MONUMENT 6" BELOW THE ROAD SURFACE, 4 TIES, 1 PROPERTY IRON AND 1 WITNESS TREE STUMP. WHILE DIGGING FOR THE HARRISON MONUMENT A LOCAL FARMER STOPPED AND SAID THAT THE CORNER IS AT THE CENTERLINE INTERSECTION. FOUND A ½" IRON ROD AT THIS LOCATION, ORIGIN OF THIS MONUMENT IS UNKNOWN. ACCEPTED THE HARRISON MONUMENT AS THE CORNER LOCATION, BEING THAT IT HAS BEEN USED IN NUMEROUS SURVEYS AND HAS BEEN ACCEPTED AS THE CORNER LOCATION SINCE 1976. HARRISON FITS WELL WITH THE EXISTING TIES AND WITNESS TREE STUMP FROM WHEN PLS 922 SET THE HARRISON MONUMENT. RE-MEASURED TO THE EXISTING TIES. PROPERTY IRON AND WITNESS TREE STUMP.

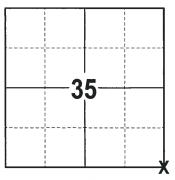

LOCATION (INDICATE CORNER BY "X")



DATA SHOWN HERE ON THIS TIE SHEET IS CORRECT AND COMPLETE TO THE BEST OF MY KNOWLEDGE AND BELIEF.

PROFESSIONAL LAND SURVEYOR

11-15-17

- TIE SKETCH

NOTE: THE CORNER FALLS 8'± SOUTH OF THE CENTERLINE OF GALE AVE AND 6'± WEST OF THE CENTERLINE OF 8TH AVE.




1/2" IRON ROD FOUND

⊕ 3/4" IRON ROD FOUND 3/4" IRON ROD FOUND

HARRISON FOUND ✓ STEEL FENCE POST

→ VINYL "T" POST WITNESS TREE STUMP FOUND

WITNESS TREE FOUND

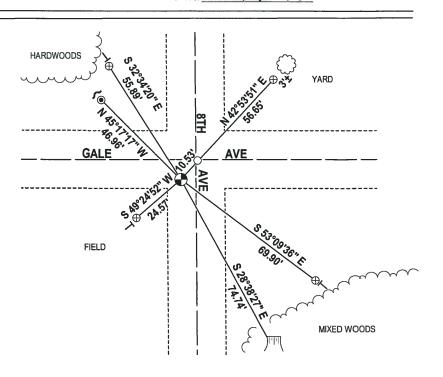

ADAMS COUNTY SURVEY MONUMENT RECORD

TYPE OF MONUMENT: STD. HARRISON CAST IRON ADAMS COUNTY COORDINATES: N = 132.902.99

E = 552,392.74

DATUM: NAD '83/2007 ADJ.-GPS AND CONVENTIONAL CONTROL


WITNESSES TO CORNER LOCATION: TODD T. RUMMLER, MARK A. MAHONEY

BASIS FOR MONUMENT LOCATION

SHOW INFO SUCH AS: HISTORY OF CORNER, WITH REFERNCE TO VOL. AND PG., DATES, SURVEYOR; EXACT DESCRIPTION OF MONUMENT REPLACED; IF LOCATION COMPUTED, BY TAPED OR EDM TRAVERSE; LANDOWNER REMARKS, ETC.

THE LAST TIE SHEET ON FILE FOR THIS CORNER IS DATED MAY 26, 1976 BY FREDERIC W. ZIETLOW, R.L.S. 922. ZIETLOW STATES HE FOUND A POINTED STONE AT THIS CORNER AND REPLACED IT WITH A HARRISON MONUMENT. NUMEROUS NOTATIONS BY OTHER SURVEYORS ALSO APPEAR ON THE TIE SHEET. I FOUND THE STANDARD HARRISON CAST IRON MONUMENT AS NOTED BY ZIETLOW AND ESTABLISHED REFERENCE TIES AS SHOWN BELOW TO PERPETUATE THE CORNER LOCATION.

CORNER No. 983 SECTION 2 TOWN 14N RANGE 6E = CORNER LOCATION

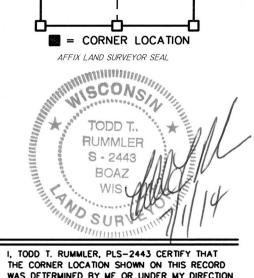

I, TODD T. RUMMLER, PLS-2443 CERTIFY THAT TIE SKETCH THE CORNER LOCATION SHOWN ON THIS RECORD AVENUE WAS DETERMINED BY ME OR UNDER MY DIRECTION AND CONTROL AND THAT THIS ADAMS COUNTY SURVEY MONUMENT RECORD IS CORRECT AND COMPLETE TO THE BEST OF MY KNOWLEDGE AND BELIEF. REBAR SET REBAR SET **LEGEND**

FOUND STD. HARRISON CAST IRON MONUMENT- NE CORNER SECTION 2, TI4N, R6E

- SET 3/4"Ø X 24" LONG REBAR WT. = 1.502 LBS./LN.FT.
- ▼ TELEPHONE PEDESTAL

