OG RANGE ADAMS COUNTY COUNTY CORNER NO: 17

ROMPORTOL ID: 41406042000

PUBLIC LAND SURVEY MONUMENT RECORD

HARRISON (BROKEN-TOP) TYPE OF MONUMENT: ADAMS COUNTY COORDINATES, NAD 83 (2007) N. 129174.813

ELEVATION- - — DATUM


FIELD WORK DATE:__ 12/15/2020

E. 541823.923

BASIS FOR MONUMENT LOCATION

1975 - PLS 922 RECOVERED RAILROAD SPIKE, FOUND BY DAVE CLARK IN 1969 AND USED BY HIM FOR SURVEYS IN 1969. CHECKED COUNTY SURVEYS RECORDS AND NO OTHER RESURVEYS WERE ON FILE. TRANSIT TAPE TRAVERSE OF SECTION GOOD.

2020 - PLS 2675 FOUND HARRISON (BROKEN-TOP) 18"± BELOW THE ROAD SURFACE AND 2 TIES. THE MONUMENT AGREES WITH BOTH EXISTING TIES. ACCEPTED THE HARRISON (BROKEN-TOP) AS THE CORNER LOCATION. SET 2 NEW TIES AND MEASURED TO THE EXISTING TIES.

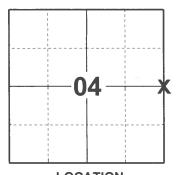

LOCATION

(INDICATE CORNER BY "X")



DATA SHOWN HERE ON THIS TIE SHEET IS CORRECT AND COMPLETE TO THE BEST OF MY KNOWLEDGE AND BELIEF.


PROFESSIONAL LAND SURVEYOR 18/2021

- TIE SKETCH

NOTE: CORNER LANDS 6'± NORTH OF CENTERLINE OF GALE DR.



- SET 3/4" x 18" IRON REBAR, 1.50#/FT
- O FOUND 3/4" IRON ROD
- O FOUND 1-1/4" O.D. IRON PIPE
- FOUND HARRISON MONUMENT (BROKEN-TOP)
- ✓ STEEL FENCE POST
- VINYL "T" POST

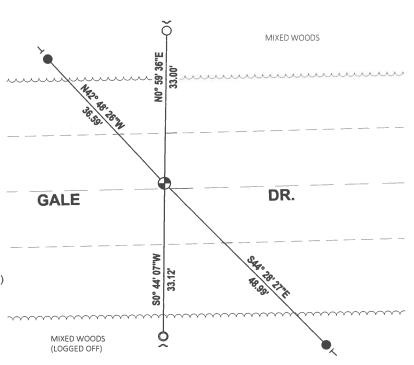

ADAMS COUNTY	CORNER NO	739
Survey Monument Record	SECTION .	3
TYPE OF MONUMENT: 30" HARRISON	TOWN	14-N
STATE PLANE COORDINATES: N	RANGE	6-E
ELEVATION — M.S.L. DATUM:		
THETA ANGLE: PAGE		
PAGE		-
BASIS FOR MONUMENT LOCATION		
(Use reverse side if necessary)		
Show info such as: History of corner, with reference to Vol. and pg, dates, surveyor; exact description of monument replaced; if location computed, by taped or EDM traverse; landowner remarks, etc.	LOCATION (Indicated by 'X') SCONS/N FREDERIC W. ZIETLOW S-922 Baraboo WIS.	
	NIGONS/A	
	PREDERIC	Mr.
RECOVERED RAILROAD SPIKE, FOUND BY DAVE CLARK IN 1969 AND USED BY HIM FOR SURVEYS IN 1969 CHECKED	W.	
CO. SURVEYS RECORDS & NO OTHER	ZIETLOW	* =
RESURVEYS WERE ON FILE. FIT	s -922	117/
TRANSIT TAPE TRAVERSE OF	Baraboo	0-3
SECTION GOOD	WIS.	
CORNER O.K. 11-2-76 RN-SS	NO SURVEN	7
CORNER O.K. 13/32/81 DW SA	Minimi	
1/6 4 2/6-86 64-35		
	ED CORRECT:	
1-CONE, 4-REMAIN CORDK 12/6/95 JG-55 AND	Land Surveyor	· · · · · · · · · · · · · · · · · · ·
,	JULY 31,19	75
TIE SKETCH Z NEW) GONG 12-19-11 MS		
(C) 1 () () () () () () () () ()	•	
(Show at least four ties) GROTHMAN SURVEY GROTHMAN SURVEY	•	
		A
000		
MAIL IN STEEL TOO NAIL IN ZED ZEL	AD SOUT	
PINEL () OAK by STIL	L STANDING	
TOT STATE IN 10/		- 1
		•
GALE		
		•
		•
NAIL IN 43.		
8" M I AIL IN		
DINE DINE		
GONE (II) KIE OF		

•