

PUBLIC LAND SURVEY MONUMENT RECORD

TYPE OF MONUMENT: 1-1/4" O.D. IRON PIPE
 ADAMS COUNTY COORDINATES, NAD 83 (2007)

N. 126422.454

E. 528476.017


ELEVATION: _____ DATUM: _____

FIELD WORK DATE: 12/17/2020

BASIS FOR MONUMENT LOCATION

1977 - PLS 1103 RAN EDM-T2 TRAVERSE AROUND SECTION 6 AND TO PORTIONS OF ADJOINING SECTIONS TO DETERMINE SEARCH AREA FOR INVESTIGATION. SEARCH REVEALED NO TRACE OF THE ORIGINAL CORNER OR ANY REMONUMENTATION. (NO REMONUMENTATION OF RECORDS IN ADAMS COUNTY COURTHOUSE) RELOCATED CORNER AT RECORD DISTANCE FROM SOUTHEAST CORNER OF SECTION 6 AND ON LINE BETWEEN SOUTHEAST AND SOUTH QUARTER CORNER. LOCATION FITS OCCUPATION VERY WELL. SET HARRISON ON 3-22-77.

2020 - PLS 2675 FOUND 1-1/4" O.D. IRON PIPE 2" ABOVE THE GROUND AND 2 WITNESS TREES. THE MONUMENT AGREES WITH BOTH WITNESS TREES. ACCEPTED THE 1-1/4" O.D. IRON PIPE AS THE MEANDER CORNER. SET 3 NEW TIES, MEASURED TO THE NEARBY QUARTER CORNER, AND THE EXISTING WITNESS TREES.

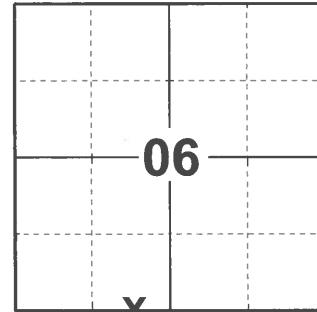

LOCATION
 (INDICATE CORNER BY "X")

SEAL:




DATA SHOWN HERE ON THIS TIE SHEET IS CORRECT AND COMPLETE TO THE BEST OF MY KNOWLEDGE AND BELIEF.

PROFESSIONAL LAND SURVEYOR

DATE 1/18/2021

TIE SKETCH

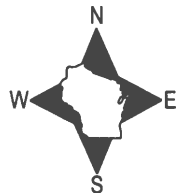

- SET 3/4" x 18" IRON REBAR, 1.50#/FT
- FOUND M.C. 1-1/4" O.D. IRON PIPE
- ⊕ FOUND HARRISON MONUMENT
- VINYL "T" POST
- ☁ WITNESS TREE
- ∩ WITNESS STUMP

