

04
SECTION

14
TOWN

06
RANGE

ADAMS COUNTY

COUNTY CORNER NO: 27

ROMPORTOL ID: 41406040000

PUBLIC LAND SURVEY MONUMENT RECORD

TYPE OF MONUMENT: HARRISON
ADAMS COUNTY COORDINATES, NAD 83 (2007)

N. 126526.631

E. 541782.387


ELEVATION- DATUM

FIELD WORK DATE: 12/15/2020

BASIS FOR MONUMENT LOCATION

1975 - PLS 922 FOUND 2"X30" IRON PIPE AND BATHEY MARKER. LAKE OF THE PINES SUBDIVISION IS TIED TO THIS CORNER. FIT EDM TRAVERSE OF SECTION GOOD. FALLS AT OLD FENCE CORNER.


2020 - PLS 2675 FOUND HARRISON 4"± BELOW THE GROUND, 1 TIE, AND 4 WITNESSES. THE MONUMENT AGREES WITH THE TIE AND WITNESSES. ACCEPTED THE HARRISON AS THE CORNER LOCATION. SET 3 NEW TIES, MEASURED TO THE EXISTING TIE, AND WITNESSES.

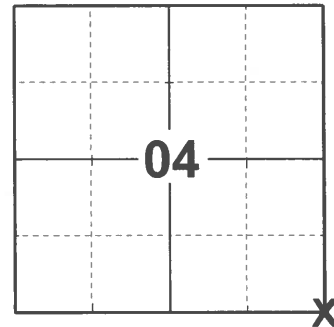

LOCATION

(INDICATE CORNER BY "X")

SEAL:

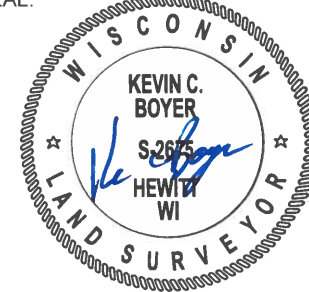


DATA SHOWN HERE ON THIS TIE SHEET IS CORRECT AND COMPLETE TO THE BEST OF MY KNOWLEDGE AND BELIEF.

PROFESSIONAL LAND SURVEYOR


DATE 1/18/2021

TIE SKETCH

NOTE: CORNER LANDS 300'± EAST OF PINE CREST AVE.

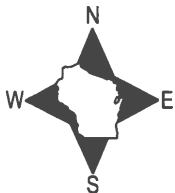

- SET 3/4" x 18" IRON REBAR, 1.50#/FT
- FOUND 1-1/4" O.D. IRON PIPE
- ⊕ FOUND HARRISON MONUMENT
- ~ STEEL FENCE POST
- VINYL "T" POST
- ☉ WITNESS TREE
- ⌋ WITNESS STUMP

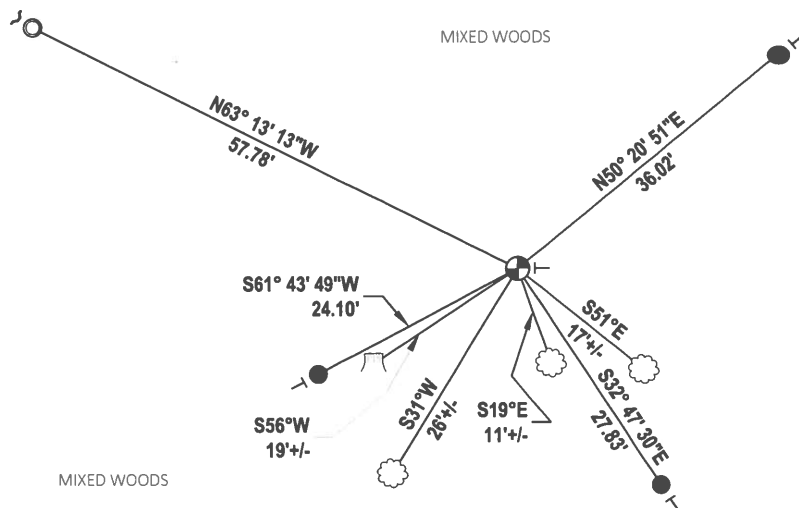


ADAMS COUNTY

Survey Monument Record


TYPE OF MONUMENT: 30" HARRISON M.
 STATE PLANE COORDINATES: N _____
 E _____
 ELEVATION — M.S.L. DATUM: _____
 THETA ANGLE: _____
 FIELD BOOK: _____ PAGE _____

CORNER NO. 722
 SECTION 10
 TOWN 14N
 RANGE 6E

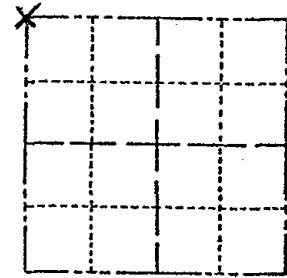

LOCATION
(Indicated by 'X')

SEAL:

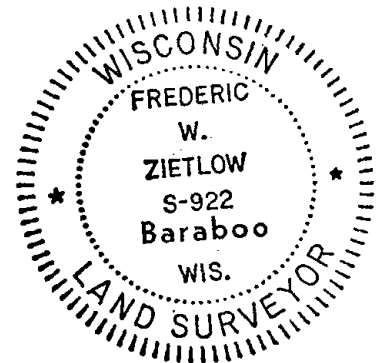

BASIS FOR MONUMENT LOCATION

(Use reverse side if necessary)

Show info such as: History of corner, with reference to Vol. and pg, dates, surveyor; exact description of monument replaced; if location computed, by taped or EDM traverse; landowner remarks, etc.

FOUND 2" X 30" IRON PIPE & BATHEY MARKER. LAKE OF THE PINES SUBDIVISION IS TIED TO THIS CORNER. FIT EDM TRAVERSE OF SECTION GOOD. FALLS AT OLD FENCE CORNER.

COMPUTED O.K. 12-76
 TIES & MON. O.K. 12/22/81 SK-D.W.
 " " " 2-18-86 GR-SS
 " " " 7-15-91 SS-JG
 ADD 1 TIE 5-16-96 SS
 ALL OK 10-11-01 SS
 ALL OK, 11-11-04-36-SS
 OK 11-30-11 SS

CERTIFIED CORRECT:

Frederic W. Zietlow

Registered Land Surveyor

DATE: JULY 31, 1975

TIE SKETCH

(Show at least four ties)

