SECTION

FIELD WORK DATE:

OF ADAMS COUNTY

COUNTY CORNER NO: 40

ROMPORTOL ID: 41406122000

PUBLIC LAND SURVEY MONUMENT RECORD

TYPE OF MONUMENT: HARRIS ADAMS COUNTY COORDINATES, NAD 83 (2007) N. **124600.138** E. 557617.470 DATUM_ — — —


09/14/2017

BASIS FOR MONUMENT LOCATION


1980 - PLS 878 EXCAVATED WITH A BACKHOE AND FOUND A 9"X9"X18" GRANITE STONE WITH A ROTTED STAKE ALONG THE WEST SIDE. STONE FITS CALL TO BEARING TREE REMNANTS. STONE CALLED FOR BY BARRETT PER 1895 FIELD NOTES, VOL. 2, PAGE 202. SET A HARRISON MONUMENT AT THE CORNER LOCATION AND TIED OUT.

1999 - PLS 1397 EXISTING MONUMENT WAS FOUND AT THE CORNER LOCATION, MONUMENT WAS REMOVED AND RAISED DUE TO RECONSTRUCTION OF C.T.H. B. CORNER WAS RE-TIED.

2017 - PLS 2994 FOUND A HARRISON MONUMENT 6" BELOW THE ROAD SURFACE AND 1 WITNESS TREE. THE MONUMENT AGREES WITH THE EXISTING WITNESS TREE. ACCEPTED THE HARRISON MONUMENT AS THE CORNER LOCATION. SET 4 NEW TIES AND MEASURED TO THE TIES AND WITNESS TREE.

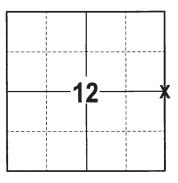

LOCATION (INDICATE CORNER BY "X")

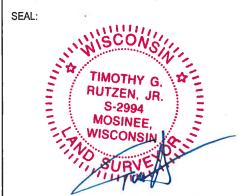

DATA SHOWN HERE ON THIS TIE SHEET IS CORRECT AND COMPLETE TO THE BEST OF MY KNOWLEDGE AND BELIEF.

PROFESSIONAL LAND SURVEYOR


11-15-17 DATE

- TIE SKETCH

NOTE: THE CORNER FALLS 1'± WEST OF THE CENTERLINE OF CTH B.



3/4" x 18" IRON REBAR SET, 1.50#/FT HARRISON FOUND VINYL "T" POST WITNESS TREE FOUND

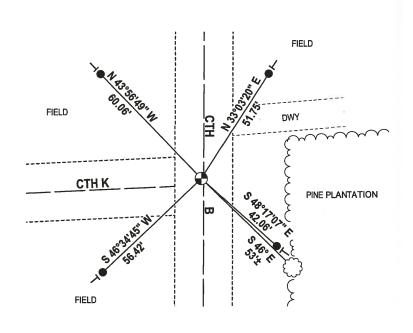

	ADAMS COUNTY	•	CORNER NO	40
	Survey Monument Record		SECTION _	12
	TYPE OF MONUMENT: 30" HARRISON MARKER		TOWN _	14N
	STATE PLANE COORDINATES: N		RANGE _	6E
	E		L-i	٦
1	ELEVATION — M.S.L. DATUM:			4
	THETA ANGLE: PAGE			٦.
	FIELD BOOK:			* N
	BASIS FOR MONUMENT LOCATION	5. 2.		
	(Use reverse side if necessary)	1.	LOCATION	_1
	Show info such as: History of corner, with reference to Vol. and pg, dates, surveyor; exact description of monument replaced; if location computed, by taped or EDM traverse; landowner remarks, etc.	SEAL:	(Indicated by X')	
			THE THE PERSON NAMED IN TH	
	Existing Monument was found in place.	•	DENNIS J. RUSSELL S1397 MADISON. WI SURVE	
	Monument was removed and raised due to	<u>.</u>		
	reconstruction of C.T.H. "B". All tie measurements		DENNIS J.	
	unless noted otherwise.		S-1397 MADISON) [
	ALL OK 3.5.01 MH- >6		WI	
<u>ا</u> ے۔	CONE ZNEW 1-18-06 - JG		THE PLANT OF THE PARTY OF THE P	TOTHIN .
1	CONE 2NEW 1-18-06 - JG NEW 12-19-11 MS		SURVINION SURVINION	A THINK
•				
		CERTIFI	ED CORRECT:	-0
	· •	Len	nie Alex	cell
		Registered DATE:	Land Sufferior 19	99
			7	
	TIE SKETCH		V	,
	(Show at least four ties)	ALL MEASURE	MENTS ARE HORIZONTA	٠
				4
	FIELD	1		4
		FIELD	•	NI
		Ţ		114
	ا ا	R/W POST N. EDGE	nAK.	
	<u>е стн к</u> —	-14 ESIGN		
	ECTH K WEST EOGE 3'± 13.20 Plw Pos i 13.20	e		•
	CONE NORWAY	12" NORWAY		
		5162		
				•

4" BURR OAK

Government Land Corner Certificate	
Adams County	CORNER NO.
TYPE OF MONUMENT: Harrison	SECTION //
STATE PLANE COORDINATES: N	TOWN //
ELEVATION — M.S.L. DATUM:	RANGE
THETA ANGLE:	
FIELD BOOK: /02 PAGE 76 DRAWN BY: U.J.	
DRAWN BI: 754.	
BASIS FOR MONUMENT LOCATION	
Show info such as: History of corner, with reference to Vol. and pg., dates, surveyor; exact description of monument	
replaced; if location computed, by taped or EDM traverse; landowner remarks, etc. (Use reverse side if necessary)	LOCATION (Indicated by 'X')
	SEAL:
Excavated with backhoe. Found 9x9x18" pointed granite stone with rotted stake along the west	Substitution of No.
side. Stone fits call to bearing tree, remnants of	
which still exist. Stone called for by Barrett per 1895 field notes, Vol 2, page 202.	ANTHONY B. KIEDROWSKI
COENER O.K. 12-22-81 SK-DW	S-878 Wisconsin Rapids,
ALLOK 11-1-90 JG-55	Wis
1- GONE, 2. NEW TIES, COR OK, 12/6/95 JG-55	The state of the s
	Man Road
	DATA SHOWN HERE ON
	CERTIFIED CORRECT:
	Registered Land Surveyor
	DATE: <u>5/7/80</u>
THE OVEROLL	
TIE SKETCH Show at least four ties, also fence lines, roads, topo, size	
and type of witness trees' and if off road - best way to arrive at corner.	FIELD
	1.0
FIELD	
	OF ROTTED BY
22'2	OF KONES OF
G CTH M K' BEC	54.4 5 BUNCK
	54.4 5 "BUNCK" 95
	Sty 5 BURGE 95
	Rower Role
16.86 1/± 25	Style 5 BLACK 95
	Rower Pole A Norway

MAINTENANCE RECORD

DATE	BY WHOM	REMARKS
2/6/86	GR - 55	OK

•	•	~		•	S 2
		U		-3.	٠.
ľ	т.	Ľ	~	Ξ.	١.
٠	/		٠.,		1.
į	G.	'n			l
ì			~		٠.
	٠	۲.	7	٠.	
ı		٠,		J:	
١		.5	ببز		

Adams County	CÖRNER NÖ. SECTION	40 12
TYPE OF MONUMENT: Hareson STATE PLANE COORDINATES: N E	TOWN RANGE	6
ELEVATION — M.S.L. DATUM: THETA ANGLE: FIELD BOOK: /OZ PAGE 7G DRAWN BY: NJ.		
BASIS FOR MONUMENT LOCATION Show into such as: History of corner, with reference to Vol.		
and pg., dates, surveyor, exact description of monument replaced; if location computed, by taped of EDM traverse; landowner remarks, etc. (Use reverse side if necessary)	LOCATION (Indicated by 'X')	
Excavated with backhoe. Found 9x9x18" pointed granite stone with rotted stake along the west side. Stone fits call to bearing tree, remnants of	Secure Secure	in the second
which still exist. Stone called for by Barrett per 1895 field notes, Vol 2, page 202.	ANTHONY B. KIEDROWSKI S-878	1
	Wisconsin gapids, Wis.	
	DATA SHOWN HERE ON CENTIFIED CORRECT:	
	Children, Common	

TIE SKETCH

Show at least four ties, also fence lines, roads, topo, size and type of witness trees and if off road - best way to arrive at corner.

FIELD

Red

POR Reminant BA

OF ROTED BA

1086

8 Notwing

8 Notwing