TOWN

OG RANGE ADAMS COUNTY CORNER NO: 46

ROMPORTOL ID: 41406090020

PUBLIC LAND SURVEY MONUMENT RECORD

HARRISON TYPE OF MONUMENT: ADAMS COUNTY COORDINATES, NAD 83 (2007)

N. 121234.940

E. 539126.186


ELEVATION- - - - DATUM - - -

FIELD WORK DATE: 12/21/2020


BASIS FOR MONUMENT LOCATION

1976 - PLS 922 CHECKED ADAMS COUNTY SURVEY RECORDS FOR RESURVEYS AND NONE WERE ON FILE. USED FENCE CORNER AS 1/4 CORNER FROM TESTIMONY OF TOWN BOARD CHAIRMAN HAROLD WALKER. BEST AVAILABLE EVIDENCE FIT EDM TRAVERSE OF NORTH LINE OF SECTION GOOD.

2020 - PLS 2675 FOUND HARRISON FLUSH WITH THE GROUND AND 1 WITNESS TREE. ACCEPTED THE HARRISON AS THE CORNER LOCATION. SET 4 NEW TIES AND MEASURED TO THE WITNESS TREE.

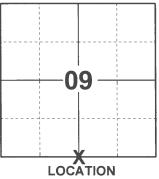

(INDICATE CORNER BY "X")

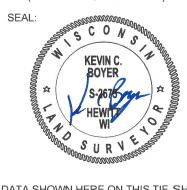

DATA SHOWN HERE ON THIS TIE SHEET IS CORRECT AND COMPLETE TO THE BEST OF MY KNOWLEDGE AND BELIEF.


PROFESSIONAL LAND SURVEYOR

1202

-TIE SKETCH



- SET 3/4" x 18" IRON REBAR, 1.50#/FT
- FOUND HARRISON MONUMENT
- STEEL FENCE POST
- VINYL "T" POST
- WITNESS TREE

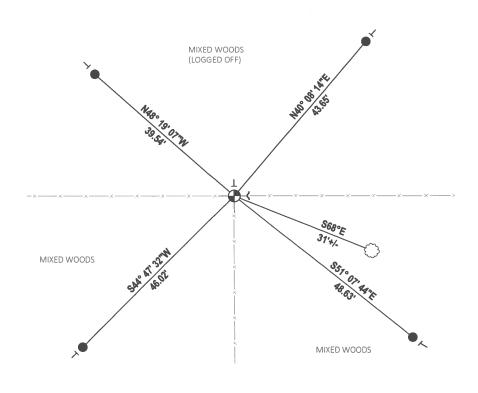

ADAMS COUNTY	CORNER NO. 988 (46)
Survey Monument Record	SECTION 16
TYPE OF MONUMENT: HARRISON MONUMENT - QUARTER COR	TOWN 14 LI
STATE PLANE COORDINATES: N	RANGE 6 E
E	
ELEVATION — M.S.L. DATUM:	
THETA ANGLE: PAGE	
BASIS FOR MONUMENT LOCATION	
(Use reverse side if necessary)	
Show info such as: History of corner, with reference to Vol. and pg, dates, surveyor; exact description of monument replaced; if location computed by tared or FDM traverse; landowners	LOCATION (Indicated by 'X') SEAL:
CHECKED ADAMS COUNTY SURVEY	MINIMINA.
RECORDS FOR RESURVEYS AND NONE	IIIWISCONSIN'III
WERE ON FILE. USED FENCE CORNER	FREDERIC
AS YY CORNER FROM TESTIMONY OF TOWN BOARD CHAIRMAN HAROLD	ZIETLOW
WALKER BEST AVAILABLE EVIDENCE	S-922
FIT E.D.M. TRAVERSE OF N. LINE	Baraboo E
OF SECTION GOOD.	WIS.
CORDER D.K 10-18-81 SK-DW	ZIETLOW *** S-922 Baraboo WIS. ONS. WIS.
CONDUM PIR TO TELLINO	
3 NEW TIES 4-25-96 JG-55	CERTIFIED CORRECT:
3 NEW TIES 4-25-96 JG-55 OK 10-10-01 SS.	CERTIFIED CORRECT: Frederic W. Zietbru
3 NEW TIES 4-25-96 JG-55	CERTIFIED CORRECT: Filler W. Zietbru Registered Land Surveyor
3 NEW TIES 4-25-96 JG-55 OK 10-10-01 SS.	CERTIFIED CORRECT: Frederic W. Zietbru
3 NEW TIES 4-25-96 JG-55 OK 10-10-01 SS. OK, 11-13-06-SC.	CERTIFIED CORRECT: Filler W. Zietbru Registered Land Surveyor
3 NEW TIES 4-25-96 JG-55 OK 10-10-01 SS. OK, 11-13-06-SC. TIE SKETCH (Show at least four ties) SAK'96	CERTIFIED CORRECT: Filler W. Zietbru Registered Land Surveyor
3 NEW TIES 4-25-96 JG-55 OK 10-10-01 SS. OK, 11-13-06-SC. TIE SKETCH (Show at least four ties) FINCES E-W 1857 TITACK	CERTIFIED CORRECT: Filler W. Zietbru Registered Land Surveyor
3 NEW TIES 4-25-96 JG-55 OK 10-10-01 SS. OK, 11-13-06-SC. TIE SKETCH (Show at least four ties) CAR' 96	CERTIFIED CORRECT: Filler W. Zietbru Registered Land Surveyor
3 NEW TIES 4-25-96 JG-55 OK 10-10-01 SS. OK, 11-13-06-SC. TIE SKETCH (Show at least four ties) FINCES E-W 196 TZ' CITSCIT WOODS. WOODS.	CERTIFIED CORRECT: Filler W. Zietbru Registered Land Surveyor
3 NEW TIES 4-25-96 JG-55 OK 10-10-01 SS. OK, 11-13-06-SC. TIE SKETCH (Show at least four ties) FINCES E-W 196 TZ' CITSCIT WOODS. WOODS.	CERTIFIED CORRECT: Freder W. Zierbru Registered Land Surveyor DATE:UNE 8, 1976
3 NEW TIES 4-25-96 J6-55 OK 10-10-01 SS OK, 11-13-06-SC TIE SKETCH (Show at least four ties) FINCES E-W MARK TIESCOT WOODS ATJACK WOODS	CERTIFIED CORRECT: Pulle W. Zierbru Registered Land Surveyor DATE: JUNE 8, 1976
3 NEW TIES 4-25-96 JG-55 OK 10-10-01 SS. OK, 11-13-06-SC. TIE SKETCH (Show at least four ties) FINCES E-W 196 TZ' CITSCIT WOODS. WOODS.	CERTIFIED CORRECT: Freder W. Zierbru Registered Land Surveyor DATE:UNE 8, 1976
3 NEW TIES 4-25-96 JG-55 OK 10-10-01 SS OK, 11-13-06-36 TIE SKETCH (Show at least four ties) TO SE WOODS	CERTIFIED CORRECT: Pulle W. Zierbru Registered Land Surveyor DATE: JUNE 8, 1976
3 NEW TIES 4-25-96 JG-55 OK 10-10-01 SS OK, 11-13-06-36 TIE SKETCH (Show at least four ties) TOURCE FOR THE SECOND AT STACK WOODS A WHITE J 26.5 PINC 96 JG-55	CERTIFIED CORRECT: Pulle W. Zierbru Registered Land Surveyor DATE: JUNE 8, 1976 N TOT SACK PINE BT TRAIL
3 NEW TIES 425.96 JG-55 OK 10-10-01 SS OK 11-13-06-SC TIE SKETCH (Show at least four ties)	CERTIFIED CORRECT: Puller W. Zierbru Registered Land Surveyor DATE: JUNE 8, 1976 N TRAIL
3 NEW TIES 4-25-96 JG-55 OK 10-10-01 SS OK, 11-13-06-SC TIE SKETCH (Show at least four ties) TACK WOODS WOODS WOODS WARE 4 MIGHT THE	CERTIFIED CORRECT: PROJECT W. Zierbru Registered Land Surveyor DATE: JUNE 8, 1976 N TOT SACK PINE BT TRAIL
3 NEW TIES 4.25.96 JG-55 OK 10-10-01 SS OK 11-13-06-SC TIE SKETCH (Show at least four ties) TACK WOODS WOODS WALL 4 MARK 1961 CONE OK 10-10-01 SS O	CERTIFIED CORRECT: Pulle W. Zierbru Registered Land Surveyor DATE: JUNE 8, 1976 TRAIL
3 NEW TIES 425.96 JG-55 OK 10-10-01 SS OK 11-13-06-SC TIE SKETCH (Show at least four ties)	CERTIFIED CORRECT: PROJECT W. Zierbru Registered Land Surveyor DATE: JUNE 8, 1976 N TOT SACK PINE BT TRAIL
3 NEW TIES 4-25-96 JE-55 OK 10-10-01 SS OK 10-10-01 SS OK, 11-13-06-SC TIE SKETCH (Show at least four ties) FINCES EN TO SET X AND X SERVER SE	CERTIFIED CORRECT: Pulle W. Zierbru Registered Land Surveyor DATE: JUNE 8, 1976 TRAIL

