## 06 ADAMS COUNTY CORNER NO: 47

ROMPORTOL ID: 41406090000


## PUBLIC LAND SURVEY MONUMENT RECORD

**HARRISON** TYPE OF MONUMENT: ADAMS COUNTY COORDINATES, NAD 83 (2007) N. **121229.044** E. **541774.762** ELEVATION- - - - DATUM - - -FIELD WORK DATE:\_\_\_ 12/21/2020

## BASIS FOR MONUMENT LOCATION

1975 - PLS 922 CHECKED COUNTY SURVEY RECORDS FOR RESURVEYS AND NONE WERE ON FILE. TALKED TO ADJACENT PROPERTY OWNER'S AND NELSON SAID HE REMEMBERED THAT CORNER WAS AT INTERSECTION OF MOUND FROM WEST AND SOUTH. THIS FIT EDM TRAVERSE OF SECTION GOOD.

2020 - PLS 2675 FOUND HARRISON FLUSH WITH THE GROUND AND 1 WITNESS TREE. THE MONUMENT AGREES WITH WITNESS TREE. ACCEPTED THE HARRISON AS THE CORNER LOCATION. SET 4 NEW TIES AND MEASURED TO THE EXISTING WITNESS TREE.

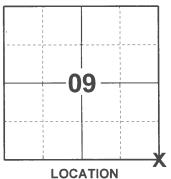

(INDICATE CORNER BY "X")



DATA SHOWN HERE ON THIS TIE SHEET IS CORRECT AND COMPLETE TO THE BEST OF MY KNOWLEDGE AND BELIEF.


PROFESSIONAL LAND SURVEYOR

18/2021

-TIE SKETCH



- SET 3/4" x 18" IRON REBAR, 1.50#/FT
- FOUND HARRISON MONUMENT
- STEEL FENCE POST
- VINYL "T" POST
- WITNESS TREE

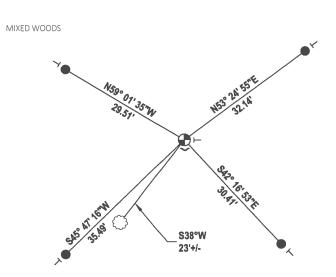

	**		171
ADAMS COUNTY	· · · · · · · · · · · · · · · · · · ·	CORNER NO.	クラ」 〜
Survey Monument Record		SECTION .	10
TYPE OF MONUMENT: 30" HARRISON		TOWN	141
STATE PLANE COORDINATES: N	<del>-</del>	RANGE	6E
E	<del>-</del>		
ELEVATION — M.S.L. DATUM:			7
THETA ANGLE:			<i>(</i>
FIELD BOOK: PAGE	<del></del>		A
BASIS FOR MONUMENT LOCATION			-
(Use reverse side if necessary)	k	<u> </u>	
Show info such as: History of corner, with reference to Vol. and pg, dates, surveyor; exact description of monument replaced; if location computed, by taped or EDM traverse; landowner remarks, etc.	SEAL:	LOCATION (Indicated by 'X')	
CHECKED CO. SURVEY RECORDS FOR	, m	CONSINIA	
RESURVEYS \$ NONE WERE ON FILE.	TII, A	EREDERIG	
TALKED TO ADJACENT PROPERTY OWNERS	₹ /	W.	
& NELSON SAID HE REMEMBERED THAT	<b> </b>	ZIETLOW	-
CORNER WAS AT INTERSECTION OF MOUND	=*	s-922 ~	=
FROM WEST & SOUTH. THIS FIT ED.M.	<b>三</b> 人	Baraboo ;	<del>-</del>
TRAVERSE OF SECTION GOOD,	11,4	WIS.	•
CORNER DAY METER ANDSE	111	FREDERIC W. ZIETLOW S-922 Baraboo WIS. O SURVENING	
CORNER O.K 12-18-81 SK-DW	.*		
ALL OK 11-1-90 JG-55	CERTIFIE	ED CORRECT:	
11 11 4-24-96 JG-SS	Tr	wen Wil	istour
1 NEW 715 10-10-07	Registered DATE:	Land Surveyor	, 1975
OR 4-13-06 SVS			
TIE SKETCH Enter thru W. Delson San	,1		
(Show at least four ties)			
			A
S ma MAIL IN S	apact V		
B"JACK 30 S WAIL IN S	OAK/O DOTA		

