14 TOWN

## 06 RANGE ADAMS COUNTY CORNER NO: 48 ROMPORTOL ID: 41406100020

## PUBLIC LAND SURVEY MONUMENT RECORD

**HARRISON** TYPE OF MONUMENT: ADAMS COUNTY COORDINATES, NAD 83 (2007)

N. **121375.061** 

E. 544406.910


ELEVATION- - - -DATUM - - -

FIELD WORK DATE:\_\_\_\_ **12/18/2020** 

## BASIS FOR MONUMENT LOCATION

1975 - PLS 922 CHECKED COUNTY SURVEY FOR RESURVEYS AND NONE WERE ON FILE. SET CORNER EQUADISTANT ON LINE BETWEEN SOUTHEAST AND SOUTHWEST CORNERS. COULD FIND NO EVIDENCE OF CORNER IN FIELD.

2020 - PLS 2675 FOUND HARRISON 4"± BELOW THE GROUND AND 2 WITNESSES. THE MONUMENT AGREES WITH BOTH WITNESSES. ACCEPTED THE HARRISON AS THE CORNER LOCATION. SET 4 NEW TIES AND MEASURED TO THE EXISTING WITNESSES.

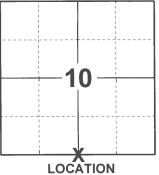

(INDICATE CORNER BY "X")



DATA SHOWN HERE ON THIS TIE SHEET IS CORRECT AND COMPLETE TO THE BEST OF MY KNOWLEDGE AND BELIEF.


PROFESSIONAL LAND SURVEYOR

1505/81

- TIE SKETCH



- SET 3/4" x 18" IRON REBAR, 1.50#/FT
- FOUND HARRISON MONUMENT
- STEEL FENCE POST
- WOOD FENCE POST
- VINYL "T" POST
- WITNESS TREE

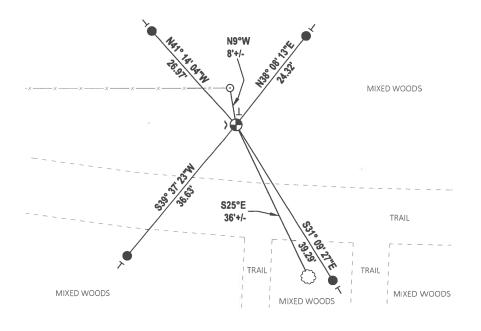

ADAMS COUNTY	CORNER NO	726
Survey Monument Record	SECTION _	10
TYPE OF MONUMENT: 30" HARRISON	TOWN	1411
STATE PLANE COORDINATES: N	RANGE	6E
E		٦
ELEVATION — M.S.L. DATUM: THETA ANGLE:		
FIELD BOOK: PAGE		
BASIS FOR MONUMENT LOCATION		
(Use reverse side if necessary)		]
Show info such as: History of corner, with reference to Vol. and pg, dates, surveyor; exact description of monument replaced; if location computed, by taped or EDM traverse; landowner remarks, etc.		
CHECKED CO. SURVEY FOR RESURVEYS	FREDERIC W. ZIETLOW S-922 Baraboo WIS.	11,
FNONE WERE ON FILE. SET CORNER	FREDERIC	"In
EQUADISTANT ON LINE BETWEEN	W	
SE & SW CORS. COULD FIND NO EVIDENCE OF COR, IN FIELD	= * ZIETLOW S-922	* =
Orener Och 12216 RN SS	Baraboo	0.3
CORNER OK 12-18-81 SK-DW	WIS.	0,12
4 3-22 32 GA-33	SURVE	
ALL OK 11-1-90 JG-SS		· · · ·
ALL OK 5-11-93 MC	RTIFIED CORRECT:	
1/2/R 1/K 1/L 16/93 30	Fredom W. Ziel	Low-
2 10 11 13.06 SS Reg	istered Land Surveyor TE: July 31,	
* &K (2-01-11 SS DA	IE:	
TIE'SKETCH OK OL		,
(Show at least four ties)		
4.15 COST		A
-WAILIN \ GOINGAL		4
8" TWIN OAK TO	•	
SACK PINERT		B 1.4
NIE TO TRAIL	· .	
JRA12 32,3 4	7" TP '36	
34/t _ 5 P	EE LINE	
1 mod	/ND	
17/1/2 34		
LANGE WALL VOL	METTAL	-
6" TPINE OF WILL OF HES	16 OAK BY BLDG	イだり
NAIL IN Z" ANGLE 6" JACK PINE!	400	60054
2 MIGH 1 /Refu - 124' SERIN DI	•	