## U.S. PUBLIC LAND SURVEY MONUMENT RECORD

### ADAMS COUNTY

This record shall show the location of the corner and shall include all of the following nine elements (a through i)

**ELEVATION: -M.S.L. DATUM\_** 

ELLIP, HEIGHT:

SHEET 1 OF 2

TYPE OF MONUMENT: BERNTSEN SURVEY MARKER NAIL

ADAMS COUNTY COORDINATES: N: 213611.521

**546868.448** 

ORDER OF ACCURACY:

☐ FOUND X SET

☐ RE-SET

X RE-TIED

FIRST

SECOND THIRD

**FOURTH** 

UNKNOWN OTHER

REFERENCE DATUM: NAD 83 (2011)

X

LATITUDE: LONGITUDE:

(b) Describe any record evidence, monument evidence, occupational evidence, testimonial evidence, or any other material evidence considered by the professional land surveyor, and whether the monument was found or placed

DALE C. HAGEN, PLS 1103 SET HARRISON MONUMENT. RETRACED SURVEY OF SECTION 11 (IE. SECTION TO NORTH) BY RAY C. CARLSON, S-297, AND RE-ESTABLISHED NORTHWEST CORNER OF SECTION 14. PER PREVIOUS TIE SHEET DATED AUGUST 19, 1974.

TIMOTHY G. RUTZEN, JR, PLS 2994 FOUND A HARRISON MONUMENT 4" BELOW THE ROAD SURFACE, I TIE AND I PROPERTY IRON. THE MONUMENT AGREES WITH THE EXISTING TIE. ACCEPTED THE HARRISON MONUMENT AS THE CORNER LOCATION. SET 2 NEW TIES AND MEASURED TO THE TIES AND PROPERTY IRON. PER PREVIOUS TIE SHEET DATED AUGUST 30, 2018.

ON AUGUST 27, 2021, I FOUND A HARRISON MONUMENT AT THE CORNER LOCATION AND THREE EXISTING WITNESS MONUMENTS AS SHOWN ON PREVIOUS TIE SHEET DATED AUGUST 30, 2018. EXISTING MONUMENT CHECKED WELL WITH WITNESS MONUMENTS AND WAS ACCEPTED AS THE CORNER LOCATION. MONUMENT AND WITNESSES WERE TIED BEFORE RECONSTRUCTION OF COUNTY HWY "M".

ON NOVEMBER 3, 2021, AFTER CONSTRUCTION WAS COMPLETE, I SET A BERNTSEN SURVEY NAIL IN ASPHALT AT THE PREVIOUS SURVEYED LOCATION AND VERIFIED THREE WITNESS MONUMENTS AS PREVIOUSLY FOUND. WHICH WERE IN GOOD CONDITION AND FOUND AN EXISTING 3/4" IRON BAR SOUTH OF SECTION CORNER AND USED AS WITNESS MONUMENT AS SHOWN IN THE BELOW SKETCH.

- (c) In the plan view drawing below, provide reference ties to at least 4 witness monuments. Witness monuments shall be concrete, natural stone, iron, bearing trees or other equally durable material, except wood other than bearing trees.
- (d) Show a plan view drawing depicting the relevant monuments and reference ties which is sufficient in detail to enable accurate relocation of the corner monument if the corner monument is disturbed.

DRAFTED BY JORDAN G. BROST DRAWN BY TRAVIS PLANTICO

#### TIE SKETCH: (SCALE: 1"=60') WOODED AREA WOODED AREA STOP GRAVEL SIGN GRAVEL C.T.H. "M" C/L AS TRAVELED **ASPHALT** GRAVEL FIRE SIGN ~ FIRE SIGN WOODED AREA #899 #901 WOODED AREA

#### LEGEND AND NOTES:

- SET BERNTSEN SURVEY MARKER NAIL
- 3/4" IRON BAR FOUND
- PLASTIC R/W POST

A-B N 33°01'57"E 59.94 (S 00'30'03" E) S 00°33'11"E Š3.16' (S 40.44'06" W) **S 40°42'19"W 77.12**′ A-D (N 45'33 20 "/ N 45°49'38"W A-E

COORDINATES ARE REFERENCED TO THE ADAMS COUNTY COORDINATE SYSTEM AS DEVELOPED BY THE WISCONSIN DEPARTMENT OF TRANSPORTATION.




Landscape Architecture Engineering Jordan G. Brost, PLS #3009 4941 Kirschling Court Stevens Point, WI 54481 715.344.9999 (Ph) 715.3

Land Surveying

(a) Identify the corner by reference to the U.S. public land survey system.

CORNER NO. 49ROMPORTOL ID: 41706100000 10 SECTION NORTH

**17** TOWNSHIP\_ 06 **RANGE** FAST

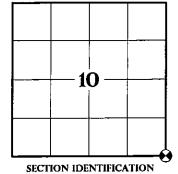

## **U.S. PUBLIC LAND SURVEY MONUMENT RECORD ADAMS COUNTY**

RANGE

Land Surveying Landscape Architecture Engineering


Jordan G. Brost, PLS #3009 4941 Kirschling Court Stevens Point, WI 54481 715,344,9999(Ph) 715,344,9922(Fx)

**EAST** 

(e) A description of any material discrepancy between the location of the corner monument as restored and the monument location of that corner as previously established.

(a) Identify the corner by reference to the U.S. public land survey system.

CORNER NO. 49 ROMPORTOL ID: 41706100000 10 SECTION \_ NORTH **17** TOWNSHIP 06

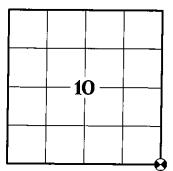

SECTION IDENTIFICATION

(f) Was the corner restored through acceptance of (1) an obliterated evidence location, or (2) a found perpetuated location.

#### FOUND PERPETUATED LOCATION

(g & h) Was the corner reestablished through lost corner proportionate methods? If so, show the method, including the directions and distances to other public land survey corners used as evidence or used for proportioning in determining the corner location.

NO

(i) I, Jordan G. Brost, hereby certifiy that the corner location shown on this record was determined by me or under my direction and control and that this U.S. Public Land Survey Monument Record is correct and complete to the best of my knowledge and belief.

Jordan G. Brost, PLS # 3009

Nov. 18, 2021 Date

S. MOSI. WI

SHEET 2 OF 2

# 06 ADAMS COUNTY CORNER NO: 49 ROMPORTOL ID: 41406100000


## PUBLIC LAND SURVEY MONUMENT RECORD

**HARRISON** TYPE OF MONUMENT: ADAMS COUNTY COORDINATES, NAD 83 (2007) N. 121521.581 E. 547038.614 ELEVATION- - - DATUM FIELD WORK DATE: 12/18/2020


#### BASIS FOR MONUMENT LOCATION

1975 - PLS 922 FOUND 3/4"X14" IRON PIPE BURIED IN ROAD, MONUMENTED SAME. CHECKED COUNTY SURVEY RECORDS FOR RESURVEYS AND NONE WERE ON FILE. FIT EDM TRAVERSE OF SECTION GOOD.

2020 - PLS 2675 FOUND HARRISON 4"± BELOW THE ROAD SURFACE AND 1 WITNESS. THE MONUMENT AGREES WITH THE 1 WITNESS, ACCEPTED THE HARRISON AS THE CORNER LOCATION. SET 4 NEW TIES AND MEASURED TO THE EXISTING WITNESS.

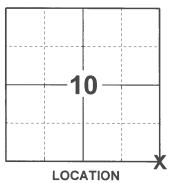

(INDICATE CORNER BY "X")

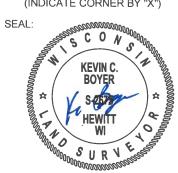

DATA SHOWN HERE ON THIS TIE SHEET IS CORRECT AND COMPLETE TO THE BEST OF MY KNOWLEDGE AND BELIEF

PROFESSIONAL LAND SURVEYOR

## -TIE SKETCH -

NOTE: CORNER LANDS 1'± WEST OF 9TH AVE.




SET 3/4" x 18" IRON REBAR, 1,50#/FT

FOUND HARRISON MONUMENT

→ VINYL "T" POST

□ SOUTHWEST CORNER OF ELECTRIC PEDESTAL

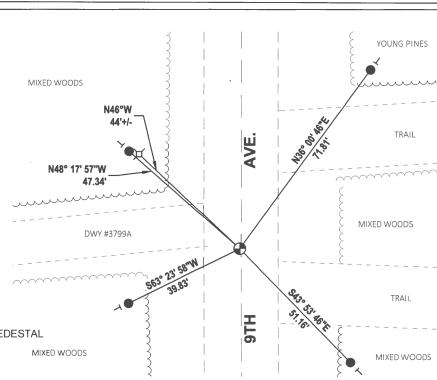

	(49)
ADAMS COUNTY	CORNER NO. 725
Survey Monument Record	SECTION 10
TYPE OF MONUMENT: 30" HARRISON	TOWN 14N
STATE PLANE COORDINATES: N	RANGE <u>6E</u>
E	
ELEVATION — M.S.L. DATUM:	
THETA ANGLE:	
FIELD BOOK: PAGE	
BASIS FOR MONUMENT LOCATION	
(Use reverse side if necessary)	<u> </u>
Show info such as: History of corner, with reference to Vol. and pg, dates, surveyor; exact description of monument replaced; if location computed, by taped or EDM traverse; landowner remarks, etc.	SEAL:  LOCATION (Indicated by 'X')  SEAL:  FREDERIC  W.  ZIETLOW  S-922  Baraboo  WIS.
FOUND 34"X 14" IRON PIPE BURIED IN ROAD,	WILLIAM TO WASHINGTON
MONUMENTED SAME. CHECKED COUNTY SURVEY	MINISOUNSINIL
RECORDS FOR RESURVEYS AND NONE WERE	FREDERIC
ON FILE. FIT EDM TRAVERSE OF SECTION	<i>≦ ∮</i> ₩. \
600D.	ZIETLOW =
CORNER O.K. 11-2-76 RM-SS	S-922
2081128 DK 12-18-81 DW-SK	Daraboo , wis
11 2-6-86 68-55	WAND SHOULE WIT
ALL OK 11-1-90 JG-SS	WWW. SUKWING
1- NEW TIE, 1-GONE COR OK 12/6/95 JG-SS	·
1- NEW TIE, 1- GONE COR OK 12/6/95 JG-SS 2-NEW TIES, 3-20-01 JG	CERTIFIED CORRECT:
1- NEW TIE, 1-GONE COR OK 12/6/95 JG-SS	Feelin W. Eithow
1- NEW TIE, 1-GONE COR OK 12/6/95 JG-SS 2-NEW TIES, 3-20-01 JG 2-GONE 1-NEW, 10-24-06-JG-JS	Registered Land Surveyor
1- NEW TIE, 1-GONE COR OK 12/6/95 JG-SS 2-NEW TIES, 3-20-01 JG 2-GONE 1-NEW, 10-24-06-JG-JS	Feelin W. Eithow
1- NEW TIE, 1-GONE COR OK 12/6/95 JG-SS 2-NEW TIES, 3-20-01 JG 2-GONE 1-NEW, 10-24-06-JG-JS	Registered Land Surveyor
1- NEW TIE, 1- GONE COR OK 12/6/95 JG-SS  2-NEW TIES, 3-20-01 JG  2-GONE 1-NEW, 10-24-06-JG-JE  1-Gone, 1-New 1-17-11 MS, SS	Registered Land Surveyor
1- NEW TIE, 1-GONE COR OK 12/6/95 JG-SS 2-NEW TIES, 3-20-01 JG 2-GONE 1-NEW, 10-24-06-JG-JS 1-Gone, 1-New 1-17-11 MS, SS	Registered Land Surveyor
1- NEW TIE, 1- GONE COR OK 12/6/95 JG-SS  2-NEW TIES, 3-20-01 JG  2-GONE 1-NEW, 10-24-06-JG-JE  1-Gone, 1-New 1-17-11 MS, SS	Registered Land Surveyor
1- NEW TIE, 1- GONE COR OK 12/6/95 JG-SS  2-NEW TIES, 3-20-01 JG  2-GONE 1-NEW, 10-24-06-JG-JE  1-Gone, 1-New 1-17-11 MS, 55  TIE SKETCH  (Show at least four ties)	Registered Land Surveyor DATE:
1- NEW TIE, 1- GONE COR OK 12/6/95 JG-SS  2-NEW TIES, 3-20-01 JG  2-GONE 1-NEW, 10-24-06-JG-JE  1-Gone, 1-New 1-17-11 MS, 55  TIE SKETCH  (Show at least four ties)  New May 24 MEN.	Registered Land Surveyor
1- NEW TIE, 1- GONE COR OK 12/6/95 JG-SS  2-NEW TIES, 3-20-01 JG  2-GONE 1-NEW, 10-24-06-JG-JE  1-Gone, 1-New 1-17-11 MS, 55  TIE SKETCH  (Show at least four ties)  New May 24 MEN.	Registered Land Surveyor DATE:
1- NEW TIE, 1- GONE COR OK 12/6/95 JG-SS  2-NEW TIES, 3-20-01 JG  2-GONE 1-NEW 10-24-06-JG-JS  1-Gone, 1-New 1-17-11 MS, 55  TIE SKETCH  (Show at least four ties)  New 1001	Registered Land Surveyor DATE:
I-NEW TIE, I-GONE COR OK 12/6/95 JG-SS  2-NEW TIES 3-20-01 JG  2-GONE I-NEW 10-Z4-06-JG-JE  1-GONE, I-NEW 1-17-11 MS, SS  TIE SKETCH  (Show at least four ties)  NAME 2-MIGH  NAME IN  HOLLOWING  NO TREE SIGN SW COR B.  COWE  1-12/6/95 JG-SS  New 12/6/95 JG-SS	Registered Land Surveyor DATE:
1- NEW TIE, 1- GONE COR OK 12/6/95 JG-SS  2-NEW TIES 3-20-01 JG  2-GONE 1-NEW 10-24-06-JG-JS  1-GONE, 1-NEW 1-17-11 MS, SS  TIE SKETCH  (Show at least four ties)  New 10-17-11 MS, SS  New 10-18-18  NAME 21-17-18  NAME IN 10-18-18  NO TREE SIGN SW COR 8.	Registered Land Surveyor DATE:
I-NEW TIE, I-GONE COR OK 12/6/95 JG-SS  2-NEW TIES 3-20-01 JG  2-GONE I-NEW 10-Z4-06-JG-JE  1-GONE, I-NEW 1-17-11 MS, SS  TIE SKETCH  (Show at least four ties)  NAME 2-MIGH  NAME IN  HOLLOWING  NO TREE SIGN SW COR B.  COWE  1-12/6/95 JG-SS  New 12/6/95 JG-SS	Registered Land Surveyor DATE:
I- NEW TIE, I- GONE COR OK 12/6/95 JG-SS  2-NEW TIES, 3-20-01 JG  2-GONE I-NEW 10-24-06-JG-JS  1-Gonc, I-New 1-17-11 MS, 55  TIE SKETCH  (Show at least four ties)  NOTICE SIGN SW COR OF SO SP 2249  ELE BOX  AT GROUND  1920  TRAIL  TREE	Registered Land Surveyor DATE:
THE SKETCH  (Show at least four ties)  Note: Sich SW COR OK 12/6/95 JG-SS  NOTE: Sich SW COR OK 12/6/95 JG-SS  NOTE: Sich SW COR OK 12/6/95 JG-SS  NOTE: Sich SW COR OF OF SOME CONE  SP ZZ49  ELE BOX  AT GROUND  TRAIL  TREE  TREE  TREE	Registered Land Surveyor DATE:
THE SKETCH  (Show at least four ties)  NOTICE SIGN SW COR OK 12/6/95 JG-SS  NOTICE SIGN SW COR OK 12/6/95 JG-SS  NOTICE SIGN SW COR OK 12/6/95 JG-SS  NOTICE SIGN SW COR OF SO WHITE PARTY AT GROUND 1943-100 MAIL IN TREE  TRAIL  TREE  TREE  TREE  TREE  TREE  TREE	Registered Land Surveyor DATE:
THE SKETCH  (Show at least four ties)  Notice Sign SW COR OR 12/6/95 JG-SS  NOTICE SIGN SW COR OR O	Registered Land Surveyor DATE:
THE SKETCH  (Show at least four ties)  NOTRES SIGN SW COR OK 12/6/95 JG-SS  NAIL 2'HIGH  AT GROUND  TRAIL  TELEPHONE  CABLE SIGNOD  NAIL 3' HIGH POST  NAIL 1N  NAIL 1N  NAIL 3' HIGH POST  NAIL 1N  NAIL	Registered Land Surveyor DATE:
I- NEW TIE, I- GONE COR OK 12/6/95 JG-SS  2-NEW TIES 3-20-01 JG  2-GONE I-NEW 10-24-06-JG-JS  1-GORC, I-NEW 1-17-11 MS, 55  THE SKETCH  (Show at least four ties)  (Show at least four ties)  NOTIFIES SIGN SW COR BY  NOTIFIES SIGN SW COR BY  PT GROWND 1445  TRAIL  TREE  TELE PHONE  CABLE SIGN OF  NORWAY  NO TREE SIGN OF  NAIL 3' HIGH POST  10" NORWAY  NE COR NO TREE SIGN OF  NORWAY  NE COR NO TREE SIGN	Registered Land Surveyor DATE:
THE SKETCH  (Show at least four ties)  NOTICE SIGN SW COR OR 12/6/95 JG-SS  1-GONE 1-NEW 10-17-11 MS, 55  THE SKETCH  (Show at least four ties)  NOTICE SIGN SW COR OF COR OR 12/6/95 JG-SS  THE SKETCH  (Show at least four ties)  NOTICE SIGN SW COR OF COR OR INCHIES INCHI	Registered Land Surveyor DATE:
I- NEW TIE, I- GONE COR OK 12/6/95 JG-SS  2-NEW TIES 3-20-01 JG  2-GONE I-NEW 10-24-06-JG-JS  1-GORC, I-NEW 1-17-11 MS, 55  THE SKETCH  (Show at least four ties)  (Show at least four ties)  NOTIFIES SIGN SW COR BY  NOTIFIES SIGN SW COR BY  PT GROWND 1445  TRAIL  TREE  TELE PHONE  CABLE SIGN OF  NORWAY  NO TREE SIGN OF  NAIL 3' HIGH POST  10" NORWAY  NE COR NO TREE SIGN OF  NORWAY  NE COR NO TREE SIGN	Registered Land Surveyor DATE:
I- NEW TIE, I- GONE COR OK 12/6/95 JG-SS  2-NEW TIES 3-20-01 JG  2-GONE I-NEW 10-24-06-JG-JS  1-GORC, I-NEW 1-17-11 MS, 55  THE SKETCH  (Show at least four ties)  (Show at least four ties)  NOTIFIES SIGN SW COR BY  NOTIFIES SIGN SW COR BY  PT GROWND 1445  TRAIL  TREE  TELE PHONE  CABLE SIGN OF  NORWAY  NO TREE SIGN OF  NAIL 3' HIGH POST  10" NORWAY  NE COR NO TREE SIGN OF  NORWAY  NE COR NO TREE SIGN	Registered Land Surveyor DATE: