ADAMS COUNTY COUNTY COUNTY CORNER NO: 56 ROMPORTOL ID: 41406172000


PUBLIC LAND SURVEY MONUMENT RECORD

HARRISON (BROKEN-TOP) TYPE OF MONUMENT: ADAMS COUNTY COORDINATES, NAD 83 (2007) N. 118577.272 E. 536471.900 DATUM_ 01/04/2021 FIELD WORK DATE:

BASIS FOR MONUMENT LOCATION

1976 - PLS 922 CHECKED ADAMS COUNTY SURVEY RECORDS AND MIS-STATE ASSOCIATE FILES. SURVEYOR VERNIE SCHULTZ DID NUMEROUS SURVEYS WHICH WERE TIED TO THIS CORNER. BACKED OUT THESE SURVEYS & SET THIS CORNER. FIT OCCUPATION WITHIN THE INTERIOR OF THIS SECTION GOOD. EDM TRAVERSE, REFERENCE SURVEYS ADAMS CO CSM #1 & SUNNY DELL SUBDIVISION. SEE SECTION COMPOSITE SHEET FOR OTHER IRON MONUMENTS.

2021 - PLS 2675 FOUND HARRISON (BROKEN-TOP) 16"± BELOW THE FIELD SURFACE AND 1 WITNESS. THE MONUMENT AGREES WITH THE WITNESS. ACCEPTED THE HARRISON (BROKEN-TOP) AS THE CORNER LOCATION. SET 4 NEW TIES AND MEASURED TO THE EXISTING WITNESS.

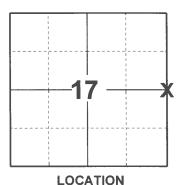

(INDICATE CORNER BY "X")



DATA SHOWN HERE ON THIS TIE SHEET IS CORRECT AND COMPLETE TO THE BEST OF MY KNOWLEDGE AND BELIEF

PROFESSIONAL LAND SURVEYOR

-TIE SKETCH



FIELD TREE LINE N59° 33' 56"E 16.41' FIELD SET 18"± DOWN SET 18"± DOWN

- SET 3/4" x 18" IRON REBAR, 1.50#/FT
- FOUND HARRISON (BROKEN-TOP) MONUMENT
- VINYL "T" POST
- WITNESS TREE

ADAMS COUNTY

Survey Monument Record

TYPE OF MONUMENT: HARRISON MONUMENT-QUARTER COR.


STATE PLANE COORDINATES: N_____

E_____

ELEVATION — M.S.L. DATUM: _____

THETA ANGLE:

FIELD BOOK: ______ PAGE _____

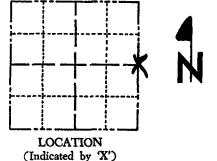

14 H

GE

CORNER NO.

SECTION

TOWN

RANGE

SEAL:

BASIS FOR MONUMENT LOCATION

(Use reverse side if necessary)

Show info such as: History of corner, with reference to Vol. and pg, dates, surveyor; exact description of monument replaced; if location computed, by taped or EDM traverse; landowner remarks, etc.

CHECKED ADAMS COUNTY SURVEY RECORDS

AND MID-STATE ASSOCIATES FILES. SURVEYOR

VERNIE SCHULTZ DID NUMEROUS SURVEYS

WHICH WERE TIED TO THIS CORNER. WE BACKED

OUT THESE SURVEYS & SET THIS CORNER.

FIT OCCUPATION WITHIN THE INTERIOR OF

THIS SECTION GOOD. EDM. TRAVERSE.

REFERENCE SURVEYS ADAMS CO. CSM#/

& SUNNY DELL SUBDIVISION. SEE SECTION

COMPOSITE SHEET FOR OTHER IRON MONUMENTS
CIRVER D.K 12-18-81 SK-DW
11 11 2-18-86 GR-55

11 6-20-91 JG

TOP BROKEN OFF, TIES OK 4-24-96 JG-SS

FREDERIC
W.
ZIETLOW
S-922
Baraboo
WIS.
OSURVE

CERTIFIED CORRECT:

Julius W. Zierbru


Registered Land Surveyor

DATE. JUNE 8, 1976

TIE SKETCH 2-CONE. 2-NEW 11-17 AC

(Show at least four ties) 2-CONE, 2-NEW, 11-13-06 - 56-55



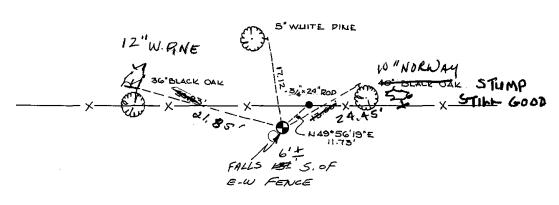

ALL TREES ARE BLAZED WITH PH NAILS & SHINERS

U.S. PUBLIC LAND SURVEY MONUMENT RECORD

Note:

This form is intended and designed to fulfill all requirements of Wisconsin Administrative Code, Chapter A-E 5.02, U.S.

conform with said requirements.	et may be added if necessary to
(a) Corner location: Township 14 North	
· · · · · · · · · · · · · · · · · · ·	
Range EastWest	
This arms Call Resume	
Town/Dity/Village <u>Fell Prairie</u>	
County Adams County	
	Section/7
(b) (f) (g) (h) Description of monument found at this corner and if it was acc (material, testimonial, occupational, plats, records, other monuments) used a not accepted or if nothing was found, state evidence used as basis for	as a basis for accepting. If establishing location. If
reestablished through lost corner proportionate methods, indicate all modifications used to establish.	numents, distances and
	i
c) (d) (e) Plan view of corner with ties to at least 4 witness monuments. If in disagestablished corner, show the distances between the two corners and also disputed corner.	reement with previously indicate the ties to the
	·
attimate of a section	
B" White Pine W/P.K.	•
36" Black ask W/RK (3) /3/4" Rebar fr" Black	Oak W/RK.
(X) X	
Fence 30.87. \$\\\\\\\\\\\\\\\\\\\\\\\\\\\\\\\\\\\\	
Harrison Manumen	†
EY4 COR. SEC. T	
north	

(i) I, James D. Prehn 6-1790 (type or print name) certify that the corner location on this record was determined by me or under my direction and control and that this U.S. Public Land Survey Monument Record is correct and complete to the best of my knowledge and belief.

Signature President

3-18-85 Date

