TOWN

06 RANGE

ADAMS COUNTY COUNTY CORNER NO: 59

ROMPORTOL ID: 414006142000


PUBLIC LAND SURVEY MONUMENT RECORD

HARRISON TYPE OF MONUMENT: ADAMS COUNTY COORDINATES, NAD 83 (2007) N 119062.443 E. 552275.108 ELEVATION- - - DATUM - - -FIELD WORK DATE: 12/22/2020


BASIS FOR MONUMENT LOCATION

1977 - PLS 1103 UPON FIELD INVESTIGATION OF THIS CORNER, FOUND EXISTING HARRISON MONUMENT IN PLACE. FROM THE BEARING TREES TO THE HARRISON, IT APPEARS THAT THIS MONUMENT WAS SET BY SAM MULLEN. COULD FIND NO EVIDENCE OF THE BEARING TREES AS SET BY THE ORIGINAL GOVERNMENT LAND SURVEY. DID NOT EXCAVATE AT THIS TIME. AS A NUMBER OF SURVEYS BY MID-STATE ASSOC. HAVE USED THIS CORNER.

2020 - PLS 2675 FOUND HARRISON 4"± BELOW ROAD SURFACE AND NO TIES OR WITNESSES, ACCEPTED THE HARRISON AS THE CORNER LOCATION. SET 3 NEW TIES AND MEASURED TO A FOUND PROPERTY IRON.

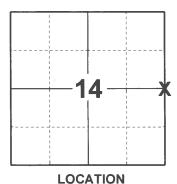

(INDICATE CORNER BY "X")

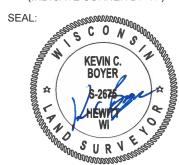

DATA SHOWN HERE ON THIS TIE SHEET IS CORRECT AND COMPLETE TO THE BEST OF MY KNOWLEDGE AND BELIEF.


PROFESSIONAL LAND SURVEYOR

-TIE SKETCH -

NOTE: CORNER IS 1'± EAST OF CENTERLINE OF 8TH AVE.



- SET 3/4" x 18" IRON REBAR, 1.50#/FT
- O FOUND 3/4" IRON ROD
- FOUND HARRISON MONUMENT
- STEEL FENCE POST
- → VINYL "T" POST

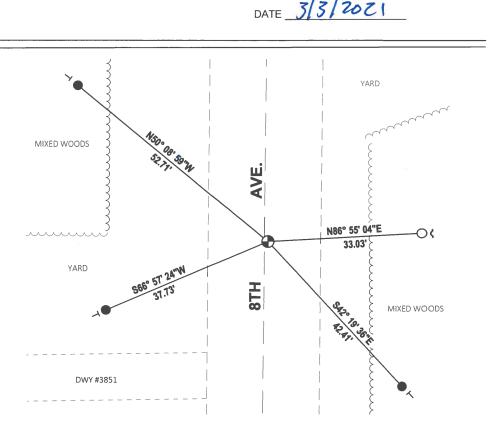

HOAMS			CORNER NO.	97
	County		SECTION	14
TYPE OF MONUM	MENT: HARRISON MONG	MENT	TOWN	14
STATE PLANE CO	OORDINATES: N			
ELEMATION A	E M.S.L. DATUM;		RANGE _	
	W.S.L. DATUM:			7
	57 PAGE _ 5			
	. RHINEHART			. . .
· · · · · · · · · · · · · · · · · · ·				* N
BASIS FOR MO	NUMENT LOCATION			
				İ
and pg., dates, sur	History of corner, with reference to Vol. veyor; exact description of monument			
replaced; ir location landowner remarks, e	computed, by taped or EDM traverse; etc. (Use reverse side if necessary)		LOCATION (Indicated by 'X')	
Upon field in	vestigation of this corne	r. found	SEAL:	
existing Harr	rison monument in place.	From the	- Military	F11000
bearing trees	to the Harrison, it appe		DALE (HAGEN S-1103 Wisconsin Ra Wis.	MINIMAN SIA
monummet was	set by Sam Mullen.		STATE OF THE PARTY	
Could find no	evidence of the of beari	ng trees as	DALE (
	riginal Government Land Sur		HAGEN S-1103	
·			Wisconsin Ra	
Did not excav	ate at this time, as a nu	mber of surveys	Wis.	103
	Assoc. have used this cor	ner.	Se O' Monney	EJE
ALL OK 11-	-1-90 JG-53		SUP	499898
" " 3-	5-01 M4-24		DATA SHOWN HERE ON	,•
	-06-JG-5S		CERTIFIED CORRECT:	
	~ 6 ~ 06-33		- Dale C. Hay	ر.
•			Régistered Land Surveyor	
			DATE: 9-6-77	
TIE SKETCH				08 ⁴⁸
	ies, also fence lines, roads, tono, size	Power		38 48 STREET ONE
Show at least four ti and type of witness	ies, also fence lines, roads, topo, size trees' and if off road - best way to	Power		O ac STEININ
Show at least four ti and type of witness arrive at corner.	trees' and if off road - best way to	Power Poce o	or the soor	PK STANI
Show at least four ti and type of witness and type corner. NOTE: Ties in trees	trees' and if off road - best way to	Power Poce o	or the soor	PK STATE
Show at least four ti and type of witness arrive at corner.	trees' and if off road - best way to	Power Poce of	10005 - 10005	A PINE
Show at least four ti and type of witness arrive at corner. NOTE: Ties in trees	trees' and if off road - best way to	Power Poce o	or the soor	A PINE
Show at least four ti and type of witness and type corner. NOTE: Ties in trees	trees' and if off road - best way to	Power Poce of	or the soor	A SOUTH STUMP
Show at least four ti and type of witness and type corner. NOTE: Ties in trees	trees' and if off road - best way to	Power Poce of	Soons TANING CONN.	PRIDEE STUM, STUMP, STUMP, 14"BLACK
Show at least four ti and type of witness arrive at corner. NOTE: Ties in trees	trees' and if off road - best way to	Posser 8 1000000	25 1 Noors 75 't Noors 2000 102 102 102 102	B' JACK B' JAC
Show at least four ti and type of witness and type corner. NOTE: Ties in trees	trees' and if off road - best way to	Posser 8 1000000	25 1 Noors 75 't Noors 2000 102 102 102 102	PRIDEE STUM, STUMP, STUMP, 14"BLACK
Show at least four ti and type of witness argue at corner. NOTE: Ties in trees nail in disc	trees' and if off road - best way to	POWER ASIA S	100000 TRAIN CONN. 75' T NORTH CONN. 102	A SOUTH STATE B' JACK B' JACK FINE STUNNA 14 "BLACK ONK NECK FOR GURLEY 230" BLACK ASTU
Show at least four ti and type of witness argue at corner. NOTE: Ties in trees nail in disc	trees' and if off road - best way to to	POWER POLE SOLE SOLE SOLE SOLE SOLE SOLE SOLE S	100005 TRAIL 75'\$ NORTH CONN.	B' JACK B' JAC
Show at least four ti and type of witness and type of witness MOTE: Ties in trees nail in disc MAINT	to to ENANCE RECORD Remarks	POWER POWER SOLO SOLO SOLO SOLO SOLO SOLO SOLO SOL	100000 TOWN TO TOWN CONN. 75'\$ NORTH CONN. 43.60 43.60	A SOUTH STATE B' JACK B' JACK FINE STUNNA 14 "BLACK ONK NECK FOR GURLEY 230" BLACK ASTU
Show at least four ti and type of witness and type of witness argive at corner. NOTE: Ties in trees nail in disc MAINT	to to Way to to Way to	POWER POLE SOCIO POLICE PORIUEUMY 7 HSE # 3851 Z5't South	100000 TOWN TO TOWN CONN. 75'\$ NORTH CONN. 43.60 43.60	BY JACK BY
Show at least four ti and type of witness and type of witness and type of witness Ties in trees nail in disc MAINT Date Init. 3-26-86 GR- S.	to to ENANCE RECORD Remarks High 1150 7155	POWER POLE SOCIO SOCI	100000 TOWN TO TOWN CONN. 75'\$ NORTH CONN. 43.60 43.60	B' JACK B' BLACK B'
Show at least four ti and type of witness and type of witness and type of witness Ties in trees nail in disc MAINT Date Init. 3-26-86 GR- S.	to to ENANCE RECORD Remarks High 1150 7155	POWER POLE SOCO	100005 TRAIL 75'\$ NORTH CONN. 43.60	B' JACK B' JACK B' JACK B' JACK B' JACK B' BLACK OAK HELK FOR GUZUEY STULL BLACK BLACK STULL BLACK BLACK STULL BLACK BLACK BLACK STULL BLACK BL
Show at least four tigand type of witness in trees in trees nail in disc MAINT Date Int. 3-26-86 GR- S:	to to ENANCE RECORD Remarks High 1150 7155	POWER POLE SOCIO SOCI	100000 TOWN TO TOWN CONN. 75'\$ NORTH CONN. 43.60 43.60	A SO BEACH SALES B' JACK B' JACK B' JACK GO STUNN 14"BLACK OAK 14"BLACK OAK BLACK OAK FILLD DE FILLD DE