SECTION

OB ADAMS COUNTY

COUNTY CORNER NO: **67**

ROMPORTOL ID: 41406160000

PUBLIC LAND SURVEY MONUMENT RECORD

TYPE OF MONOMENT:	HARRISUN	
ADAMS COUNTY COORDINATES,	, NAD 83 (2007)	
N. 115963.060		
N. 110300,000		
E 544707.047		
E. <u>541727.647</u>		


06/22/2017 FIELD WORK DATE:

BASIS FOR MONUMENT LOCATION

ELEVATION- - - DATUM - - -

1976 - PLS 922 AFTER AN EXTENSIVE TRAVERSE OF ADJOINING SECTIONS AND LOCATING THE W1/4 AND SW CORNER OF SECTION 22. EXCAVATED AND FOUND NO EVIDENCE OF THE CORNER. FOUND THE REMAINS OF BARRETT'S BEARING TREE, SEE VOLUME 2 PAGE 163 OF ADAMS COUNTY SURVEY RECORDS. CORNER FALLS IN A ROAD CUT AND WAS GRADED OUT SINCE BARRETT SET THE PIPE IN APRIL OF 1895. SET A HARRISON MONUMENT AT THE CORRECT BEARING AND DISTANCE FROM THE REMAINS OF THE BEARING TREE AND SET 4 WITNESSES.

2017 - PLS 2994 FOUND HARRISON MONUMENT 12" BELOW THE ROAD SURFACE AND 1 DISTURBED TIE. THE MONUMENT AGREES WITH THE DISTANCE CALL TO THE CENTERLINE OF 10TH AVE. ACCEPTED HARRISON AS CORNER LOCATION, SET 3 NEW TIES AND RE-MEASURED TO THE EXISTING TIE.

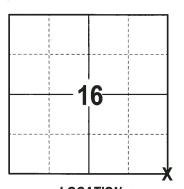

LOCATION (INDICATE CORNER BY "X")



DATA SHOWN HERE ON THIS TIE SHEET IS CORRECT AND COMPLETE TO THE BEST OF MY KNOWLEDGE AND BELIEF.

PROFESSIONAL LAND SURVEYOR


7-14-17 DATE

- TIE SKETCH

NOTE: THE CORNER FALLS 4'± EAST OF THE CENTERLINE OF 10TH AVE.



- 3/4" x 18" IRON REBAR SET, 1.50#/FT
- 3/4" IRON ROD FOUND
- HARRISON FOUND STEEL FENCE POST
- → VINYL "T" POST

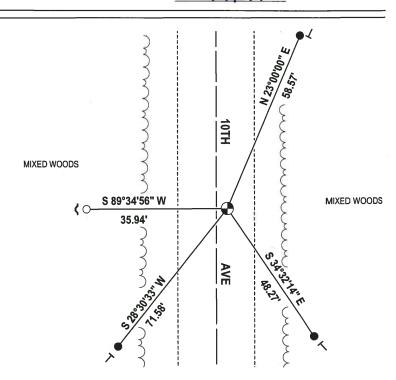

ADAMS COUNTY	CORNER NO	483
Survey Monument Record	SECTION _	22
TYPE OF MONUMENT: 30" HARRISON	TOWN _	<u> 14 N</u>
STATE PLANE COORDINATES: N	RANGE _	6 E
ELEVATION — M.S.L. DATUM: THETA ANGLE: FIELD BOOK: PAGE	*] 4 N
BASIS FOR MONUMENT LOCATION		
(Use reverse side if necessary)		
Show info such as: History of corner, with reference to Vol. and pg, dates, surveyor; exact description of monument replaced; if location computed, by taped or EDM traverse; landowner remarks, etc.	LOCATION (Indicated by 'X') SEAL:	
AFTER EXTENSIVE EDM TRAVERSE OF ADJOINING SECTIONS & LOCATING THE WY & SW CORS. OF THIS SECTION, WE EXCAVATED AND FOUND NOTHING. WE LOCATED BARRETTS BEARING TREE REMAINS & BACKED OUT THE PROPER BRG. & DISTANCE TO SET THIS CORNER SEE VOLUME 2 PAGE 163 OF ADAMS COUNTY SURVEY RECORDS. THIS CORNER FALLS IN A ROAD CUT & WAS APPARENTLY GRADED OUT SINCE BARRETT SET THE PIPE IN APRIL OF 1895.	FREDERIC W. ZIETLOW S-922 Baraboo WIS. OSURVEIN	Annamanning.
SURVEYORS NOTE: THIS DOSSIER REPLACES DOSSIER OF 8-27-74 CORNER O.K. 11-2-76 RN-55	CERTIFIED CORRECT: July Correct Registered Land Surveyor	for the same of th
MON. Beepe 12-17-81 SK-DW	DATE: 2014 22, 19	76
TIE SKETCH 6K 2-6-86 GR-SS (Show at least four ties) COR OK 12/6/95 JG-55 (Show at least four ties) COR OK 12/6/95 JG-55 (Show at least four ties) COR OK 12/6/95 JG-55 (Show at least four ties) COR OK 12/6/95 JG-55 (Show at least four ties) COR OK 12/6/95 JG-55 (Show at least four ties) COR OK 12/6/95 JG-55 (Show at least four ties) COR OK 12/6/95 JG-55 (Show at least four ties) COR OK 12/6/95 JG-55 (Show at least four ties) COR OK 12/6/95 JG-55 (Show at least four ties) COR OK 12/6/95 JG-55 (JOHN OF TIES) COR OK 12/6/95 JG-55 (Show at least four ties) COR OK 12/6/95 JG-55 (Show at least four ties) COR OK 12/6/95 JG-55 (JOHN OF TIES) COR OK 12/6/95 JG-55	POLE GONE	4
STUMP NAIL IN 20" RED OAK T NAIL STILL GOOD STUMP" NAIL IN IB" RED OAK NAIL STILL GOOD (BARRETT'S B.T.)	PURIL IN 9"TWIN A	SPEN/