06 ADAMS COUNTY COUNTY CORNER NO: 69 POMPORTOLID: 414061500

ROMPORTOL ID: 41406150000


PUBLIC LAND SURVEY MONUMENT RECORD

HARRISON TYPE OF MONUMENT:_ ADAMS COUNTY COORDINATES, NAD 83 (2007) N. 116227.648 E. 546966.788 ELEVATION- - — DATUM FIELD WORK DATE: 12/23/2020


BASIS FOR MONUMENT LOCATION

1975 - PLS 922 FOUND 3/4" IRON BAR SET BY SURVEYOR DAVE CLARK DECEMBER OF 1969. CHECKED OLD COUNTY SURVEY NOTES AND COULD NOT FIND ANY RE-SURVEYS ON FILE.

2020 - PLS 2675 FOUND HARRISON FLUSH WITH THE GROUND AND 4 WITNESS TREES. THE MONUMENT AGREES WITH ALL 4 WITNESS TREES. ACCEPTED THE HARRISON AS THE CORNER LOCATION. SET 4 NEW TIES AND MEASURED TO THE EXISTING WITNESS TREES.

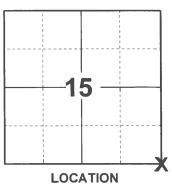

(INDICATE CORNER BY "X")

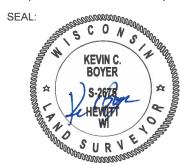


DATA SHOWN HERE ON THIS TIE SHEET IS CORRECT AND COMPLETE TO THE BEST OF MY KNOWLEDGE AND BELIEF.

PROFESSIONAL LAND SURVEYOR

-TIE SKETCH



- SET 3/4" x 18" IRON REBAR, 1.50#/FT
- FOUND HARRISON MONUMENT
- STEEL FENCE POST
- VINYL "T" POST
- WITNESS TREE

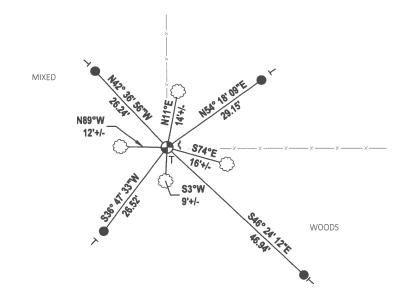

ADAMS COUNTY	CORNER NO. 605
Survey Monument Record Set Harrison 4-28-75	SECTION 15
TYPE OF MONUMENT: 2" x 30" IRON PIPE	TOWN
STATE PLANE COORDINATES: N	RANGE 6
E	·
ELEVATION — M.S.L. DATUM:	
THETA ANGLE: PAGE	
BASIS FOR MONUMENT LOCATION	
(Use reverse side if necessary)	
Show info such as: History of corner with reference to Vol	LOCATION
and pg, dates, surveyor; exact description of monument replaced; if location computed, by taped or EDM traverse; landowner remarks, etc.	(Indicated by 'X') SEAL:
Found 3/4" iron bar set by surveyor Dave	ZIETLOW S-922 Baraboo Wis.
Clark December of 1969. Checked old county survey notes and could not find	FREDERIC
any re-surveys on file.	FREDERIC W. ZIETLOW S-922 Baraboo WIS.
CORNER O.K. 10-29-76	ZIETLOW
COPNER 0. × 12-17-81 5K- DW	\$-922
1. 3-17-86.	Wis.
11 7-15-91 55-56	
4 5-16.96 55	WIND SURVINION
ALL OK 3-20-01-JG ALL OK 10-24-06 JG-JS	
ALL OK 10-24-06 JC-JS OK 12-12-11 MS	CERTIFIED CORRECT:
	Frederic W. Zcolon Registered Land Surveyor
	DATE: $\rightarrow A \sim 29$, 1975
TIE SKETCH (av -	
TIE SKETCH (Show at least four ties)	SURVEYOR'S NOTE: This corner will be monumented
The state of the s) with a Harrison Marker
NAIL & BLAZZ	$\frac{b}{b}$ in the Spring of 1975.
12" RED OAK	
F	37
	6/
000 x x 20'±	FENCE
7" RED OAK (11.40 15.90')	3 12" RED OAK
S /gr /g) 12" RED OAK NAIL & BLAZE
/%	-
$ \bigcirc $	
10" RED OAK	DO NOT DISTURB SIGN
10" RED OAK MAIL & BLAZE/	ON 2" White Oak 3' South

CORNER

1986