OG RANGE ADAMS COUNTY CORNER NO: 70 ROMPORTOLID: 414061400

ROMPORTOL ID: 41406140020

PUBLIC LAND SURVEY MONUMENT RECORD

HARRISON TYPE OF MONUMENT: ADAMS COUNTY COORDINATES, NAD 83 (2007) N. 116340.533 E. 549596.236 ELEVATION- - - DATUM 12/23/2020 FIELD WORK DATE:


BASIS FOR MONUMENT LOCATION

1974 - PLS 922 USED 2 DIRECTION FENCE CORNER (WEST & NORTH) FIT GOOD WITH TRANSIT-TAPE TRAVERSE. SET HARRISON.

2020 - PLS 2675 FOUND HARRISON FLUSH WITH THE GROUND AND 3 WITNESS TREES. THE MONUMENT AGREES WITH ALL 3 WITNESSES TREES. ACCEPTED THE HARRISON AS THE CORNER LOCATION. SET 4 NEW TIES AND MEASURED TO THE EXISTING WITNESS TREES.



(INDICATE CORNER BY "X")

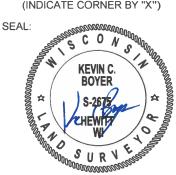

DATA SHOWN HERE ON THIS TIE SHEET IS CORRECT AND COMPLETE TO THE BEST OF MY KNOWLEDGE AND BELIEF.


PROFESSIONAL LAND SURVEYOR

DATE

-TIE SKETCH

NOTE: A WITNESS TREE LANDS N40°W, 9'± FROM THE CORNER LOCATION.



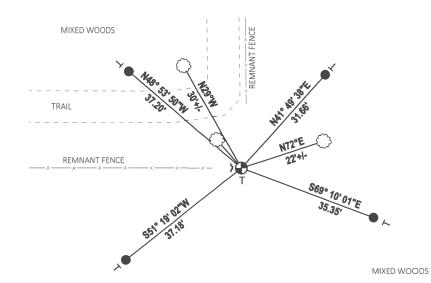

- SET 3/4" x 18" IRON REBAR, 1.50#/FT
- FOUND HARRISON MONUMENT
- STEEL FENCE POST
- VINYL "T" POST
- WITNESS TREE

			(70)
ADAMS COUNTY		CORNER NO.	477
Survey Monument Record		SECTION	23
TYPE OF MONUMENT: 30" HARRISON		TOWN	14
STATE PLANE COORDINATES: N		RANGE	6
		IUMIGE.	
ELEVATION — M.S.L. DATUM:		 	7 /
THETA ANGLE:			
FIELD BOOK: 429 PAGE ZZ			
	,	 	- 41
BASIS FOR MONUMENT LOCATION			
(Use reverse side if necessary)			
Show info such as: History of corner, with reference to Vol.		LOCATION	
and pg, dates, surveyor; exact description of monument replaced; if location computed, by taped or EDM traverse; landowner	SEAL:	(Indicated by 'X')	•
remarks, etc.			
· · · · · · · · · · · · · · · · · · ·		WILLIAM CONTRACTOR	
	: 3	MISOONSWIN	
•		FREDERIC	1/2
	'i	W	=
USED 2 DIRECTION FENCE	Ξ.,	ZIETLOW	* =
CORNER (WEST & NORTH)		Baraboo	11,
FIT GOOD WITH TRANSIT-	_	wis.	
TAPE TRAVERSE	"	(Indicated by X') SOONS FREDERIC W. ZIETLOW S-922 Baraboo WIS. O SURVE	
CORNER O.K. 10-29.76 GR-DU		Minning	
LORDOR ON 12-17-81 SK-DW	1	·	
			4
	CERTI	CORRECT:	> //
ALL OK 11-1-90 JG-55	(+1	Weller W. C	allow
Z NEW TIES 10-11-01 55		ed Land Surveyor	cf
2 / 121 / 123 / 1 1 1	DATE:	0 2 1 1	/
TIE SKETCH ALLOK 11-13-06-JG		· · · · · · · · · · · · · · · · · · ·	
(Show at least four ties)			Λ.
Contain the system of the syst	•		- /\
			V
S'TACK PINE 'OI			
PINE OIL			
27 3/9	7"3.0	AK	
2	- Leve	101	人
BUTTER STATE OF THE STATE OF TH	1 //	·	
87 00	2 7"	BLK	. W
	POS COR I	DAK OI NO	PRTH
FENCE DOWN	1 21,75	•	÷
15.00			
THE BOAK DO	200	· V .	
, 5.3V	(i) /2	"B. OKK	•
		161	

