SECTION

OB ADAMS COUNTY

COUNTY CORNER NO: 76

ROMPORTOL ID: 41406202000

PUBLIC LAND SURVEY MONUMENT RECORD

TYPE OF MONUMENT: **HARRISON** ADAMS COUNTY COORDINATES, NAD 83 (2007)

N. **113286.094**

E. 536440.758


ELEVATION-DATUM_ - ----

06/21/2017 FIELD WORK DATE:


BASIS FOR MONUMENT LOCATION

1979 - PLS 1478 FOUND FLATTENED PILE OF SANDSTONE AND BEARING TREE STUMP. THE BEARING TREE STUMP IS RECORDED IN ADAMS COUNTY SURVEYOR'S NOTES FIELDBOOK 2 PAGE 164 BY A. J. BARRETT. VERIFIED CORNER LOCATION BY TRAVERSE TO THE NE CORNER OF SECTION 20 AND TO THE MEANDER CORNER ON THE EAST BANK OF THE WISCONSIN RIVER, BETWEEN SECTION 20 &21 T14N, R6E.

2017 - PLS 2994 FOUND HARRISON MONUMENT FLUSH WITH THE GROUND, 1 TIE AND 3 WITNESSES. THE MONUMENT AGREES WITH THE EXISTING TIE AND WITNESSES. ACCEPTED HARRISON AS CORNER THE LOCATION. SET 3 NEW TIES AND RE-MEASURED TO THE TIES AND

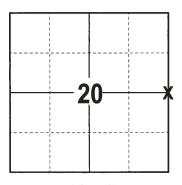

LOCATION (INDICATE CORNER BY "X")

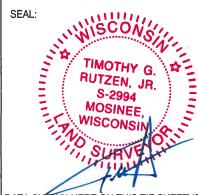

DATA SHOWN HERE ON THIS TIE SHEET IS CORRECT AND COMPLETE TO THE BEST OF MY KNOWLEDGE AND BELIEF.

PROFESSIONAL LAND SURVEYOR

DATE 7-14-17

- TIE SKETCH

NOTE: THE CORNER FALLS 21'± EAST OF THE CENTERLINE OF A NORTH AND SOUTH TRAIL, AND 22'± SOUTH OF THE CENTERLINE OF A EAST AND WEST




3/4" x 18" IRON REBAR SET, 1.50#/FT 1-1/4" O.D. IRON PIPE FOUND

HARRISON FOUND → VINYL "T" POST

MITNESS TREE STUMP FOUND

WITNESS TREE FOUND

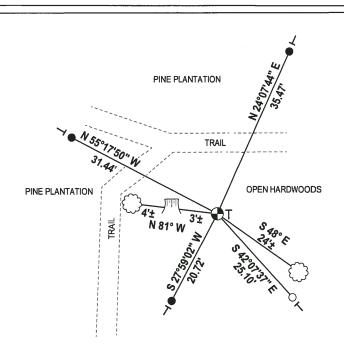

Government Land Co	rner Certificate	HAK. SET	over.	<u> </u>
ADAMS	County		CORNER NO.	
TYPE OF MONUMENT: HARRIS	ON STANDARD Thomas	1 in to be of	SECTION	_ 20
STATE PLANE COORDINATES:		- Coprage	TOWN	
	E		RANGE	6
ELEVATION — M.S.L. DATUM:	·			_
THETA ANGLE: FIELD BOOK:83	DAGE /3	· ·		
DRAWN BY: G. RHINEHART			2.0	
			120	* N
BASIS FOR MONUMENT LO	CATION			
Show info such as: History of corner	with reference to Vol			ĺ
and pg., dates, surveyor; exact desceplaced; if location computed, by ta	ription of monument ped or EDM traverse;		LOCATION	
andowner remarks, etc. (Use reverse	side if necessary)	SE	AL: (Indicated by 'X')	
			WHITE COAMINA	le.
Found flattened pile of	sandstone and bea	ring	GREGORY P. RHINEHART S-1478 Wisconsin Rapids Wis.	N. Maria
tree stump. The bearing	tree stump is reco	rded in	TY CHECODY P	
Adams County surveyor's by A. J. Barrett.	notes Fieldbook 2	page 164	RHINEHART	/ ¹ =
			Wisconsin Rapids	
The location of this cor			Wis.	
traverse to the NE corne the Meander Corner,on th		- ·	A A COMPANIE OF THE PARTY OF TH	(0, 10, 10)
lisconsin River, between			SURVE SURVE	100gs
R6E.	C14			
2021/22 D.K 12-18-81	SK. DW GR- 55	D.	ATA SHOWN HERE ON ERTIFIED CORRECT:	
u u 6-20-9		5.	Mas om P	eli da
11 11 4-24-96	JG-55	Re	egistered Land Surveyor	, , , , , , , , , , , , , , , , , , ,
2-NEW TIES MON OK 3-13 ALL OK, 11-28-06 T	-02, - JG	D	ATE: 12/19/79	
2 NEW 7-5-11	55			
ΓΙΕ SKETCH -	× ×	× × _	×	κ
Show at least four ties, also fence line	es, roads, topo, size	1 1		
nd type of witness trees' and if off rrive at corner.	roaa - best way to	PLANTATION		
		apri		
	w	PU)574 i *	
 }		W0005	-9	
		TR	aic.	•
	DEAD"		189	
	5" CHERRY			
- 8"POPCA	e 4.0 18 2.45	Aa	12.	
		18.52'	-".0	
		1 2 (2)	7" POPLAR BONE	
	20 =	2:	3.9 & L" MAP	is W
يبادد ال	33.75	6" MAPLE		
01 81	K OAK (M	DHO SIGN FACES NORTH	1"X 24" IRON PIPE SET	A FACE
Y			OF BT. BY BARRETT	PER
,	2000 12 12 12 12 12 12 12 12 12 12 12 12 12	BUR DAK	FIELD BOOK Z PAGE	164.
	1 / 1 (A) 1 AIM	1 - \ 10/\		

MAINTENANCE RECORD

DATE	BY WHOM	REMARKS
		•
		,
<u> </u>		:
<u> </u>	<u> </u>	
<u> </u>		
L		