OB ADAMS COUNTY

COUNTY CORNER NO: 77

ROMPORTOL ID: 41406212000

PUBLIC LAND SURVEY MONUMENT RECORD

TYPE OF MONUMENT: **HARRISON** ADAMS COUNTY COORDINATES, NAD 83 (2007)

N. **113328.689**

E. 541701.841

DATUM_____ ELEVATION-


FIELD WORK DATE:

06/22/2017


BASIS FOR MONUMENT LOCATION

1976 - PLS 922 AFTER EXTENSIVE TRAVERSE OF ADJACENT SECTIONS AND FINDING THE SOUTHWEST CORNER OF SECTION 22, THEY EXCAVATED AND FOUND A 1" IRON PIPE SURROUNDED BY STONES 20" BELOW THE SURFACE OF THE ROAD. SEE VOLUME 2 PAGE 163 OF ADAMS COUNTY SURVEY RECORDS BY CO. SURVEYOR BARRETT APRIL OF 1895. SET A HARRISON MONUMENT AT CORNER LOCATION AND TIED OUT.

2017 - PLS 2994 FOUND HARRISON MONUMENT 6" BELOW THE SURFACE AND 3 WITNESSES. THE MONUMENT AGREES WITH THE EXISTING WITNESSES. ACCEPTED HARRISON AS THE CORNER LOCATION, SET 4 NEW TIES AND RE-MEASURED TO THE EXISTING WITNESSES.

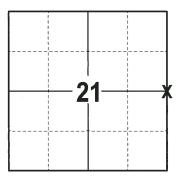

LOCATION (INDICATE CORNER BY "X")

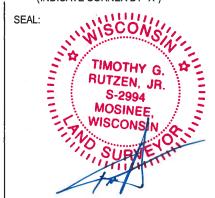

DATA SHOWN HERE ON THIS TIE SHEET IS CORRECT AND COMPLETE TO THE BEST OF MY KNOWLEDGE AND BELIEF.

PROFESSIONAL LAND SURVEYOR

7-14-17

- TIE SKETCH

NOTE: THE CORNER FALLS 6'± WEST OF THE CENTERLINE OF 10TH AVE.




3/4" x 18" IRON REBAR SET, 1.50#/FT

HARRISON FOUND

WITNESS FIRE NO. 3944 SIGN FOUND

VINYL "T" POST

WITNESS TREE FOUND

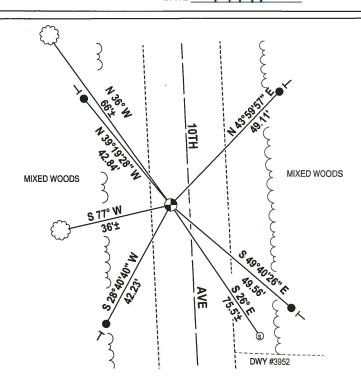

486 ADAMS COUNTY CORNER NO. 22 SECTION Survey Monument Record NYI TYPE OF MONUMENT: 15" HARRISON MON. TOWN RANGE STATE PLANE COORDINATES: N_ ELEVATION - M.S.L. DATUM: __ THETA ANGLE: _____ PAGE _ FIELD BOOK: _ BASIS FOR MONUMENT LOCATION (Use reverse side if necessary) LOCATION Show info such as: History of corner, with reference to Vol. and pg, dates, surveyor; exact description of monument replaced; if location computed, by taped or EDM traverse; landowner ZIETLO" (Indicated by 'X') SEAL: remarks, etc. AFTER EXTENSIVE E.D.M. TRAVERSE OF ADJACENT SECTIONS AND FINDING THE SOUTHWEST CORNER OF THIS SECTION WE EXCAVATED A FOUND I" IRON PIPE SURROUNDED BY STONE DOWN 20" BELOW SURFACE OF ROAD. SEE VOLUME 2 PAGE 163 OF ADAMS COUNTY SURVEY RECORDS BY CO. SURVEYOR BARRETT APRIL OF 1895. SURVEYORS NOTE: THIS DOSSIER CERTIFIED CORRECT: REPLACES DOSSIER OF 8-27-74 Frederic W. Zierton CORNER OK 6-20-91 - JG Registered Land Surveyor DATE: JULY 22, 1976 COR OK 12/6/95 JG-55 TIE SKETCH 2-GONE, 4 TIES LEFT, MONIOK 7-6-01 - JG OK, 11-14-06 -JG DEAD STANDING STILL STANDING (Show at least four ties) DEAD PK & SHINER HN-B" JACK PINE 10 STILL STANDING PETO 10" JACK SET 34"X24" PING 33.00' 6"W. PINE IRON BAR 6" MAPLE FIRE NO. 3944 SIGN POST UTILITY POLE P.K. & SHIDER

6" BURR OAK