## ADAMS COUNTY COUNTY CORNER NO: 79 ROMPORTOL ID: 41406232000

## PUBLIC LAND SURVEY MONUMENT RECORD


**HARRISON (BROKEN-TOP)** TYPE OF MONUMENT: ADAMS COUNTY COORDINATES, NAD 83 (2007) N. 113800.295 E. 552242.491 - — — DATUM\_ 01/05/2021 FIELD WORK DATE:

## BASIS FOR MONUMENT LOCATION


1977 - PLS 1103 RAN EDM/T2 TRAVERSE BETWEEN NORTHWEST AND SOUTHWEST CORNERS OF SECTION 24 TO DETERMINE SEARCH AREAS FOR INVESTIGATION. COULD FIND NO EVIDENCE OF THE ORIGINAL CORNER, REMONUMENTATION OR ACCESSORY MONUMENTS. SET CORNER BY SINGLE PROPORTIONATE MEASURE ON LINE BETWEEN ADJACENT SECTION CORNERS. SET HARRISON MONUMENT.

2021 - PLS 2675 FOUND HARRISON (BROKEN-TOP) FLUSH WITH THE GROUND AND 1 WITNESS TREE. THE MONUMENT AGREES WITH THE WITNESS TREE. ACCEPTED THE HARRISON (BROKEN-TOP)

AS THE CORNER LOCATION. SET 4 NEW TIES AND MEASURED TO THE EXISTING WITNESS TREE.

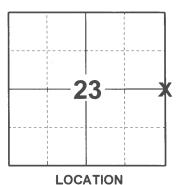

(INDICATE CORNER BY "X")

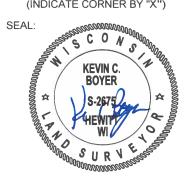


DATA SHOWN HERE ON THIS TIE SHEET IS CORRECT AND COMPLETE TO THE BEST OF MY KNOWLEDGE AND BELIEF.

PROFESSIONAL LAND SURVEYOR

2021

## -TIE SKETCH



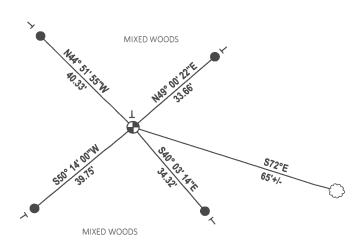

- SET 3/4" x 18" IRON REBAR, 1.50#/FT
- FOUND HARRISON (BROKEN-TOP) MONUMENT
- VINYL "T" POST
- WITNESS TREE

ADAMS COUNTY	corner no. $79$
Survey Monument Record	SECTION 24
TYPE OF MONUMENT: Harrison	TOWN
STATE PLANE COORDINATES: N	RANGE6
ELEVATION — M.S.L. DATUM:  THETA ANGLE: FIELD BOOK:38PAGE35	* 24 A
BASIS FOR MONUMENT LOCATION	-
(Use reverse side if necessary)	
Show info such as: History of corner, with reference to Vol. and pg, dates, surveyor; exact description of monument replaced; if location computed, by taped or EDM traverse; landowner remarks, etc.	LOCATION (Indicated by 'X') SEAL:
Ran EDM/T2 traverse between Northwest and Southwest corners of Section 24 to determine search areas for investigations	THE CONSTALL
Could find no evidence of the original corner, remonumentation or any accessory monuments.	DALE C. HAGEN S-1103
Set corner by siggle proportionate measure on line between adjacent section corners.	DALE C. HAGEN S-1103 Wisconsin Rapids, Wis.
Set Harrison on 3-25-77.  Corner D.K 12-17-81 SK-DW  GG 6-86 SP 55	SURVINION TO STATE OF THE STATE
TOO BROKEN NEE 2-18-91 JG-CR	CERTIFIED CORRECT:
" 3 NEW TIES 5-16-96 55"	Registered Land Surveyor
age " 11-13-06 STS	DATE: 5-31-77 <b>U</b>
TIE SKETCH PART (10" W. PINE '96	
(Show at least four ties) 573777 96 27 OK'01	W)
(Show at least four ties)  Thun 14"  BLACK DAK  516N  516N	6" BLACK STURE '96
(Show at least four ties)  Thun 1911  Reach Oak  NOTE  NOTE	L"BLACK STUND '91
(Show at least four ties)  NOTE  Ties in trees to nail in disc	6"BLACK STUND '96
(Show at least four ties)  NOTE  Ties in trees to nail in disc	6"BLACK STUNDE '96
(Show at least four ties)  The sin trees to nail in disc.  16"BIK.  OAK O 1  ADD  SIGN O  ADD  S	6"8 LACK STURE '96 ONE WAIL OF N  8" J C 1 N STUMP O?  16.6 2 STUMP O?