21 SECTION

TYPE OF MONUMENT:

## OB ADAMS COUNTY

COUNTY CORNER NO: 86

ROMPORTOL ID: 41406210020

## PUBLIC LAND SURVEY MONUMENT RECORD


ADAMS COUNTY COORDINATES, NAD 83 (2007)
N. <u>110685.902</u>
E. <u>539066.570</u>
ELEVATION- — — DATUM — — —
FIELD WORK DATE: 07/12/2017

**HARRISON** 

## BASIS FOR MONUMENT LOCATION

1976 - PLS 922 CHECKED ADAMS COUNTY SURVEY RECORDS AND FOUND THAT IN APRIL OF 1895, CO. SURVEYOR BARRETT DID AN EXTENSIVE AMOUNT OF SURVEYS IN THIS AREA. SEE VOL. 2, PAGE 163 A.C.S.R. BARRETT DID NOT REMONUMENT THIS CORNER. RECOVERED STONES AND IRONS AT THE N1/16 CORNER, NE1/4 CORNER AND THE NE CORNER OF SECTION 28. RAN E.D.M TRAVERSE AND PUT THE N1/4 CORNER AT DOUBLE THE DISTANCE AND ON A LINE PROJECTED FROM THE NE CORNER THROUGH THE 1/16 CORNER TO THE WEST. EXCAVATED BY HAND AND FOUND NO EVIDENCE OF THE ORIGINAL CORNER. SET HARRISON MONUMENT AND TIED OUT.

2017 - PLS 2994 FOUND HARRISON MONUMENT 6" ABOVE THE GROUND SURFACE AND 3 WITNESSES. THE MONUMENT AGREES WITH THE EXISTING WITNESSES. ACCEPTED HARRISON MONUMENT AS THE CORNER LOCATION. SET 4 NEW TIES AND RE-MEASURED TO THE EXISTING WITNESSES.

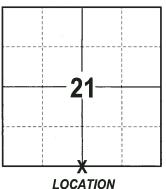

(INDICATE CORNER BY "X")

SEAL:




CORRECT AND COMPLETE TO THE BEST OF MY KNOWLEDGE AND BELIEF.

PROFESSIONAL LAND SURVEYOR


DATE

- TIE SKETCH

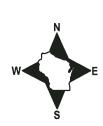

WITNESS TREE FOUND

3/4" x 18" IRON REBAR SET, 1.50#/FT HARRISON FOUND VINYL "T" POST

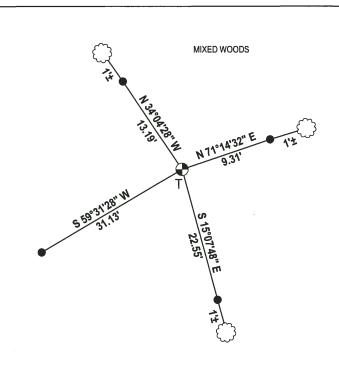

## 998 CORNER NO. . ADAMS COUNTY 28 SECTION Survey Monument Record 14N TYPE OF MONUMENT: 30" STANDARD HARRISON TOWN 6E RANGE STATE PLANE COORDINATES: N. ELEVATION — M.S.L. DATUM: \_ THETA ANGLE: 525 FIELD BOOK: **PAGE** BASIS FOR MONUMENT LOCATION (Use reverse side if necessary) LOCATION Show info such as: History of corner, with reference to Vol. ZIETLOW S-922 Bara' (Indicated by 'X') and pg, dates, surveyor; exact description of monument replaced; if location computed, by taped or EDM traverse; landowner remarks, etc. CHECKED ADAMS COUNTY SURVEY RECORDS AND FOUND THAT IN APRIL OF 1895, Co. SURVEYOR BARRETT DID AN EXTENSIVE AMOUNT OF SURVEYING IN THIS AREA. SEE VOLZ, PAGE 163 A.C.S.R. BARRETT DID NOT REMONUMENT THIS CORNER. WE RECOVERED STONES & IRONS AT THE NYIG COR NELY AND AT THE NE COR OF SEC. 28. WE RAN AN EDM. TRAVERSE AND PUT THE NYY COR AT DOUBLE THE DISTANCE & ON LINE PROSECT FROM THE NE COR THRU THE , VIG COR TO WEST. EXCAUATED BY HAND CERTIFIED CORRECT: & COULD FIND NO EVIDENCE OF ORIGINAL Fracis W. Zielow CORNER IN THIS VICINITY. Registered Land Surveyor 12-17-81 SK-DW CORNER OK AUGUST 16, 2-12-86 GK-55 OK TIE SKETCH ALLOK 3-25-91 GR-JG (Show at least four ties) Z-26-96 - INEW-55 OK 3-7-02-56 ALL OK, 11-28-06-56.55 4-7-11

