28 SECTION

OB ADAMS COUNTY

COUNTY CORNER NO: 97

ROMPORTOL ID: 41406282000

PUBLIC LAND SURVEY MONUMENT RECORD


TYPE OF MONUMENT:	1-1/2" O.D. IRON PIPE
ADAMS COUNTY COORDINATES, I	NAD 83 (2007)
N. <u>108068.782</u>	
E. 541668.746	
ELEVATION DAT	·UM
FIELD WORK DATE: 07/05/20	017

BASIS FOR MONUMENT LOCATION

1895 - CO. SURVEYOR A.J. BARRETT SET A GAS PIPE AS THE CORNER.

1976 - PLS 922 FOUND GAS PIPE, BUT COULD NOT REMOVE TO PLACE A HARRISON AS IT WAS WELL GROWN INTO THE ROOT SYSTEM OF A 12" BURR OAK. ALSO FOUND 3 TAPERED STONES AROUND THE PIPE, WHICH WERE EVIDENTLY PLACED BY BARRETT. SEE VOLUME 2 PAGE 163 A.C.S.R. TIED OUT CORNER.

2017 - PLS 2994 FOUND A 1-1/2" OD IRON PIPE 2" ABOVE THE SURFACE AND 3 WITNESSES. THE MONUMENT AGREES WITH THE EXISTING WITNESSES.. ACCEPTED 1-1/2" OD IRON PIPE AS THE CORNER LOCATION. SET 4 NEW TIES AND RE-MEASURED TO EXISTING WITNESSES.

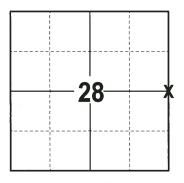


LOCATION (INDICATE CORNER BY "X")



DATA SHOWN HERE ON THIS TIE SHEET IS CORRECT AND COMPLETE TO THE BEST OF MY KNOWLEDGE AND BELIEF.

PROFESSIONAL LAND SURVEYOR

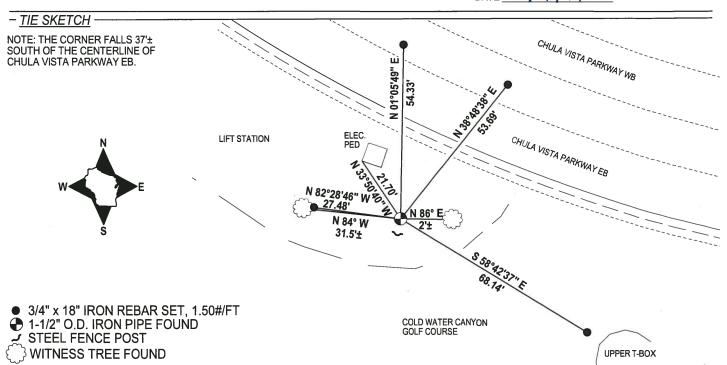

ADAMS COUNTY	CORNER NO	999
Survey Monument Record	SECTION	28
TYPE OF MONUMENT: 14 GAS PIPE	TOWN _	14 17
STATE PLANE COORDINATES: N	RANGE _	6 E
E		_
ELEVATION — M.S.L. DATUM:		
THETA ANGLE: FIELD BOOK: 525 PAGE 12		
PIELD BOOK: PAGE		* N
PAGE FOR MONUMENT LOCATION		
BASIS FOR MONUMENT LOCATION		
(Use reverse side if necessary) Show info such as: History of corner, with reference to Vol.	LOCATION	 !
and pg, dates, surveyor; exact description of monument replaced; if location computed, by taped or EDM traverse; landowner remarks, etc.	(Indicated by X') SCONS// FREDERIC W. ZIETLOW S-922 Baraboo WIS.	
RESEARCHED ADAMS COUNTY SURVEY RECORDS	MISCONSIN	144
AND FOUND THAT IN APRIL OF 1895 CO. SURVEYOR	FREDERIC	
A.J. BARRETT SET A GAS PIPE AT THIS CORNER.	ZIETLOW	
WE RECOVERED THIS MONUMENT. WE COULD NOT	5-922	*=
REMOVE IT TO PLACE A HARRISON AS IT IS WELL	Baraboo	10-3
GROWN INTO THE ROOT SYSTEM OF A 12" BURR OAK.	WIS.	0,2
THERE ALSO 3 TAPERED STONES AROUND THIS	WIS.	III.
PIPE, WHICH EVIDENTLY WE'RE PLACED BY BARRETT.		
See 141	CORRECT:	1
CURNER O.K 12-16-81 SK-DN Fred	in W. Zu	eton
-	and Surveyor VSUST 16,19	<u>ーーーーーー</u>
u u 3-25-91 GR-JG DATE:	108037 78772	76
TIE SKETCH CORNER OK 4-24-96 JG-55		
(Show at least four ties) (Show at least four ties)	20-01 JC	
(Show at least four ties) 1-NEW 11-27-06 - J6-55 OK 7-5-	11 <i>5</i> 5	
LUE OSE	コブ生	. 4
\ \ \ \ \ \ \ \ \ \ \ \ \ \ \ \ \ \ \	BACK OF	OB NI
P.K. NAIL & SHINER 20" DOUBLE BURROAK	BACK OUR SOUTH	IN
	L & SHINER	•
	L' DOUBLE R OAK	
FENCE X X X FE		
FENCE X X X X X	NEE - 1	
FENCE PK. NAIL & SHINER	11	
GONE 12" BLACK OAK		

METAL POSTV

PK. NAIL & SHINER 5" BOX ELDER GONE