27 SECTION

OB ADAMS COUNTY

COUNTY CORNER NO: 98

ROMPORTOL ID: 41406272000

PUBLIC LAND SURVEY MONUMENT RECORD

TYPE OF MONUMENT: **HARRISON** ADAMS COUNTY COORDINATES, NAD 83 (2007) N. **108330.465**

E. 546947.805


ELEVATION-DATUM --

06/28/2017 FIELD WORK DATE:


BASIS FOR MONUMENT LOCATION

1975 - PLS 922 FOUND PK NAIL AT APPROXIMATE CENTERLINE INTERSECTION, EXCAVATED BY HAND AND FOUND A 1-1/4"X30" IRON PIPE 12" UNDER THE PK NAIL. PLACED HARRISON AT LOCATION OF PK NAIL AND IRON PIPE AND TIED OUT CORNER.

2017 - PLS 2994 FOUND HARRISON MONUMENT 8" BELOW THE ROAD SURFACE, 2 TIES AND 1 WITNESS. THE MONUMENT AGREES WITH THE EXISTING TIES AND WITNESS. ACCEPTED HARRISON AS THE CORNER LOCATION. SET 2 NEW TIES AND RE-MEASURED TO THE EXISTING TIES AND WITNESS.

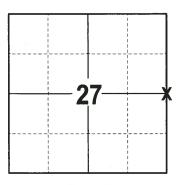


LOCATION (INDICATE CORNER BY "X")

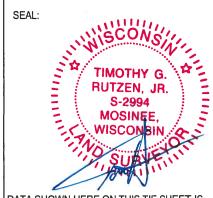

DATA SHOWN HERE ON THIS TIE SHEET IS CORRECT AND COMPLETE TO THE BEST OF MY KNOWLEDGE AND BELIEF.

PROFESSIONAL LAND SURVEYOR

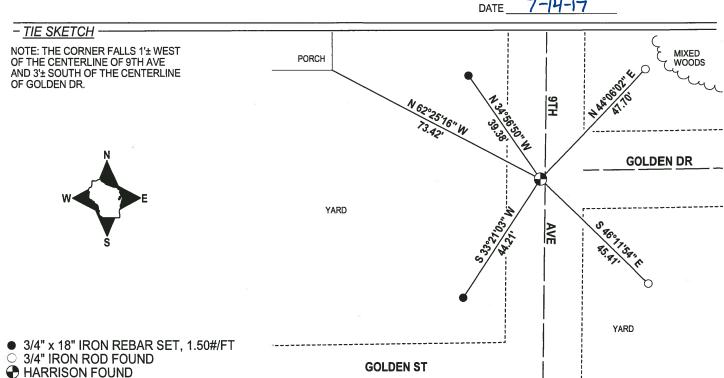

ADAMS COUNTY	CORNER NO	174
	SECTION _	26
Survey Monument Record	TOWN _	14 N
TYPE OF MONUMENT: 30" HARRISON MON	RANGE	6 E
STATE PLANE COORDINATES: N		
ELEVATION — M.S.L. DATUM:] _
THETA ANGLE:		
FIELD BOOK: PAGE3		
BASIS FOR MONUMENT LOCATION	=	-
		Ī
(Use reverse side if necessary) Show info such as: History of corner, with reference to Vol.	LOCATION	-
and pg, dates, surveyor; exact description of monument replaced; if location computed, by taped or EDM traverse; landowner	(Indicated by 'X') SEAL:	
remarks, etc.		
	/	
		•
FOUND PK AT APPROXIMATE E-E INTER	•	
INTERSECTION BY HAND AND FOUND 1/4"+30		•
DOWN 12", PLACED HARRISON OVER LOCATI IRON PIPE, USED AS GOV'T TIE IN MID-S)		ס
NOS 22-60-30 6 33-250-216	7/2 34/20/3 / /22	•
.,\\\\\\\\\\\\\\\\\\\\\\\\\\\\\\\\\\\\\		
Copyed D.K 10-16-81 SK 2018/1/11		
CORNER O.K. 10-9-76 GR. ST. SCONSINIA CORNER O.K. 10-16-81 SK DINGERIC		
10-22-90 SETC ZIETLOW	, de de	
1-GONE COROK 12/6/95 = * 5-922	CERTIFIED CORRECT:	
1. GONE OTIES LEFT 3-20-01 JG-SS Baraboo	Judia W. Liebon	
OK 11-10-06 JG-SS WIS. WIS.	Registered Land Surveyor DATE: ユリルミ 13 197	15
OK 1-17-11 MS, 55 1110 SURVENIL	DATE:	
TIE SKETCH		
(Show at least four ties) Corner of		•
New Porch		
& High	PLATTED	4
High 23 High		٦.
73.78'		N
NO SET SPINE IN TOP	FD. 3/4" REROD	
CONE 95 63		
HE CORNER OF 30		
Telephone Riser 34.62' &	GOLDEN CT	
8/2		
3,70	FD. 3/4" RE-ROD	<u></u>
E GOLDEN CT.	CPENNY 3FIXO XXX BALLO	
	Mail + Shiver + P.P.	
	NEW PLATTED	
l I i		