ADAMS COUNTY COUNTY CORNER NO: 99

ROMPORTOL ID: 41406262000

PUBLIC LAND SURVEY MONUMENT RECORD

HARRISON TYPE OF MONUMENT:_ ADAMS COUNTY COORDINATES, NAD 83 (2007) N. 108529.337 E. 552212.789 ELEVATION- - - DATUM

01/07/2021

BASIS FOR MONUMENT LOCATION

FIELD WORK DATE:

1975 - PLS 922 FOUND (2) SPIKES, (1) 60 PENNY & (1) 16 PENNY ADJACENT TO EACH OTHER 33.22' SOUTH OF A FOUND 1" IRON PIPE MARKING LOT 16, USED AS GOV'T CORNER IN MID-STATE SURVEY, FILE NO. 22-60-30, PLACED HARRISON OVER NAIL LOCATION.

2021 - PLS 2675 FOUND HARRISON 6"± BELOW THE ROAD SURFACE AND 1 TIE. THE MONUMENT AGREES WITH THE EXISTING TIE. ACCEPTED THE HARRISON AS THE CORNER LOCATION. SET 2 NEW TIES, MEASURED TO A FOUND PROPERTY IRON, AND THE EXISTING TIE.



(INDICATE CORNER BY "X")



DATA SHOWN HERE ON THIS TIE SHEET IS CORRECT AND COMPLETE TO THE BEST OF MY KNOWLEDGE AND BELIEF.

PROFESSIONAL LAND SURVEYOR


-TIE SKETCH

NOTE: THE CORNER LANDS 7'± SOUTH OF GOLDEN DR. CENTERLINE.



- 43"E N0° 31' DR. **GOLDEN** 51' 31"W 33.05 **S1**°
- SET 3/4" x 18" IRON REBAR, 1.50#/FT
- FOUND 3/4" IRON ROD
- FOUND HARRISON MONUMENT
- STEEL FENCE POST
- VINYL "T" POST

ADAMS COUNTY		CORNER NO	7 70
Survey Monument Record		SECTION	26
TYPE OF MONUMENT: 30" HARRISON MON		TOWN	14 N
STATE PLANE COORDINATES: N		RANGE	68
F	 	<u></u>	1
ELEVATION M.S.L. DATUM:	!		4
THETA ANGLE:	!		-
FIELD BOOK: 50/ PAGE 3		+++->	k NI
BASIS FOR MONUMENT LOCATION	 i		
(Use reverse side if necessary)	<u> </u>	<u> </u>	
Show info such as: History of corner, with reference to Vol. and pg, dates, surveyor; exact description of monument replaced; if location computed, by taped or EDM traverse; landowner remarks, etc.	SEAL:	LOCATION Indicated by 'X')	
LOT 16, USED AS GOV'T CORNER IN MID-S FILE NO. 22-60-30, PLACED HARRISON OVER COPNER OK 12-16-81 SK-DW " Z-13-86 GR-SS " SCONSIN" " 16-20-91 JG " FREDERIC" " 10-12-01 SS " S-922 Baraboo OK GPR 3/10/201" DSURVE	CERTIFIED Augusta Registered La	CORRECT:	
TIE SKETCH			
(Show at least four ties)			
Course as seems loss sees)			
			٦.
18"BLACK OAK 7	12	Y" BLACK OA	K N
9'STUMP FD. I"I.P.		Z'STUMP STILL GOOD	- 17
871L1 G000 E NO			
STILL 6000		C.T.	
& GOLDEN		<t.< td=""><td></td></t.<>	

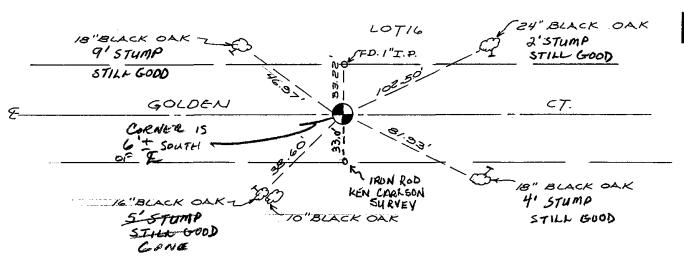

.. 🦫