

25
SECTION

14
TOWN

06
RANGE

ADAMS COUNTY

COUNTY CORNER NO: 112

ROMPORTOL ID: 41406250020

PUBLIC LAND SURVEY MONUMENT RECORD

TYPE OF MONUMENT: HARRISON

ADAMS COUNTY COORDINATES, NAD 83 (2007)

N. 106056.717

E. 554847.752


ELEVATION- - - - DATUM - - - -

FIELD WORK DATE: 01/07/2021

BASIS FOR MONUMENT LOCATION

1975 - PLS 922 FOUND 1-1/4"X48" IRON PIPE AT FENCE CORNER. FIT EDM TRAVERSE OF SECTION GOOD. MONUMENTED SAME.


2021 - PLS 2675 FOUND HARRISON FLUSH WITH THE GROUND, 1 TIE, AND 1 WITNESS. THE MONUMENT AGREES WITH THE TIE AND WITNESS. ACCEPTED THE HARRISON AS THE CORNER LOCATION. SET 3 NEW TIES AND MEASURED TO THE EXISTING TIE AND WITNESS.

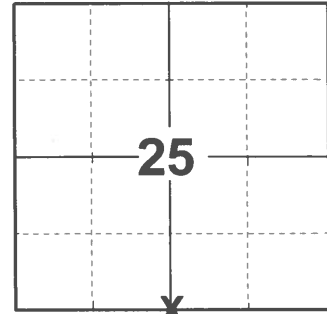

LOCATION

(INDICATE CORNER BY "X")

SEAL:

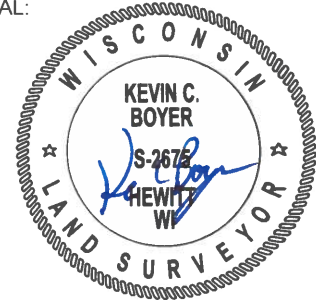

DATA SHOWN HERE ON THIS TIE SHEET IS CORRECT AND COMPLETE TO THE BEST OF MY KNOWLEDGE AND BELIEF.



PROFESSIONAL LAND SURVEYOR

DATE 3/3/2021

TIE SKETCH

NOTE: TRAIL FROM NORTH ENDS 100± NORTH OF THE CORNER.

NOTE: THE 1-1/4" O.D. IRON PIPE TO THE NORTH OF THE CORNER IS UP 2±

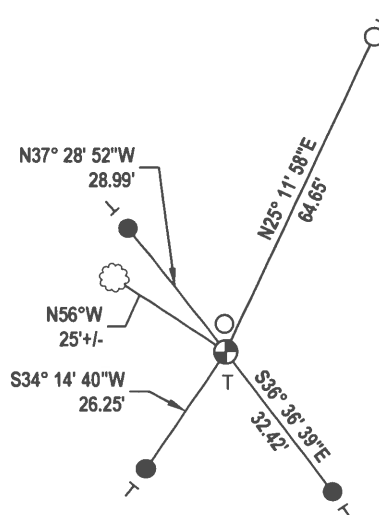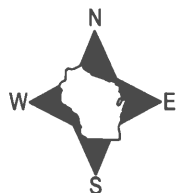


- SET 3/4" x 18" IRON REBAR, 1.50#/FT
- FOUND 1-1/4" O.D. IRON PIPE
- ⊕ FOUND HARRISON MONUMENT
- VINYL "T" POST
- ☁ WITNESS TREE

ADAMS COUNTY

Survey Monument Record

TYPE OF MONUMENT: 30" HARRISON
 STATE PLANE COORDINATES: N _____
 E _____
 ELEVATION — M.S.L. DATUM: _____
 THETA ANGLE: _____
 FIELD BOOK: _____ PAGE _____

CORNER NO. 888
 SECTION 25
 TOWN 14 N
 RANGE 6 E

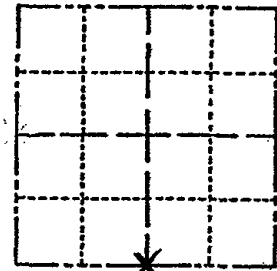

LOCATION
(Indicated by 'X')

SEAL:



CERTIFIED CORRECT:

Frederic W. Zietlow

Registered Land Surveyor

DATE: NOVEMBER 20, 1915

BASIS FOR MONUMENT LOCATION

(Use reverse side if necessary)

Show info such as: History of corner, with reference to Vol. and pg, dates, surveyor; exact description of monument replaced; if location computed, by taped or EDM traverse; landowner remarks, etc.

FOUND 1 1/4" X 48" IRON PIPE AT FENCE CORNER. FIT E.D.M. TRAVERSE OF SECTION GOOD. MONUMENTED SAME.

CORNER O.K. 10-9-76 GR-SS

CORNER O.K. 12-16-81 SK-DW

" " 2-13-86 GR-SS

1-NEW, 1-GONE, CORNER OK 8-5-91-JG

ALL OK 10/30/96 JG-SS

" " 3-7-02-JG

ALL OK 11-28-06-JG-SS

OK 12-20-11 ms

THE SKETCH

(Show at least four ties)

