25 SECTION

TYPE OF MONUMENT:

D6 ADAMS COUNTY

COUNTY CORNER NO: 113

ROMPORTOL ID: 41406250000

PUBLIC LAND SURVEY MONUMENT RECORD


ADAMS COUNTY COORDINATES, NAD 83 (2007) N. 106159.309 E. 557497.839 DATUM 10/04/2017 FIELD WORK DATE:

BASIS FOR MONUMENT LOCATION

1975 - PLS 922 RE-ESTABLISHED THE CORNER BY THE SINGLE PROPORTIONATE METHOD BETWEEN THE NE CORNER OF SECTION 25, 14-6 AND THE SE CORNER OF SECTION 36, 14-6 VIA E.D.M TRAVERSE. DAVE CLARK DID A SURVEY NOVEMBER 16, 1972 IN THIS AREA, BUT IT WAS IMPOSSIBLE TO RETRACE TO THE CORNER LOCATION. IN 1921 M.C. SMITH COUNTY SURVEYOR NOTED THAT THERE WERE NO SIGNS OF BEARING TREES OR POST. SET A 30" HARRISON AT THE CORNER LOCATION AND TIED OUT.

HARRISON (BROKEN-TOP)

2017 - PLS 2994 FOUND A HARRISON MONUMENT WITH A BROKEN-TOP 6" BELOW THE SURFACE, 1 WITNESS TREE AND PROPERTY IRON. THE MONUMENT AGREES WITH THE EXISTING WITNESS TREE. ACCEPTED THE HARRISON MONUMENT WITH A BROKEN-TOP AS THE CORNER LOCATION. SET 3 NEW TIES AND RE-MEASURED TO THE TIES, WITNESS TREE AND PROPERTY IRON.

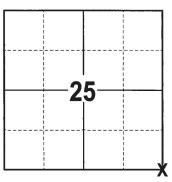

LOCATION (INDICATE CORNER BY "X")

SEAL: TIMOTHY G. RUTZEN, JR. S-2994 MOSINEE

DATA SHOWN HERE ON THIS TIE SHEET IS CORRECT AND COMPLETE TO THE BEST OF MY KNOWLEDGE AND BELIEF.

PROFESSIONAL LAND SURVEYOR

11-15-17 DATE


- TIE SKETCH

NOTE: THE CORNER FALLS 750'± WEST OF THE CENTERLINE OF CTH B.



3/4" x 18" IRON REBAR SET, 1,50#/FT 3/4" IRON ROD FOUND HARRISON (BROKEN-TOP) FOUND ✓ STEEL FENCE POST

VINYL "T" POST WITNESS TREE FOUND

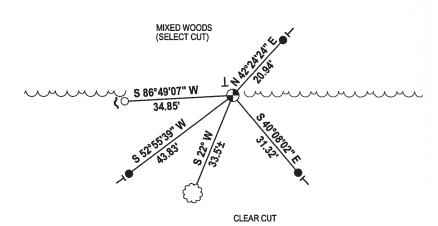

ADAMS COUNTY	corner no. 88
Survey Monument Record	SECTION 25
TYPE OF MONUMENT: 30" HARRISON	TOWN 14N
STATE PLANE COORDINATES: N	RANGE 6E
E	
ELEVATION — M.S.L. DATUM: THETA ANGLE:	
FIELD BOOK: PAGE	
BASIS FOR MONUMENT LOCATION	
(Use reverse side if necessary)	<u> </u>
Show info such as: History of corner, with reference to Vol. and pg, dates, surveyor; exact description of monument replaced; if location computed, by taped or EDM traverse; landowner remarks, etc.	LOCATION (Indicated by 'X') EAL:
THIS CORNER WAS RE-ESTABLISHED BY THE SINGLE PROPORTIONATE METHOD	
BETWEEN KNOWN CORNERS, BEING THE NE COR. OF SEC. 25, 14-6 AND THE SE COR.	FREDERIC W. ZIETLOW S-922 Baraboo WIS.
OF SEC. 36, 14-6 VIA E.D.M. TRAVERSE.	FREDERIC W.
DAUE CLARK DID A SURVEY NOV. 16, 1972 IN THIS VICINITY, BUT IT WAS IMPOSSIBLE	ZIETLOW
TO RETRACE TO LOCATE COR. IN 1921	5 -922
M.C. SMITH COUNTY SURVEYOR NOTED THAT THERE WERE NO SIGNS OF B.T.'S OR POST.	Baraboo Wis.
CORNER OK. 10-2976 GR-DCH CORNER OK. 10-16-81 SK-DW 11 2-12-86 GE-55	SURVE IIII
1 NEW TIE 7-24-91 JG-55	Popul W. Colou
OK 4-25-96 JG-SS	legistered Land Surveyor
OK 3-7-02-JG, OK 1-23-06-JG OK 12-20-11 MS D	DATE: NOVEMBER 20,197
TIE SKETCH NEW NAILRE SHINER PLANEATION	
(Show at least four ties) TRIPLE S. ASH DND 516N (CHERY) ZOO'J ZOON FENCE ASH DOWN FENCE	CND OF TRAIL FROM CAST
T34"X24"	,
27.94'	·
6/4	
	6 NEW NAIL
16.15'	B PK-FEHWER
18.78	DOUBLE 12"ASH/
62.50	, , , , , , , , , , , , , , , , , , ,
62.50 A JOINTED SHAET	(CHERRY)
SON OF CORNER	DND SIGN FACES ENST
SON OF CORNER	DND SIGN FACES ENST
SON OF CORNER	DND SIGN FACES ENST
CPK. & SMINER 5" LOCUST SO. OF CORNER EN JACK PINES DND SIGN OF	DND SIGN FACES ENST