35 SECTION

OB ADAMS COUNTY

COUNTY CORNER NO: 119

ROMPORTOL ID: 41406352000

PUBLIC LAND SURVEY MONUMENT RECORD

HARRISON TYPE OF MONUMENT: ADAMS COUNTY COORDINATES, NAD 83 (2007) N. **103291.021**

E. 552125.988


ELEVATION- - -DATUM

FIELD WORK DATE: 06/28/2017


BASIS FOR MONUMENT LOCATION

1974 - PLS 878 FOUND AND ACCEPTED IRON ROD AS CORNER. IRON ROD SET BY MID-STATES IN SURVEY OF TOWN ROAD AND DUMP. SET HARRISON MONUMENT AT CORNER LOCATION AND TIED OUT.

2017 - PLS 2994 FOUND HARRISON MONUMENT 3" BELOW THE ROAD SURFACE, 1 TIE AND 2 WITNESSES. THE MONUMENT AGREES WITH THE EXISTING TIE AND WITNESSES. ACCEPTED HARRISON AS THE CORNER LOCATION, SET 2 NEW TIES AND RE-MEASURED TO THE EXISTING TIES AND WITNESSES.

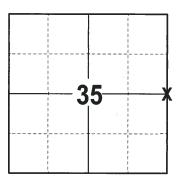

LOCATION (INDICATE CORNER BY "X")

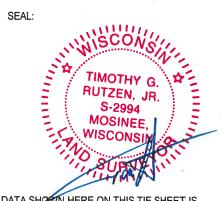

DATA SHOWN HERE ON THIS TIE SHEET IS CORRECT AND COMPLETE TO THE BEST OF MY KNOWLEDGE AND BELIEF.

PROFESSIONAL LAND SURVEYOR


DATE

- TIE SKETCH

NOTE: THE CORNER FALLS 3'± WEST OF THE CENTERLINE OF 8TH AVE.



- 3/4" x 18" IRON REBAR SET, 1.50#/FT
- 3/4" IRON ROD FOUND
- ⊕ 1-1/4" O.D. IRON PIPE FOUND
- 1" OD IRON PIPE FOUND
- HARRISON FOUND
- ✓ STEEL FENCE POST
- → VINYL "T" POST
 - FOUND WITNESS TREE

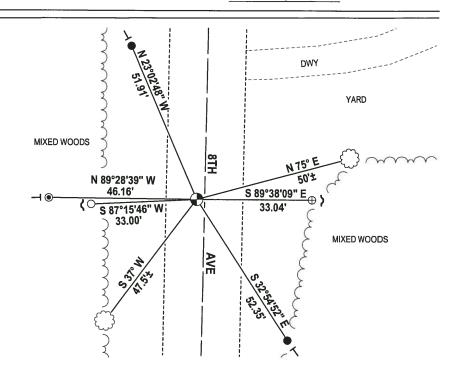

368 CORNER NO. _ ADAMS COUNTY 35 **SECTION** Survey Monument Record TOWN TYPE OF MONUMENT: 30" HARRISON **RANGE** STATE PLANE COORDINATES: N_ ELEVATION - M.S.L. DATUM: __ THETA ANGLE: ____ _____ PAGE ___ BASIS FOR MONUMENT LOCATION (Use reverse side if necessary) LOCATION Show info such as: History of corner, with reference to Vol. and pg, dates, surveyor; exact description of monument replaced; if location computed, by taped or EDM traverse; landowner (Indicated by 'X') SEAL: remarks, etc. Found and accepted iron rod as corner. Inon red set by Mid-States in survey of town road and dump. CORNER O.K. 10-9-76 GR.S.S. CORNER O.K 12-15-81 5K-BW 11 2-12-86 62-55 ALL OK 10-22-96 55-5C COR. OK 12/6/95 JG-55 NEW TIES 7-11-00 SH-EC ALL OK 3-20-01,56 GERTIFIED CORRECT: 1-LONE 1-NEW, 11-10-06, JG-53 1-607e, 1-New 1-17-11 MS, 55 DATE: TIE SKETCH (Show at least four ties) 60,20' 9 18'Oak /87 I" IRON PIPE White

ADAMS COUNTY		368
Survey Monument Record	02011011 232	35
TYPE OF MONUMENT: 30" HARRISON		14
STATE PLANE COORDINATES: N	RANGE	6
ELEVATION — M.S.L. DATUM: THETA ANGLE: FIELD BOOK: PAGE		
		· 1
BASIS FOR MONUMENT LOCATION		
(Use reverse side if necessary)		
Show info such as: History of corner, with reference to Vol. and pg, dates, surveyor; exact description of monument replaced; if location computed, by taped or EDM traverse; landowner remarks, etc.	LOCATION (Indicated by 'X') SEAL:	
Found and accepted iron rod as corner. Iron rod set by Mid-States in survey of town road and dump.	ANTHONY B. KIEDROWSKI S-878 Wisconsin Rapids.	
·	ANTHONY B.	
CORNER O.K. 10-9-76 GR.S-S CORNER O.K 12-15-81 SK-BW	KIEDROWSKI S-878	
1 2 - 17 - 86 (al 55)	Wisconsin Rapids.	
NEW TIE 7-11 00 SHEC	Wis.	3
NEWTIE	The state of the s	7
	MINISUR VALUE	
•		
111 120 80 W	Registered Land Surveyor DATE:	ms le
Mor 20'89 Kin Cirlson		
TIE SKETCH		
(Show at least four ties)	~	
		, .
	ties are to naily	disc
	ie:nak /	
S I JOHN PIPE	80.20' 9'0041/07	
46.32'	80.2	
White Pine	:	
	3 71.45	
	is one	11/00
NO.	254 Philipper	, ,
	7 7 7 7 7 7 7 7 7 7 7 7 7 7 7 7 7 7 7 7	.1
\mathcal{U}	A Gail is 4' off grow	ino)
Twin & cherry	TACKPINE	
1 100 17 1 1 1 1 1 1 1 1 1 1 1 1 1 1 1 1		
REVISED 1972	CNAIL 45 ABOVE	