33 SECTION 14 TOWN 06

ADAMS COUNTY

COUNTY CORNER NO. 126B

ROMPORTOL ID: 41406330020B

PUBLIC LAND SURVEY MONUMENT RECORD

TYPE OF MONUMENT: 3/4" IRON ROD (MEANDER CORNER)
ADAMS COUNTY COORDINATES, NAD 83 (2007)

N. 100099.022

E. 540096.220

ELEVATION- - DATUM - - -


FIELD WORK DATE: 2/28/2017

BASIS FOR MONUMENT LOCATION


1979- PLS 1478 FOUND A 3/4" IRON REBAR DURING A RANDOM TRAVERSE OF THE SOUTH LINE OF SECTION 33, THE DISTANCE FROM THIS REBAR TO THE SE CORNER OF SECTION 33. VERY NEARLY MATCHES A DISTANCE SHOWN ON A 1932 MAP OF THE CITY OF WISCONSIN DELLS IN COLUMBIA COUNTY. A MONUMENT IS SHOWN ON THIS MAP, BUT NO INDICATION OF WHAT WAS SET WAS GIVEN. A 4" DIAMETER WOOD STAKE BLAZED ON WEST SIDE WAS FOUND 0.80' NE OF THE REBAR AND A VERY ROTTEN 2" SQUARE WOOD STAKE WAS FOUND IMMEDIATELY TO THE EAST OF THE BAR.

2006- FOUND A 3/4" REBAR IN GOOD CONDITION AND SET 3 TIES

2017 - PLS 2994 FOUND A 3/4" REBAR FLUSH WITH THE SURFACE, AND 3 EXISTING TIES. THE REBAR AGREES WITH THE TIES. ACCEPTED THE 3/4" REBAR, REMEASURED TO THE 3 EXISTING TIES AND SET 1 NEW TIE.

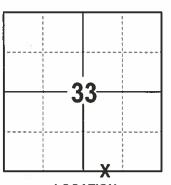

LOCATION (INDICATE CORNER BY "X")

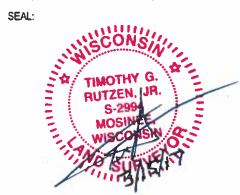

DATA SHOWN HERE ON THIS TIE SHEET IS CORRECT AND COMPLETE TO THE BEST OF MY KNOWLEDGE AND BELIEF.

PROFESSIONAL LAND SURVEYOR


DATE 3/15/17

- TIE SKETCH

NOTE: THE CORNER FALLS 40'± EAST OF THE EAST BANK OF THE WISCONSIN RIVER.



MIXED WOODS

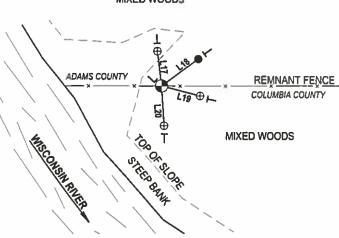

● 3/4" x 18" IRON REBAR SET, 1.50#/FT ⊕ 3/4" IRON ROD W/ALUMINUM CAP FOUND

→ 3/4" IRON ROD FOUND
→ VINYL "T" POST

→ FIBERGLASS "T" POST

LINE BEARING DISTANCE
L17 N 06°51'44" W 18.20'
L18 N 53°58'56" E 23.75'
L19 S 75°32'22" E 20.80'
L20 S 03°24'35" E 20.73'

Government Land Corner Certificate	
Anger Combi	CORNER NO. /26
TYPE OF MONUMENT: 3/4" LEBAR - FOUND	SECTION 33
STATE PLANE COORDINATES: N	TOWN
E	RANC#
ELEVATION — M.S.L. DATUM:	
THETA ANGLE:	, JAWA
PAGEPAGE DRAWN BY: G. RHINEHART	BUNGARD THE
DRAWN BY: C. KHINEFAMET	NI NI
PLOYO TOP 1 CONTROL TO 1	IN
BASIS FOR MONUMENT LOCATION	
Show info such as: History of corner, with reference to Vol. and pg., dates, surveyor; exact description of monument	
replaced; if location computed, by taped or EDM traverse; landowner remarks, etc. (Use reverse side if necessary)	LOCATION (Indicated by 'X')
	SEAL:
Found 3/4 Rebar during random traverse of south	GREGORY P. RHINEHART S-1478 Wisconsin Rapids Wis.
line of Section 33. The distance from this rebar to	SHIM SCONS IN THE
the SE corner of Section 33 very nearly matches a distance shown on a 1932 map*of the city of	
Wisconsin Dells in Columbia County. A monument is	GREGORY P. RHINEHART
shown on this map, but no indication of what it is	S-1478 Wisconsin Rapids
was given.	Wis.
A 4" diameter wood stake, blazed on the west side was found 0.8° to the NE of the rebar and a very	The state of the s
rotten 2" square wood stake was found immediately	NO SURVE
to the east of the bar.	
	DATA SHOWN HERE ON CERTIFIED CORRECT:
* this map was prepared by H.C. Amundsen and viewed	CANTAL COMMENT
at Mid-state Associate offices in Baraboo, Wisconsin.	Registered Land Surveyor
CORNER O.K 12-14-81 SK-DW	DATE: 12/12/79
3. NEW TIES 11-7-16-55	
TIE SKETCH ROOS OK 4-7-11 55	SARVEY MARKER POST 1 EGST OF CORNER
Show at least four ties, also fence lines, roads, topo, size and type of witness trees' and if off road - best way to	
	DAMS COUNTY
PLACED SURVEY MARKER SIGN ON S' NORWAY 21 + SWITH OF CAR	
SIEN ON 5' NORWAY ZI' SOUTH OF REBAR C	12"BLK OAK N DE AD TO
OZ	SIGN POT S" BUK OAK
Z'E SOUTH OF REZAR	(8) x, 34" OAP/PERA
, Z	1334 62
	30'± 1465.11 TO
4" 1 2	X X X X X X
NORWAY / A	3/4"CAP REBAR
DND SICH &	(3) 3) CAP (2) 6" BLK OAK
·: / / / / / / / / / / / / / / / / / / /	PERO/BT
OF CURNET	ou for V
· (, , , , ,	CITY OF WISC. DELLS
\ \frac{\sqrt{\sq}\sqrt{\sq}}\sqrt{\sq}}}}}}}}}}}}}}}}}}}}}}}}}}}}}}}}}}}}	
	COLUMBIA COUNTY

MAINTENANCE RECORD

DATE	BY WHOM	REMARKS
4-1-86	SS	O.K.
10-27-90	55-IG	ok
2-26-96	55	O.K.
3-07-01	JG-MH	ok
·		
		•
		<u> </u>
		·