OF ADAMS COUNTY

COUNTY CORNER NO: 128

ROMPORTOL ID: 41406340020

PUBLIC LAND SURVEY MONUMENT RECORD

TYPE OF MONUMENT: HARRISON
ADAMS COUNTY COORDINATES, NAD 83 (2007)

N. 100281.659

E. 544185.203

ELEVATION-DATUM_


2/28/2017 FIELD WORK DATE:

BASIS FOR MONUMENT LOCATION

1974- PLS 878 REPLACED AN EXISTING 1/2" X 1 3/4"X 40" STRAP IRON WITH HARRISON. STRAP IRON SET BY COLUMBIA COUNTY SURVEYOR C.E. CORNING IN 1920. SEE COLUMBIA COUNTY SURVEY RECORDS BLUE PRINT NO. 162, FIT TRANSIT-TAPE TRAVERSE OF SECTION GOOD.

1998- PLS 1321 FOUND A HARRISON, AND SET 4 TIES.

2017 - PLS 2994 FOUND A HARRISON 3" ABOVE THE SURFACE, AND 4 EXISTING TIES. THE HARRISON AGREES WITH TIES. ACCEPTED HARRISON AND REMEASURED TO THE 4 EXISTING TIES.

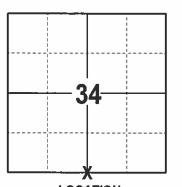


LOCATION (INDICATE CORNER BY "X")

SEAL: RUTZEN.

DATA SHOWN HERE ON THIS TIE SHEET IS CORRECT AND COMPLETE TO THE BEST OF MY KNOWLEDGE AND BELIEF.

PROFESSIONAL LAND SURVEYOR

- TIE SKETCH

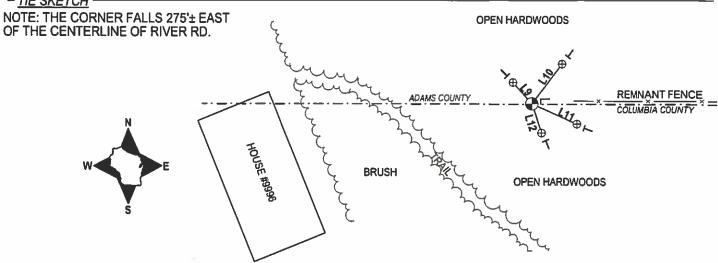

⊕ 3/4" IRON ROD W/ALUMINUM CAP FOUND HARRISON FOUND → VINYL "T" POST

→ FIBERGLASS "T" POST

LINE	BEARING	DISTANCE
L9	N 41°37'57" W	14.84'
L10	N 37°24'31" E	26.001
L11	S 66°00'07" E	25.77'
L12	S 18°14'20" E	15.98'

128 CORNER NO. ADAMS COUNTY SECTION Survey Monument Record TOWN TYPE OF MONUMENT: 30" HARRISON MON. RANGE STATE PLANE COORDINATES: N_ ELEVATION — M.S.L. DATUM: _ THETA ANGLE: .. _ PAGE . FIELD BOOK: _ BASIS FOR MONUMENT LOCATION (Use reverse side if necessary) LOCATION Show info such as: History of corner, with reference to Vol. and pg, dates, surveyor; exact description of monument replaced; if location computed, by taped or EDM traverse; landowner (Indicated by 'X') SEAL: FOUND 40" OF 1/2" X 134" STRAP IRON SET BY COLUMBIA COUNTY SURVEYOR C.E. CORNING IN 1920. SEE COLUMBIA COUNTY SURVEY RECORDS BLUE PRINT # 162 W. ZIETLOW FIT TRAUSIT - TAPE TRAVERSE OF SECTION S-922 Baraboo GooD. SK- DW CORNER O.K 12-14-81 2-13-86 GR-55 OK CERTIFIED CORRECT ALLOK 10-22-90 JG-55 · W Registered Land Surveyor OK 3-30-95 MC MARCH 18 ALL OK 10/30/96 56-55 OK 3-14-02 - JG-55 USE COLUMBA CO. TIES ALSO 11-27-06, J6-55 4-7-11 LARGE OAK HAS FALLEN OVER HAR (Show at least four ties) COLUMBIA CO. TIES OK . NAIL & SHIVER COUNTY 6" DIA WHITE CEDAR FENCE WITH COUNTY SURVEYORS SIGN 7" BLACK CAR

U. S. PUBLIC LAND SURVEY MONUMENT RECORD

COLUMBIA COUNTY This record shall show the location of the corner and shall include all of the following nine elements (a through i). INSTRUCTIONS: (a) identify the corner by reference to the U.S. public land survey system. O = Corner monument restored. CORNER MONUMENT RESTORED WAS THE NI/4 CORNER OF SECTION 3 T. /3N., R. 6 E., TOWNSHIP OF DELLIPRAIRIE ,cor.co. TOWN OF <u>NEWPORT</u> CORNER HISTORY: ADAMS CO. ORIGIN: BY SURVEYOR(S) COLUMBIA CO. DATE: TOWNSHIP OF NEWPORT PERPETUATION: (PAGE, DATE&SURVEYOR) VOL. I SEE PREVIOUS TE SHEET VOL. II B.P.R. FIELD BOOK RECENT SURVEYS: (REF., DATE&SURVEYOR) ZIETLOW RLS DATED 3-18-77 BY FREDERIC W. Describe any record evidence, monument evidence, occupational evidence, testimonial evidence or any other material evidence you considered, and whether the monument was found or placed. EVIDENCE FOUND: , MONUMENT ×, OCCUPATIONAL , TESTIMONIAL , OTHER_ ORIGINAL CORNER MONUMENT LOCATION WAS ALAFOUND. ADAMS: COUNTY MONUMENT AND SET FOUR (4) DESCRIPTION: FOUND WITHESS MONUMENTS COLUMBIA COUNTY ALUMINUM WAS SET IN PLACE. (FOR ANY ADD'L INFO SEE BACK) (c) In the plan view drawing below, provide reference ties to at least 4 witness monuments, or, if the location is within a municipality, to at least 2 witness monuments. (Witness monuments shall be made of concrete, natural stone, Iron or other equally durable material.) Describe witness monuments. • - COLUMBIA COUNTY ALUM, MON. SET (d) Show a plan view drawing depicting the relevant monuments and reference ties which is sufficient in detail to enable accurate relocation of the corner monument if the corner monument is disturbed. O - 3/4"x30" REBAR W/ALUM. WITNESS CAP SET (OTHER) <u>HARRISON MON.FND</u> NO SCALE 21" OAK Indicate north. Ν 4"WHITE 400'± DOWN CEDAR POST HOUSE Œ VER NOTE: ALL BEARINGS SHOWN B" TWIN OAKS ARE REFERENCED TO MAGNETIC NORTH. œ 12" OAK

CORNER REF.

DATE

10/13/97

DRAFTED BY CAE

A.15

(e)	reestablish by distance above. She and (1) the	hed and the e and direct ow the distar e corner as i	location o ion. Show nces betwe restored o	y between the f that corner the discrepane en the corner reestablished (d), above.	as previously cy on the pla as previously	restored o n view draw restored o	r reestabli ing under (r reestabli	shed d), shed
FOU	ND:			· •				
ET	BY:					¥		· ·
ОВ	REF:					•		
BEA:					FROM	CORNER	MON. SI	ET.
JEA.								
	*			;				
(f)	Was the co	rner restored stuated local	d through	acceptance of	(1) an oblite	rațed evidei	nce locatio	n, or, (2) a
				•		•		*
ru is	CORNER	WAS REST	rored t	THROUGH		A/4		LOCATION.
(g&h	method, ii	ncluding the	direction	rough lost corns and distance ing in determin	s to other pul ning the corn	blic land si er location:	irvey corne	rs used as
					S REFEREI ES ARE:		GROUNI	
	14		,, ,		TOR:			-
		•						N
	4		٠					
	•			· · ·				
			•				•	Ų
					•			
		;					•	
	·.					·		
			•					
					•			
•					,		•	
·.			•					•
	,	•						
	•							
						pictui	re taken; 	_yes <u>x</u> no
						,	Affix Lan	d Surveyor Se
	.53						, st	WISCONS IN
-			· · · · · · · · · · · · · · · · · · ·			 	Zyrun.	JAMES R.
				•			<i>[</i>]	S-1321
	1			1		 		PORTAGE, WISCONSIN
(i)	type or pr	mes contract	R. 62	other corner lo	cation shows	i !	THE PARTY OF THE P	PORTAGE WISCONSIN SURVEYOR
	on this red	ord was dete I that this U	ermined by J.S. Public	me or under my c Land Survey N	/ direction ar Monument Reco	nd rd is	· •	WOOHAE THE
	correct and	complete to	the best	of my knowledg	ge and belief.	· ·		
	Signature	- ' (John		07.98 Date			