

02
SECTION

14
TOWN

07
RANGE

ADAMS COUNTY

COUNTY CORNER NO: 19

ROMPORTOL ID: 414007022000

PUBLIC LAND SURVEY MONUMENT RECORD


TYPE OF MONUMENT: HARRISON
ADAMS COUNTY COORDINATES, NAD 83 (2007)

N. 129905.269

E. 583632.009

ELEVATION- _____ DATUM _____

FIELD WORK DATE: 03/26/2020

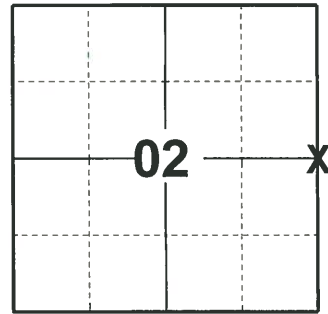

LOCATION


(INDICATE CORNER BY "X")

BASIS FOR MONUMENT LOCATION

1982 - PLS 1444 NO EVIDENCE OF ANY ORIGINAL CORNER OR ANY RESURVEY CORNERS WERE FOUND AT THIS LOCATION. ALSO, NO INDICATION OF ANY ORIGINAL BEARING TREES WERE FOUND. THEREFORE, CORNER WAS SET ON LINE AND SINGLE PROPORTIONATE MEASURE BETWEEN ADJACENT SECTION CORNERS.

2020 - PLS 2675 FOUND HARRISON MONUMENT 4'± BELOW THE GROUND AND 1 WITNESS TREE. THE MONUMENT AGREES WITH THE WITNESS TREE. ACCEPTED THE HARRISON MONUMENT AS THE CORNER LOCATION. SET 4 NEW TIES AND MEASURED TO THE EXISTING WITNESS TREE.

SEAL:

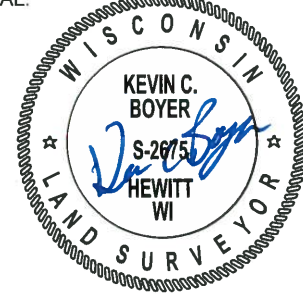



DATA SHOWN HERE ON THIS TIE SHEET IS CORRECT AND COMPLETE TO THE BEST OF MY KNOWLEDGE AND BELIEF.

PROFESSIONAL LAND SURVEYOR

DATE 5/21/2020

TIE SKETCH

NOTE: THE CORNER LANDS 61'± NORTH OF THE WOODS TRAIL

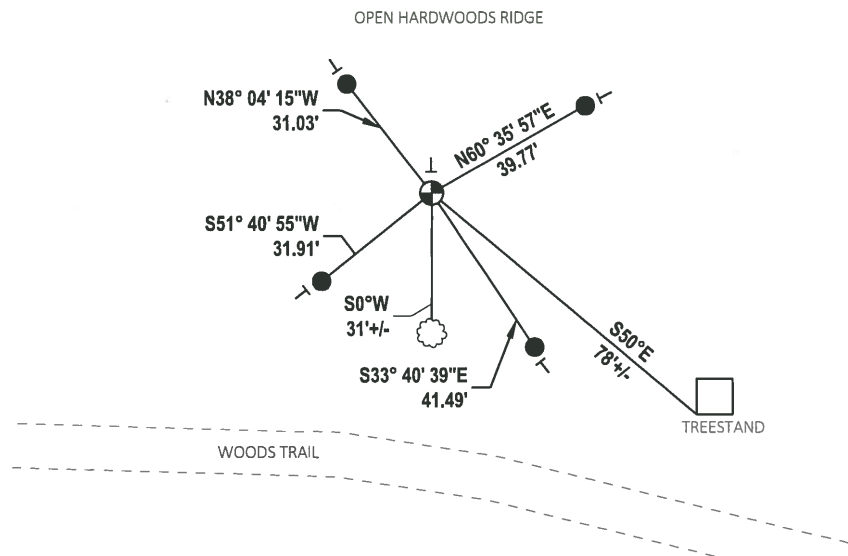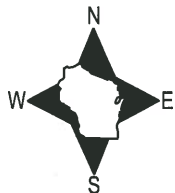


- SET 3/4" x 18" IRON REBAR, 1.50#/FT
- ⊕ FOUND HARRISON MONUMENT
- VINYL "T" POST
- ☉ WITNESS TREE

Government Land Corner Certificate

AOAMS County
 TYPE OF MONUMENT: HARRISON MONUMENT
 STATE PLANE COORDINATES: N _____
 E _____
 ELEVATION — M.S.L. DATUM: _____
 THETA ANGLE: _____
 FIELD BOOK: 92 PAGE 52
 DRAWN BY: SJH

CORNER NO. 19
 SECTION 1
 TOWN 14
 RANGE 7

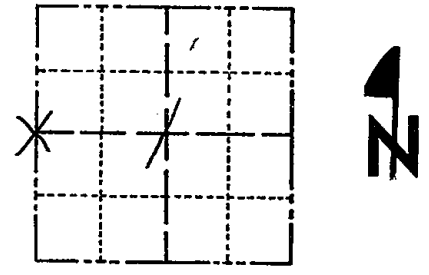


LOCATION
(Indicated by 'X')

BASIS FOR MONUMENT LOCATION

Show info such as: History of corner, with reference to Vol. and pg., dates, surveyor; exact description of monument replaced; if location computed, by taped or EDM traverse; landowner remarks, etc. (Use reverse side if necessary)

No evidence of any original corner or any resurvey corners were found at this location. Also, no indication of any original bearing trees were found. Therefore, corner was set on line and single proportionate measure between adjacent Section corners.

SEAL:

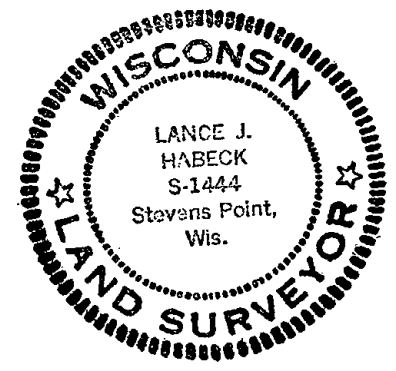

DATA SHOWN HERE ON
CERTIFIED CORRECT:

Lance J. Habeck
Registered Land Surveyor

DATE: 4/29/82

TIE SKETCH

Show at least four ties, also fence lines, roads, topo, size and type of witness trees and if off road - best way to arrive at corner.

CORNER IS 400'±
NORTH OF FENCE
NORTH SIDE 1"362

