

02
SECTION

14
TOWN

07
RANGE

ADAMS COUNTY

COUNTY CORNER NO: 30
ROMPORTOL ID: 41407020020

PUBLIC LAND SURVEY MONUMENT RECORD

TYPE OF MONUMENT: HARRISON
ADAMS COUNTY COORDINATES, NAD 83 (2007)

N. 127240.022

E. 580947.067


ELEVATION- - - DATUM - -

FIELD WORK DATE: 03/30/2020

BASIS FOR MONUMENT LOCATION

1974 - PLS 922 FOUND OLD 3-WAY FENCE CORNER THAT FIT E.D.M. TRAVERSE OF THIS SECTION GOOD IN ALL DIRECTIONS. ACCEPTED THIS AS BEST AVAILABLE EVIDENCE AND SET HARRISON.


2020 - PLS 2675 FOUND HARRISON MONUMENT 6"± BELOW THE GROUND AND 2 WITNESS TREES. THE MONUMENT AGREES WITH BOTH WITNESS TREES. ACCEPTED THE HARRISON MONUMENT AS THE CORNER LOCATION. SET 4 NEW TIES AND MEASURED TO THE EXISTING WITNESS TREES.

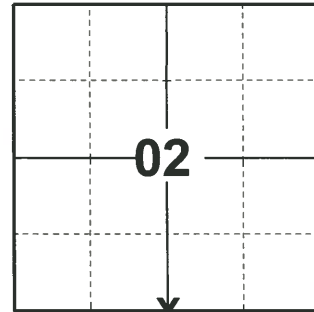

LOCATION

(INDICATE CORNER BY "X")

SEAL:

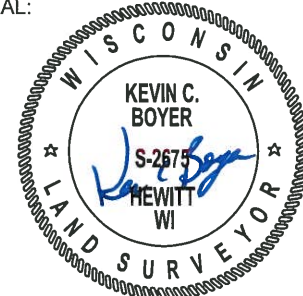


DATA SHOWN HERE ON THIS TIE SHEET IS CORRECT AND COMPLETE TO THE BEST OF MY KNOWLEDGE AND BELIEF.

PROFESSIONAL LAND SURVEYOR

DATE 5/21/2020

- TIE SKETCH

NOTE: A 2-3/8" O.D. IRON PIPE WITH FENCE POST IS 0.50' WEST OF HARRISON MONUMENT.

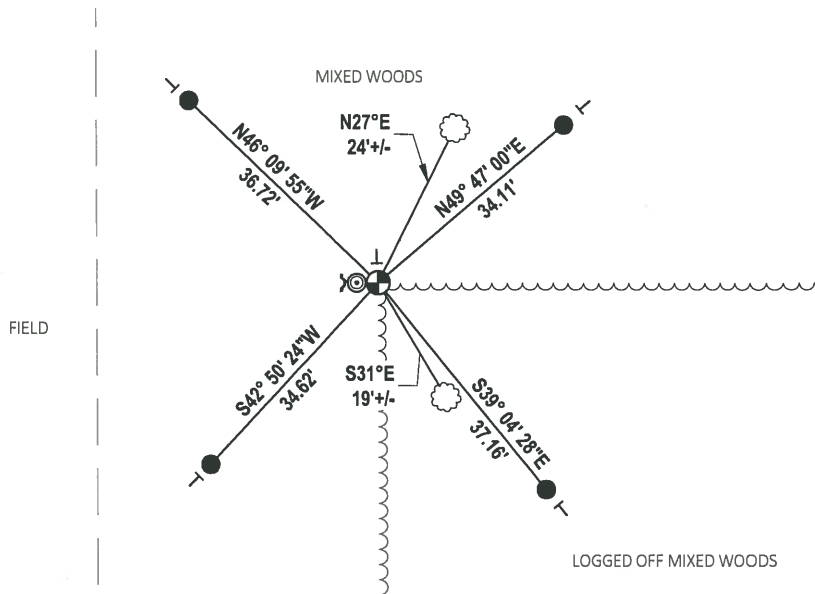

- SET 3/4" x 18" IRON REBAR, 1.50#/FT
- ⊙ FOUND 2-3/8" O.D. IRON PIPE
- ⊕ FOUND HARRISON MONUMENT
- ┌ STEEL FENCE POST
- └ VINYL "T" POST
- ⊗ WITNESS TREE

ADAMS COUNTY

Survey Monument Record

Harrison set 5-8-75

TYPE OF MONUMENT: 2" x 30" IRON PIPE

STATE PLANE COORDINATES: N _____

E _____

ELEVATION — M.S.L. DATUM: _____

THETA ANGLE: _____


FIELD BOOK: _____ PAGE _____

CORNER NO. 5174

SECTION 11

TOWN T.14 N.

RANGE R.7 E.

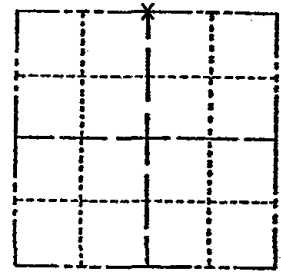

LOCATION
(Indicated by 'X')

SEAL:



BASIS FOR MONUMENT LOCATION

(Use reverse side if necessary)

Show info such as: History of corner, with reference to Vol. and pg. dates, surveyor; exact description of monument replaced; if location computed, by taped or EDM traverse; landowner remarks, etc.

Found old 3-way fence corner that fit E.D.M. traverse of this section good in all directions. Accepted this as best available evidence.

- O.K. 12-9-81 SK-DW
- " 3-24-96 GR-SS
- " 8-26-97 JG-SS
- 1 NEW TIE 3-29-02 SS
- OK, 2-24-06 -JG
- OK 1-6-12 MS

CERTIFIED CORRECT:


Frederic W. Zielow

Registered Land Surveyor


DATE: Nov. 22, 1974

TIE SKETCH

(Show at least four ties)

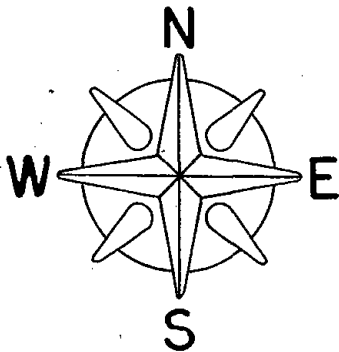

NO SCALE

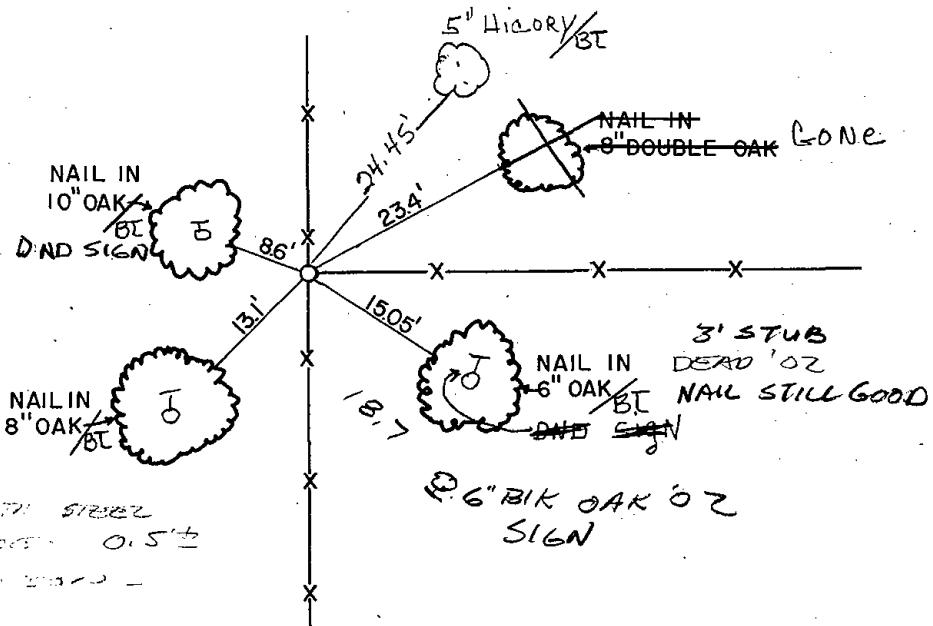

2" IRON PIPE WITH STEEL
FENCE POST INSIDE 0.5"
WEST OF PIPE END -