

16
SECTION

14
TOWN

07
RANGE

ADAMS COUNTY

COUNTY CORNER NO: 66

ROMPORTOL ID: 41407160020

PUBLIC LAND SURVEY MONUMENT RECORD

TYPE OF MONUMENT: SURVEY NAIL
ADAMS COUNTY COORDINATES, NAD 83 (2007)

N. 116756.601

E. 570457.032


ELEVATION- DATUM

FIELD WORK DATE: 04/15/2020

BASIS FOR MONUMENT LOCATION


1980 - PLS 1478 SET HARRISON MONUMENT EQUIDISTANT AND ON LINE BETWEEN ADJACENT SECTION CORNERS. DID NOT EXCAVATE DUE TO CUT AREA IN ROAD.

2020 - PLS 2675 FOUND SURVEY NAIL IN THE ROAD SURFACE, REMOVED AND FOUND NO ADDITIONAL MONUMENTS BELOW. VERIFIED THE CORNER LOCATION BY BEING ON A NEAR STRAIGHT LINE AND EQUIDISTANT BETWEEN THE SE AND SE CORNERS OF SECTION 16. ACCEPTED THE SURVEY NAIL AS THE CORNER LOCATION. SET 1 NEW TIE AND MEASURED TO 3 FOUND WISDOT ALUMINUM MONUMENTS.

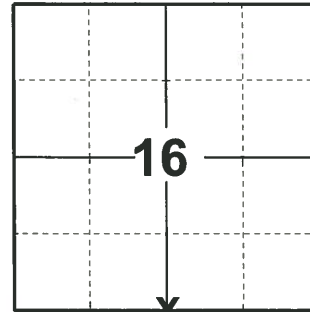

LOCATION
(INDICATE CORNER BY "X")

SEAL:

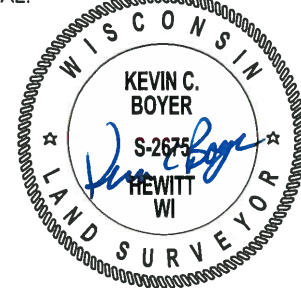


DATA SHOWN HERE ON THIS TIE SHEET IS CORRECT AND COMPLETE TO THE BEST OF MY KNOWLEDGE AND BELIEF.

PROFESSIONAL LAND SURVEYOR

DATE 5/28/2020

- TIE SKETCH

NOTE: THE CORNER LANDS 7± NORTH OF CTH 'P' CENTERLINE.

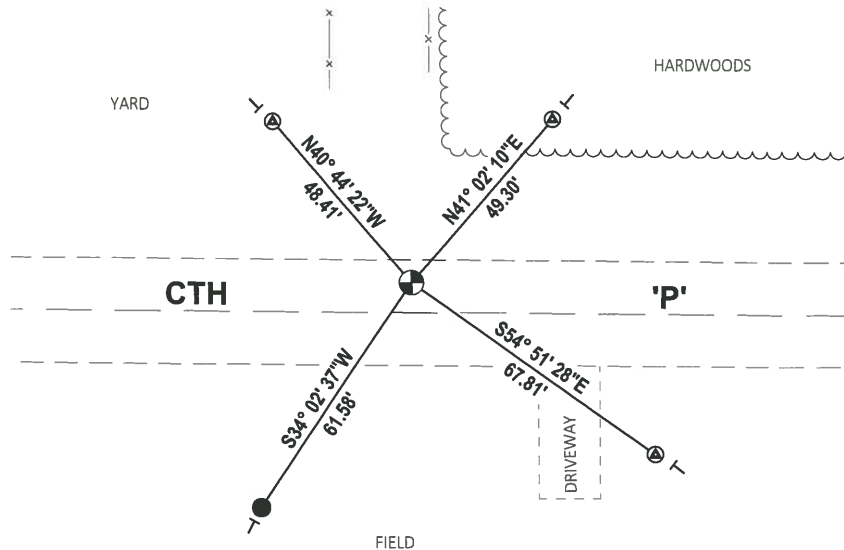

- SET 3/4" x 18" IRON REBAR, 1.50#/FT
- ⊙ FOUND WISDOT ALUMINUM CAP MONUMENT
- ⊙ FOUND SURVEY NAIL MONUMENT
- ⊖ VINYL "T" POST

Government Land Corner Certificate

ADAMS County

TYPE OF MONUMENT: HARRISON

STATE PLANE COORDINATES: N _____
E _____

ELEVATION — M.S.L. DATUM: _____

THETA ANGLE: _____

FIELD BOOK: A-F 2 PAGE 99


DRAWN BY: S. SORENSEN

CORNER NO. 666

SECTION 21

TOWN 14

RANGE 7

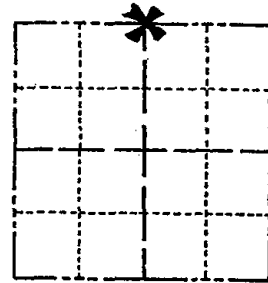

LOCATION
(Indicated by 'X')

SEAL:



DATA SHOWN HERE ON
CERTIFIED CORRECT:

Gregory P. Rhinehart
Registered Land Surveyor

DATE: 10-24-80

BASIS FOR MONUMENT LOCATION

Show info such as: History of corner, with reference to Vol. and pg., dates, surveyor; exact description of monument replaced; if location computed, by taped or EDM traverse; landowner remarks, etc. (Use reverse side if necessary)

Set monument equidistant and on line between adjacent section corners. Did not excavate due to cut area in road.

MAINTENANCE RECORD

Date	Init.	Remarks
12-10-81	SK-DW	CORNER O.K
2-19-86	GR-SS	OK
11-5-90	JG-SS	"
11/28/95	JG-SS	OK
6/11/01	JG	OK
2-7-06	JG	2-NEW TIES
2-25-11	SS	OK

TIE SKETCH

Show at least four ties, also fence lines, roads, topo, size and type of witness trees and if off road - best way to arrive at corner.

NOTE: ties are to nail and disc

