

PUBLIC LAND SURVEY MONUMENT RECORD

TYPE OF MONUMENT: HARRISON
 ADAMS COUNTY COORDINATES, NAD 83 (2007)

N. 114167.862

E. 562535.178


ELEVATION- - - - - DATUM - - - - -

FIELD WORK DATE: 04/27/2020

BASIS FOR MONUMENT LOCATION

1975 - PLS 922 SET CORNER EQUIDISTANT AND ON LINE BETWEEN NE CORNER & SE CORNER. COULD NOT FIND DAVE CLARK'S CORNER WHICH HE IDENTIFIED AS A LARGE WHITE BOULDER WITH PAINT CROSS ON IT.

2020 - PLS 2675 FOUND HARRISON FLUSH WITH THE GROUND AND DID NOT RECOVER ANY EXISTING TIES OR WITNESSES ON CURRENT TIE SHEET. THE CORNER WAS VERIFIED TO BE ON A NEAR STRAIGHT LINE AND EQUIDISTANT BETWEEN THE NE AND SE CORNERS OF SECTION 19. ACCEPTED THE HARRISON MONUMENT AS THE BEST EVIDENCE OF THE CORNER LOCATION AND MEASURED TO 4 FOUND WISDOT ALUMINUM CAP MONUMENTS.

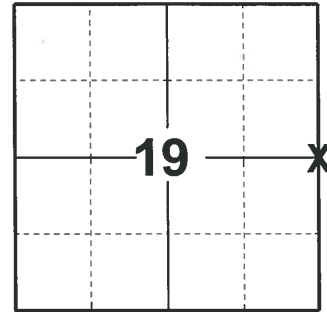

LOCATION
 (INDICATE CORNER BY "X")

SEAL:





DATA SHOWN HERE ON THIS TIE SHEET IS CORRECT AND COMPLETE TO THE BEST OF MY KNOWLEDGE AND BELIEF.

PROFESSIONAL LAND SURVEYOR

DATE 5/28/2020

- TIE SKETCH

NOTE: THE CORNER LANDS 46'± SOUTH OF CTH 'J' CENTERLINE.

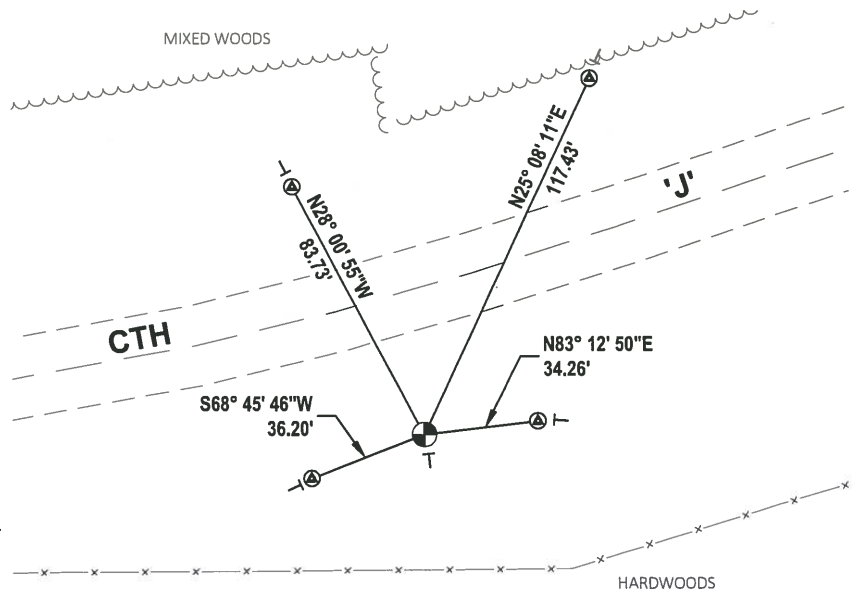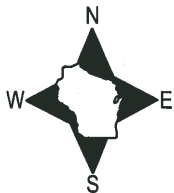

- ⊙ FOUND WISDOT ALUMINUM CAP MONUMENT
- ⊙ FOUND HARRISON MONUMENT
- VINYL "T" POST

ADAMS COUNTY

Survey Monument Record

TYPE OF MONUMENT: 30" HARRISON


STATE PLANE COORDINATES: N _____ E _____

ELEVATION — M.S.L. DATUM: _____

THETA ANGLE: _____

FIELD BOOK: _____ PAGE _____

CORNER NO. 758
SECTION 19
TOWN 14 N
RANGE 7 E

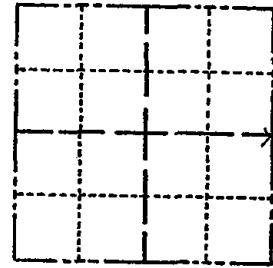


LOCATION (Indicated by 'X')

SEAL:

BASIS FOR MONUMENT LOCATION

(Use reverse side if necessary)

Show info such as: History of corner, with reference to Vol. and pg, dates, surveyor; exact description of monument replaced; if location computed, by taped or EDM traverse; landowner remarks, etc.

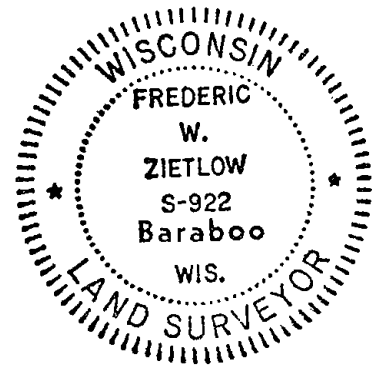

SET CORNER EQUADISTANT AND ON LINE BETWEEN NE CORNER & SE COR. COULD NOT FIND DAVE CLARK'S CORNER WHICH HE IDENTIFIED AS A LARGE WHITE BOULDER WITH PAINT CROSS ON IT.

CORNER O.K. 10-22-76 RN-SS

SEE SH-MC 12-19-00

2-GONE, 3 NEW TIES, CORNER B.K. 12-19-01 JG-SS

ALL OK, 1-18-06 -JG

2-25-11 SS

CERTIFIED CORRECT:


Frederic W. Zietlow

Registered Land Surveyor

DATE: JULY 31, 1975

TIE SKETCH

(Show at least four ties)

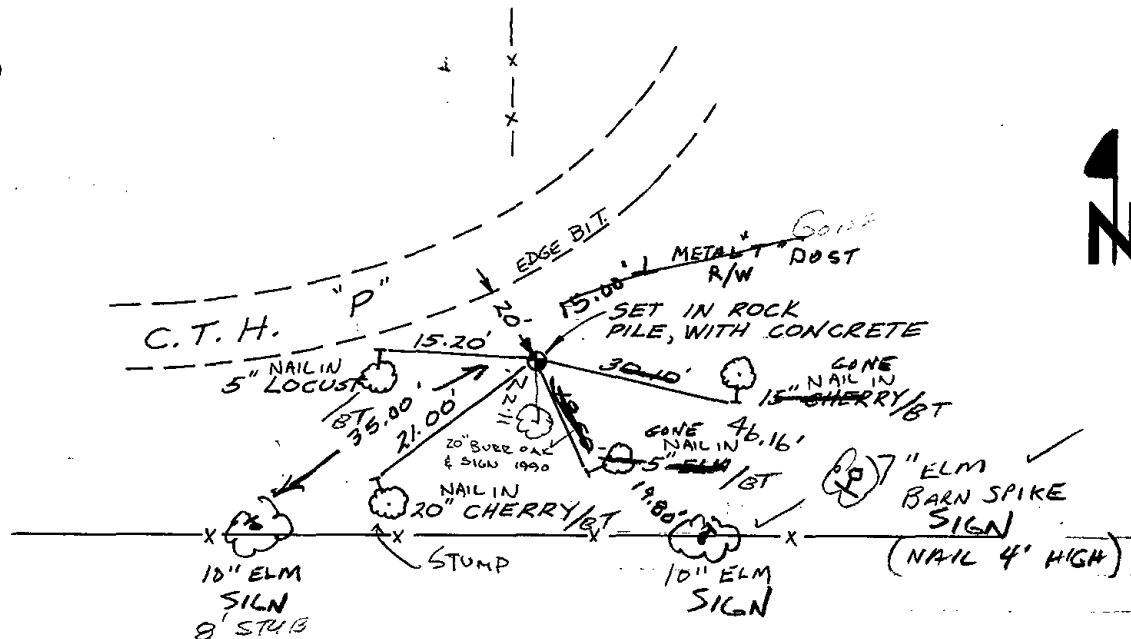


MAINTENANCE RECORD

Date	Init.	Remarks
12-11-81	SK-DW	CORNER O.K
2-12-86	GL-SS	OK
12-19-90	KZ-36	OK. 1 TIE GONE. MADE 1 NEW
4-25-96	GL-SS	OK

Survey Monument Record

CORNER NO. 758
SECTION 19
TOWN 14 N
RANGE 7E

TYPE OF MONUMENT: 30" HARRISON
STATE PLANE COORDINATES: N _____
E _____
ELEVATION — M.S.L. DATUM: _____
THETA ANGLE: _____
FIELD BOOK: _____ PAGE _____

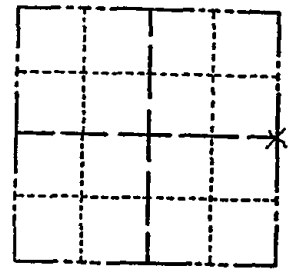

LOCATION
(Indicated by 'X')

SEAL:


BASIS FOR MONUMENT LOCATION

(Use reverse side if necessary)

Show info such as: History of corner, with reference to Vol. and pg, dates, surveyor; exact description of monument replaced; if location computed, by taped or EDM traverse; landowner remarks, etc.

SET CORNER EQUADISTANT AND ON LINE BETWEEN NE CORNER & SE COR. COULDN'T FIND DAVE CLARK'S CORNER WHICH HE IDENTIFIED AS A LARGE WHITE BOULDER WITH PAINT CROSS ON IT.

CORNER O.K. 10-22-76 PN-SS
NEW TIES 12-19-00 SH-MC

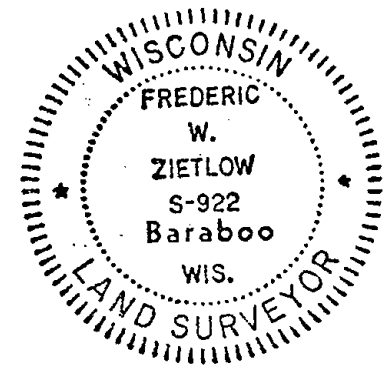

CERTIFIED CORRECT:

Frederic W. Zietlow
Registered Land Surveyor

DATE: JULY 31, 1975

TIE SKETCH

(Show at least four ties)

